

END R.O.W. PROJECT STP 0113 (58) S
 STA. 1+453.0 10.2 M (33.5') LT

US 5 CURVE #2 DATA

Radius:	349.400
Delta:	29° 11' 40"
Length:	178.033
Tangent:	90.994
Chord:	176.113
Middle Ordinate:	11.278
External:	11.654
Max. Bearing Rate:	0.070

- EXCAVATION OF PAVEMENT
1+420.000 RT - 1+520.000 RT
- FLUSHING BASINS
Sta 1+430.000 LT
- 150 mm UNDERDRAIN
Sta 1+395.000 LT - Sta 1+430.000 LT
- CONSTRUCT PAVED DRIVE
Sta 1+533.000 LT - Sta 1+560.000 LT
- PAVED APRON
ANCHOR FOR STEEL BEAM RAIL
Sta 1+418.000 RT
- TREATED TIMBER CURB
Sta 1+395.000 RT - Sta 1+408.000 RT
- HEAVY DUTY STEEL BEAM GUARDRAIL
Sta 1+395.000 RT - Sta 1+418.000 RT
- REMOVE EXISTING GUARDRAIL
Sta 1+422.000 RT - Sta 1+451.000 RT
Sta 1+423.000 RT - Sta 1+486.000 RT
- REMOVING SIGNS
Sta 1+421.000 RT
Sta 1+422.000 RT
- DURABLE 100mm WHITE LINE
Sta 1+395.000 LT - Sta 1+560.000 LT
Sta 1+395.000 RT - Sta 1+560.000 RT
- DURABLE 100mm YELLOW LINE (DOUBLE CENTERLINE)
Sta 1+395.000 - Sta 1+560.000
- TEMPORARY 100mm WHITE LINE
Sta 1+395.000 LT - Sta 1+560.000 LT
Sta 1+395.000 RT - Sta 1+560.000 RT
- TEMPORARY 100mm YELLOW LINE (DOUBLE CENTERLINE)
Sta 1+395.000 - Sta 1+560.000

SEE SHEET 46
FOR DRAINAGE DETAILS

SEE SHEET 48 FOR
SIGN SUMMARY


DATUM

VERTICAL	WADSWORTH
HORIZONTAL	NAD 83 (93)

LINES SHOWN ON THIS PLAN AS EXISTING PROPERTY LINES (P/L) ARE BELIEVED TO BE ACCURATE BUT SHOULD NOT BE RELIED UPON FOR PURPOSES UNRELATED TO THE STATE OF VERMONT'S ACQUISITION OF LAND AND RIGHTS FOR THIS PROJECT.

LEGEND

	HAY BALES
	SILT FENCE

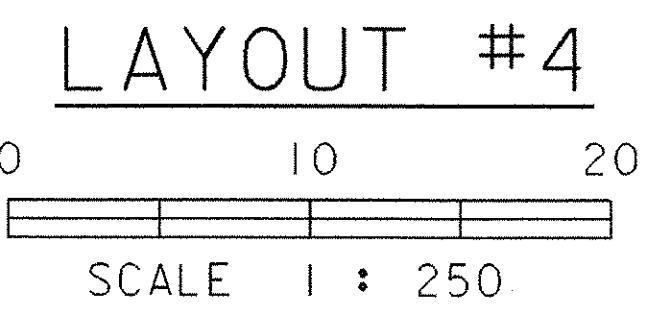

FOR R.O.W.
USE ONLY

PROJECT:	BARTON	PROJECT NO. :	STP 0113 (58) S
DESIGN FILE NAME:	96c116/structures/sc116bdr.dgn	PLOT DATE:	03-JAN-2002
IPARM FILE NAME:	sc1161a4.i	SURVEY DATE:	8/96,5/99
SURVEYED BY:	R. BULLOCK, R. GILMAN	DRAWN BY:	P.G. JARVIS
SQUAD LEADER:	C.P. WILLIAMS	R.O.W. SHEET 15 OF 16 SHEETS	87 OF 120