


WELL

N/F WOODBRIDGE, ARLENE

GARAGE
PAVED SIDEWALK
PORCH
1 STORY HOUSE

1 STORY COTTAGE

RASPBERRY BUSH
FLAG POLE
BLUEBERRY BUSHES
RASPBERRY BUSH

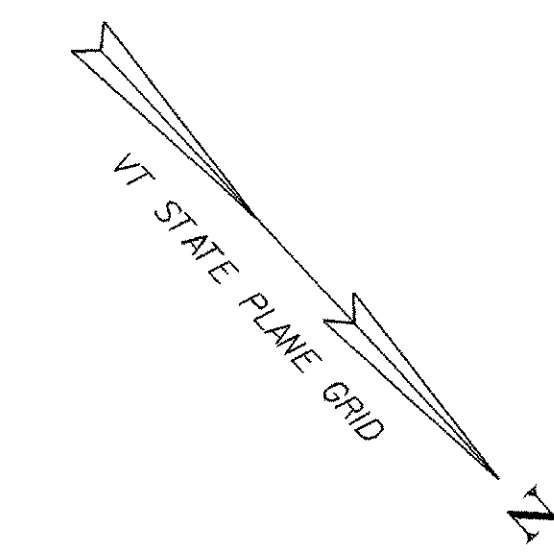


BENCHMARK #4
DISK IN LEDGE
PS4 1978 (NGS)
ELEV = 316.524

CONCRETE BOUNDARY MARKER

APPROXIMATE AERIAL RELOCATION
ROUTE BY BARTON VILLAGE, INC. AND
NEW ENGLAND TELEPHONE & TELEGRAPH CO.

SEE SHEET 46
FOR DRAINAGE DETAILS

SEE SHEET 48 FOR
SIGN SUMMARY

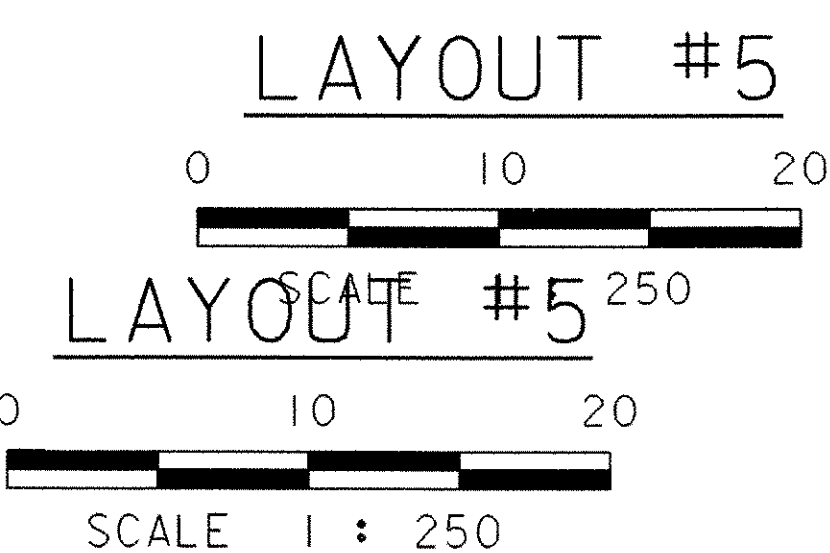

**FOR R.O.W.
USE ONLY**

LEGEND

HAY BALES

SILT FENCE

LINES SHOWN ON THIS PLAN AS EXISTING
PROPERTY LINES (P/L) ARE BELIEVED TO
BE ACCURATE BUT SHOULD NOT BE RELIED
UPON FOR PURPOSES UNRELATED TO THE
STATE OF VERMONT'S ACQUISITION OF LAND
AND RIGHTS FOR THIS PROJECT.

SEE SHEET 26
FOR DRAINAGE DETAILS

DATUM	
VERTICAL	ASSUMED
HORIZONTAL	NAD 83 (93)

PROJECT:	BARTON	PROJECT NO. :	STP 0113 (58) S
DESIGN FILE NAME:	96c116/structures/sc116bdr.dgn	PLOT DATE:	03-JAN-2002
IPARM FILE NAME:	sc1161a5.i	SURVEY DATE:	8/96,5/99
SURVEYED BY:	R. BULLOCK, R. GILMAN	DRAWN BY:	P.G. JARVIS
SQUAD LEADER:	C.P. WILLIAMS		
R. O. W. SHEET 16 OF 16 SHEETS		88 OF 120	