

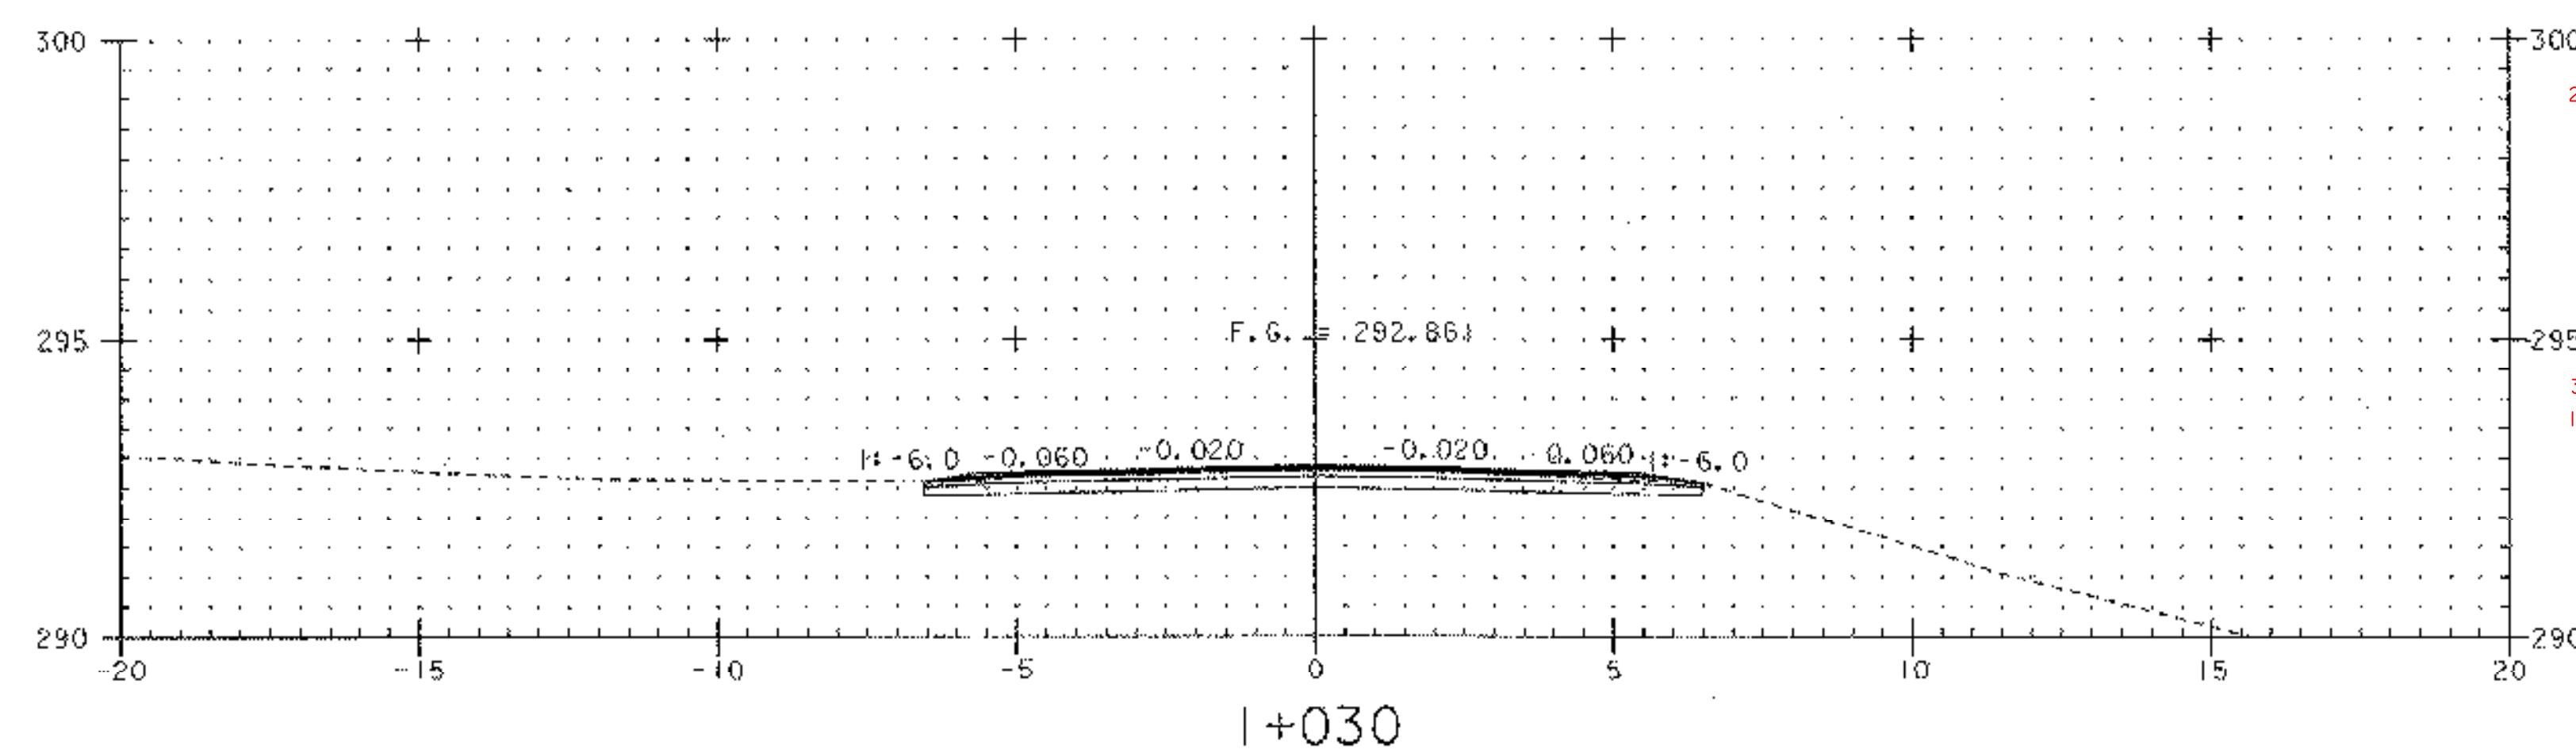
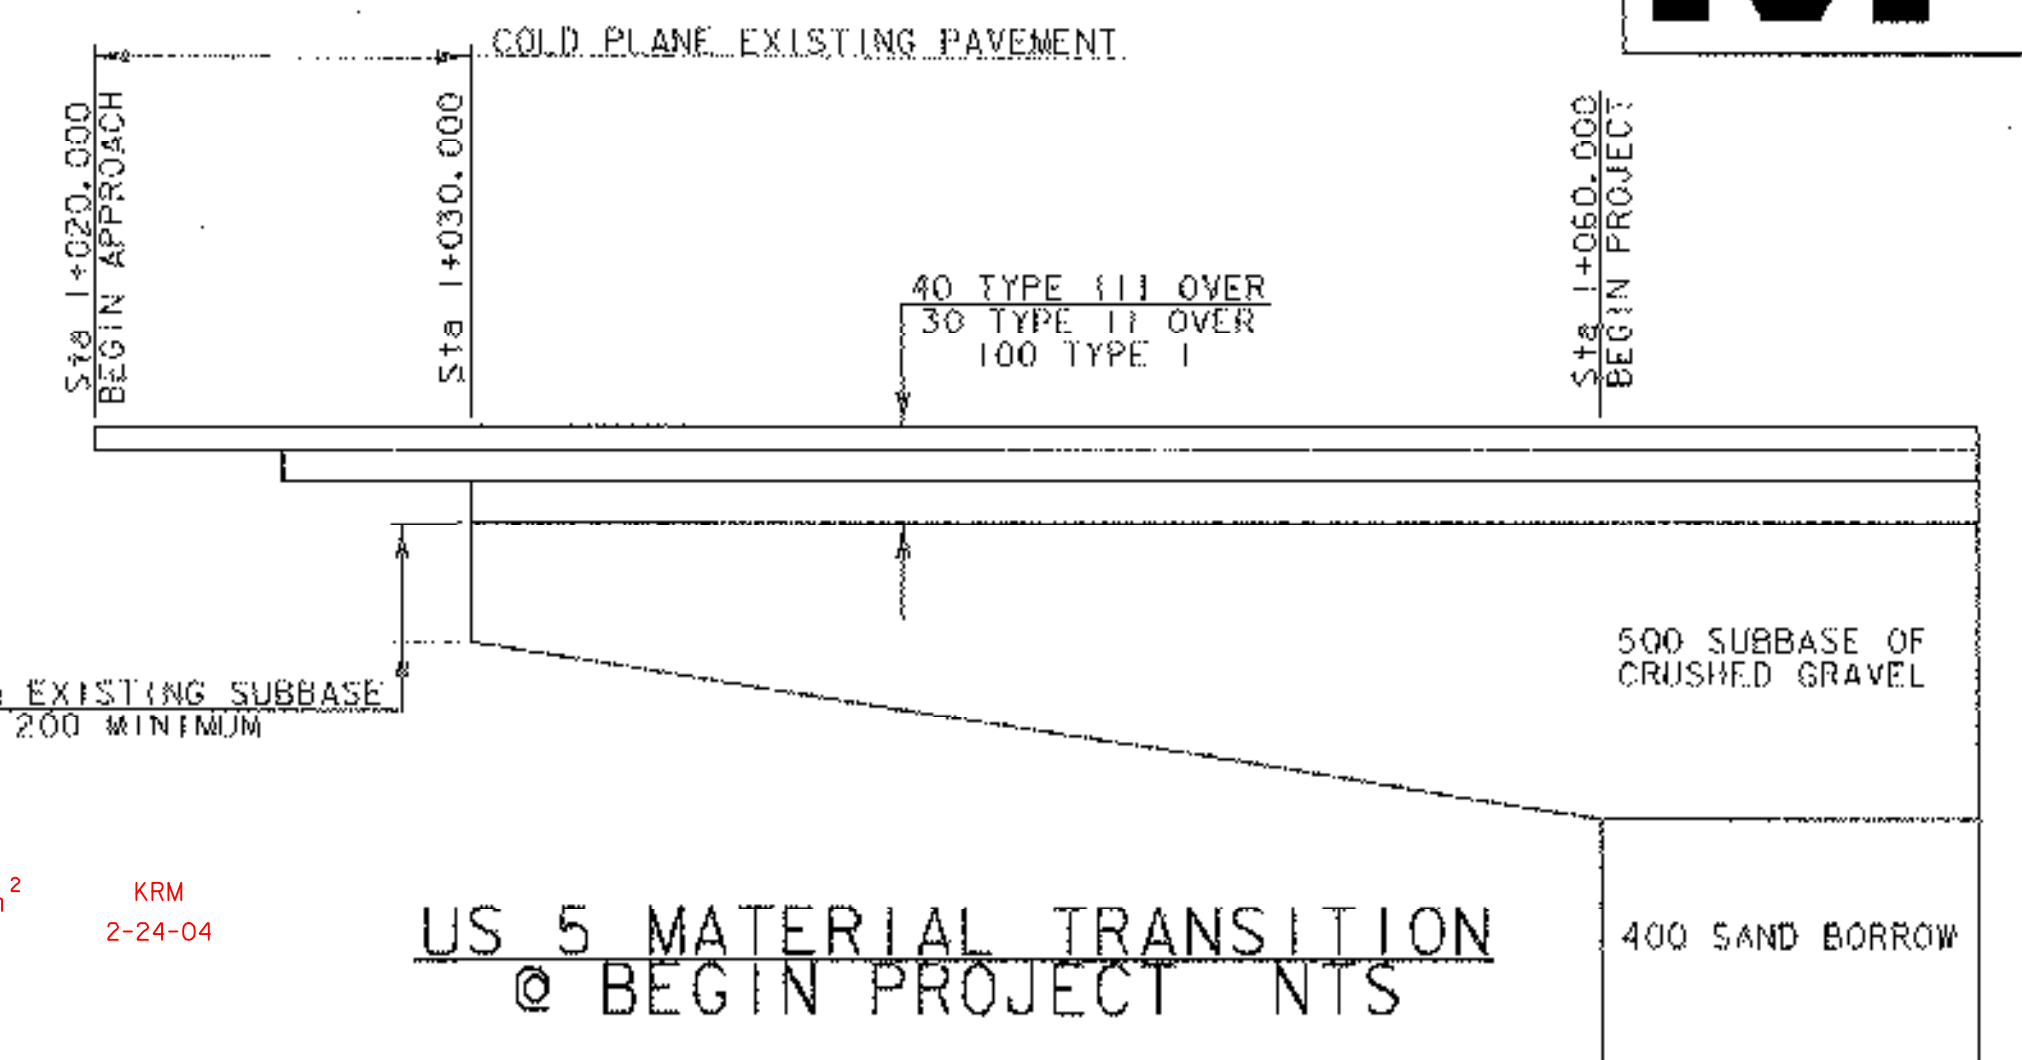
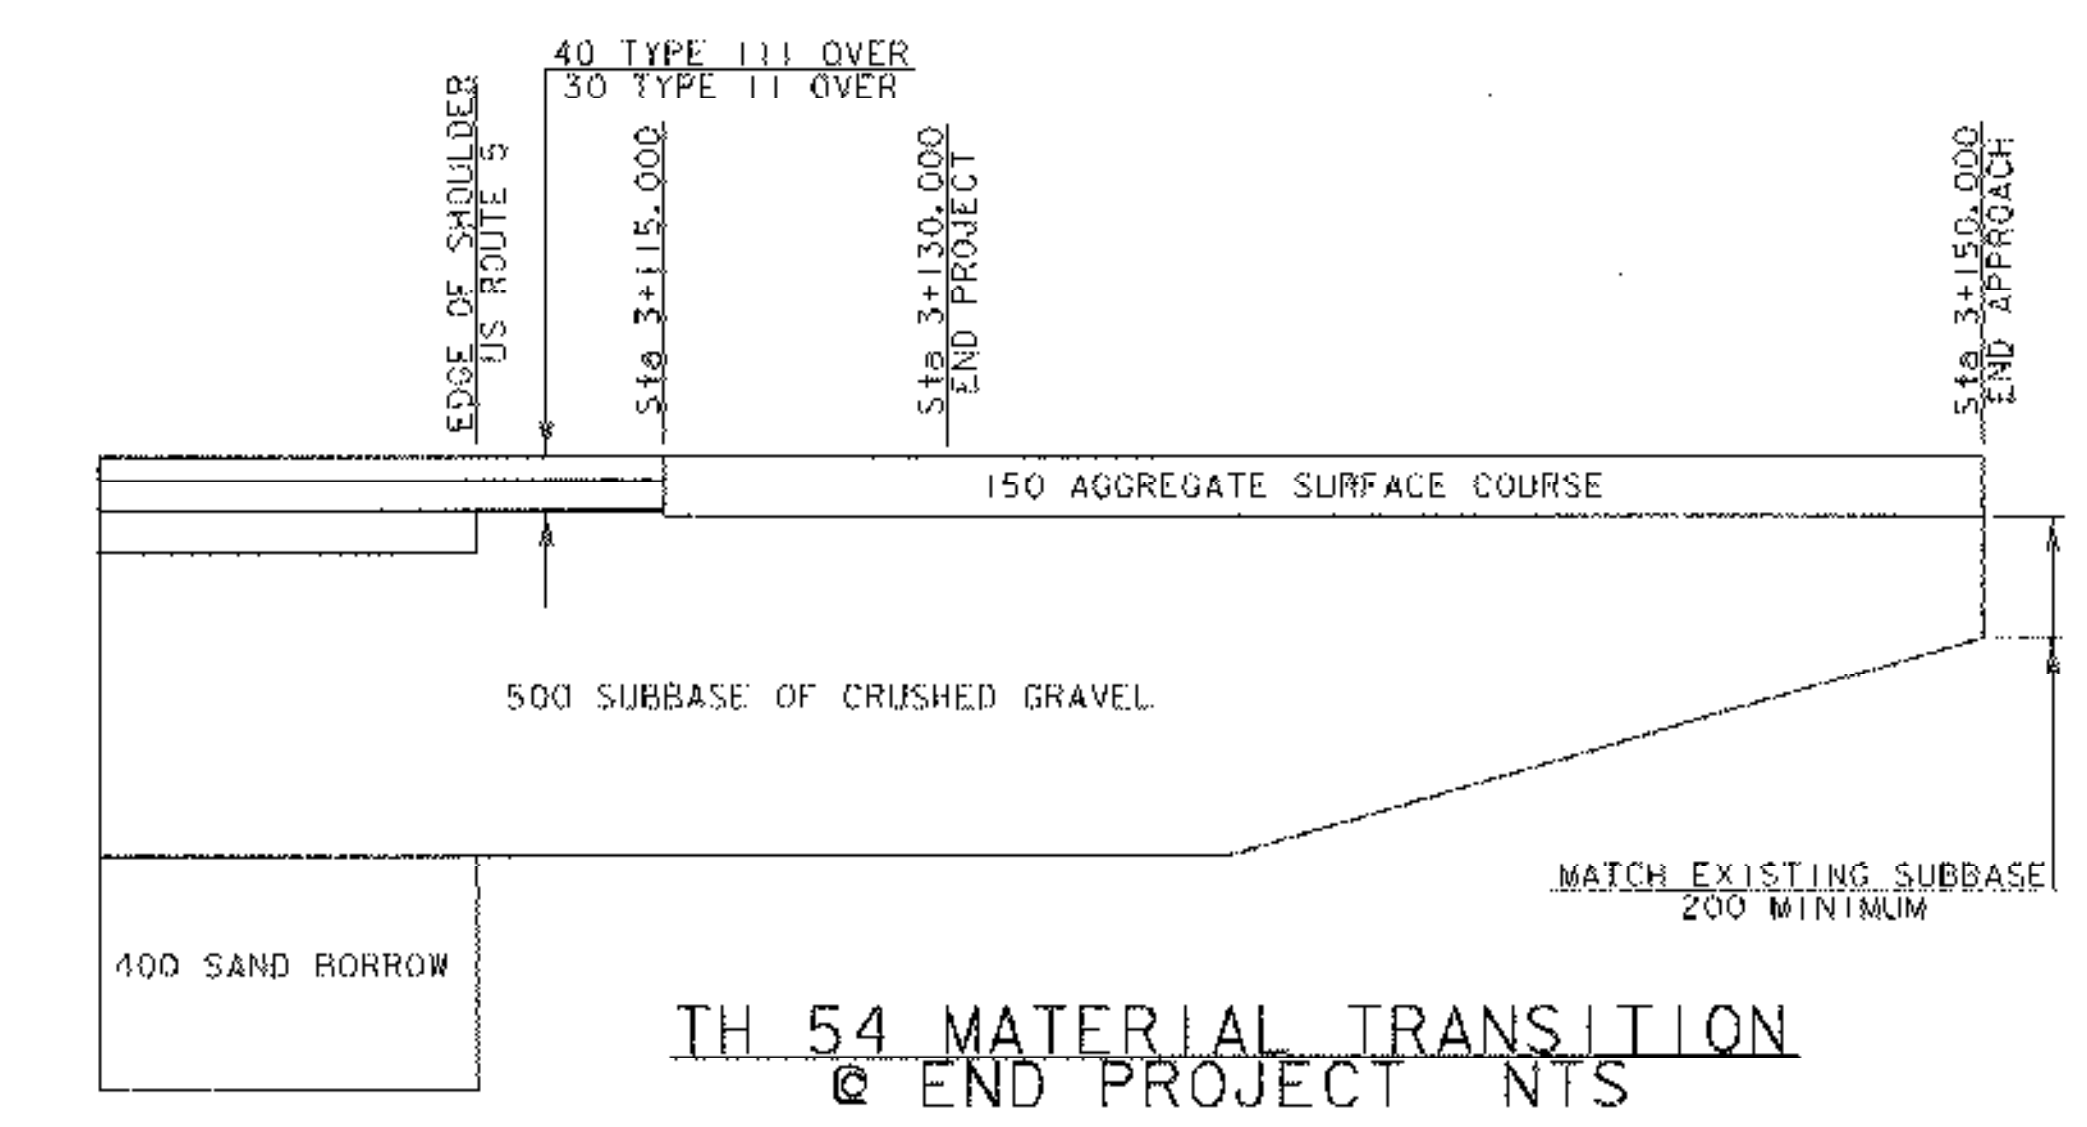



230.15  
4.7 4.7  
9.4 4.7 4.7m<sup>2</sup> KRM 2-24-04  
301.25  
3.8 3.8  
7.6 3.8 3.8m<sup>2</sup> KRM 3-8-04  
3.8 3.8  
7.6 3.8

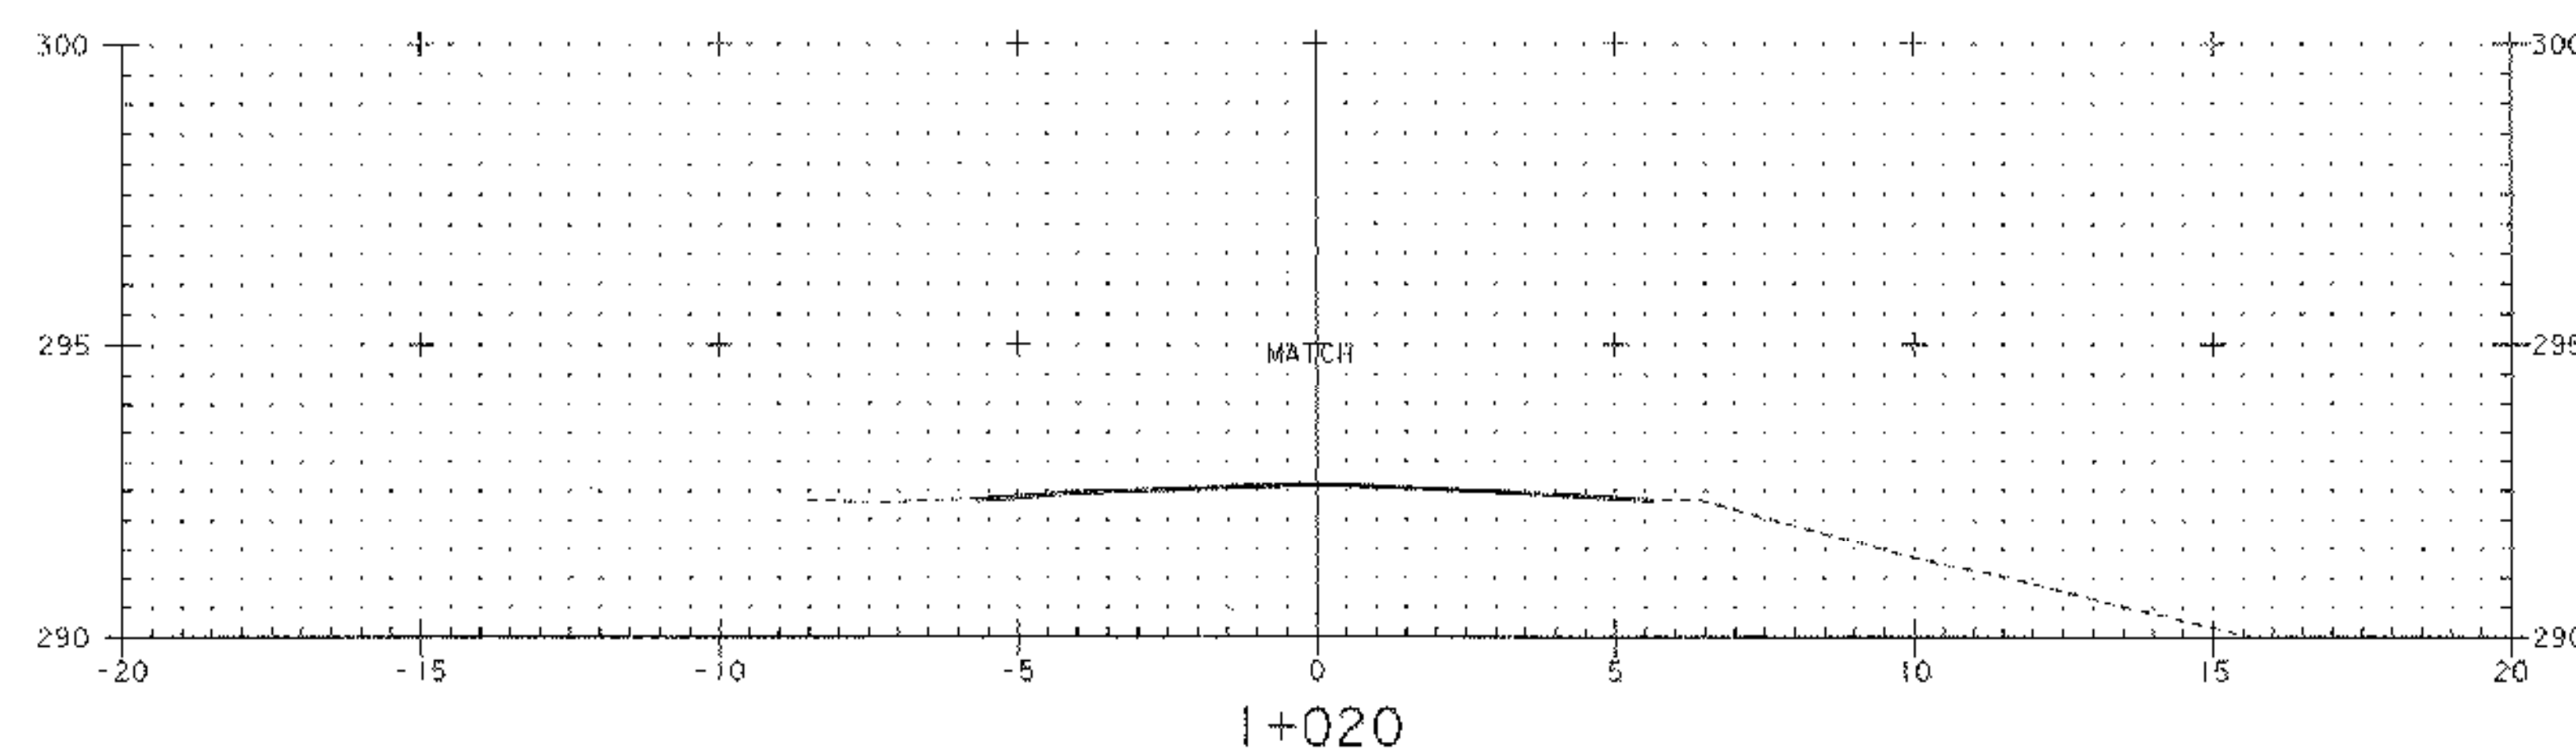

BUTT  
203.15  
3.7 3.7  
7.4 3.7 3.65m<sup>2</sup> KRM 2-24-04  
3.6 3.6  
7.2 3.6  
301.25  
13.0m x 0.2m = 2.6 m<sup>2</sup> KRM 3-8-03

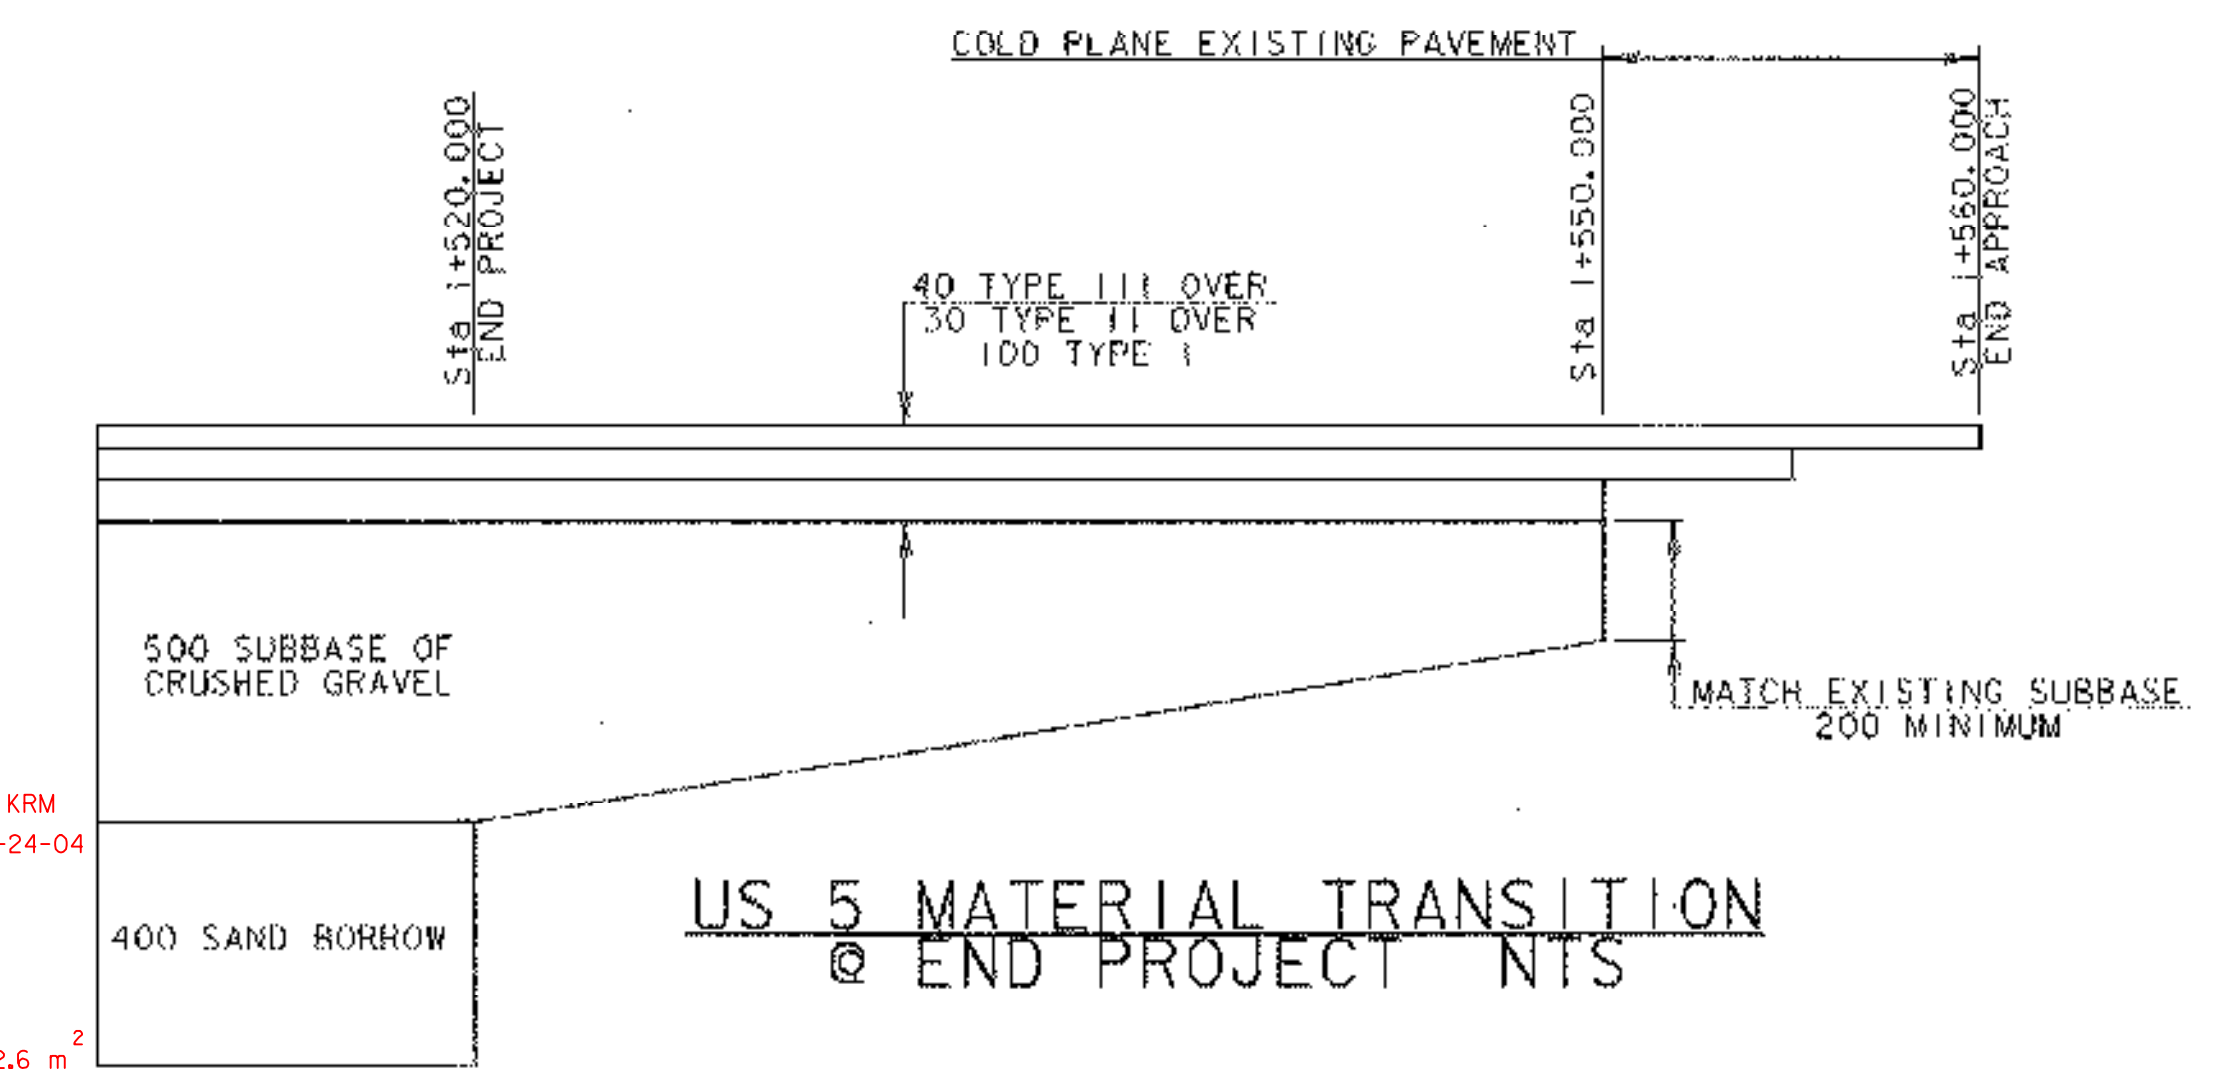

**ARCHIVED ON CADD**

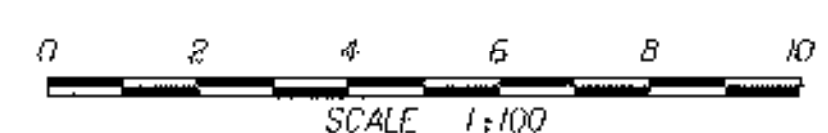

PLOTTED 03-JAN-2002

PROJECT: BARTON	PROJECT NO. 1 STP 0113 (58) S
DESIGN FILE NAME: 96c116/structures/sc116u5s.dgn	PLOT DATE: 03-JAN-2002
IPARM FILE NAME: sc116501.i	
Relocated US5 Cross Sections	
Sta 1+020 Thru 1+040	SHEET: 89 OF 120