



203.15	10.1	10.0	10.0m ²	
	20.0	10.0		
	10.0	10.0		
	20.0	10.0		
301.25	6.8	6.9	6.9m ²	BUTT BACK
	13.8	6.9		
	6.8	6.9		
	13.8	6.9		
	5.2	5.2	5.2m ²	BUTT AHEAD
	10.4	5.2		
	5.2	5.2		
	10.4	5.2		
203.31	6.4	6.4	6.4m ²	
	12.8	6.4		
	6.4	6.4		
	12.8	6.4		
				KRM 2-24-04
				KRM 3-8-04 SEE SHEET 9 OF 120

SEE DRAINAGE SHEET FOR DRAINAGE DETAILS

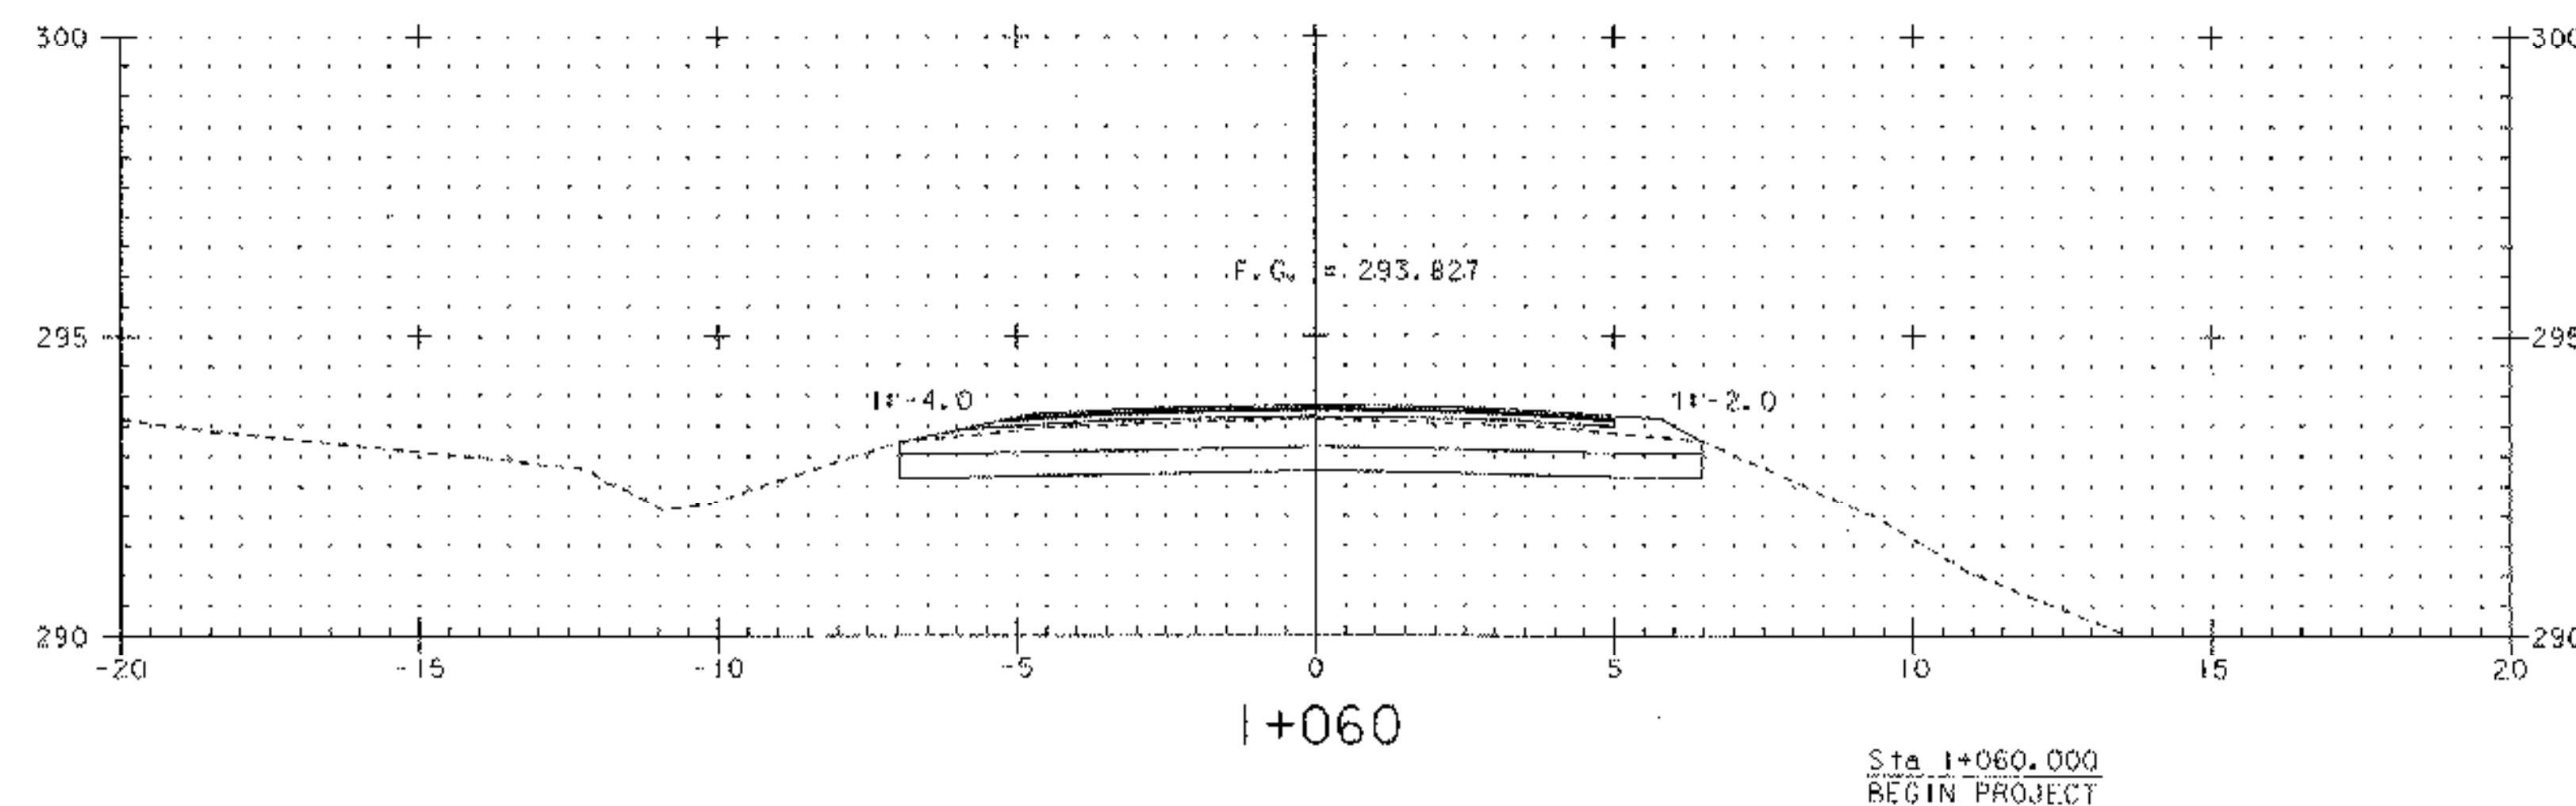


203.15	10.4	10.45	10.48m ²	
	20.9	10.5		
	10.5	10.5		
	21.0	10.5		
301.25	6.3	6.3	6.3m ²	
	12.6	6.3		
	6.3	6.3		
	12.6	6.3		
203.31	13.4m x 0.4m = 5.36m ²			KRM 2-24-04

Sta I+060.000
BEGIN PROJECT

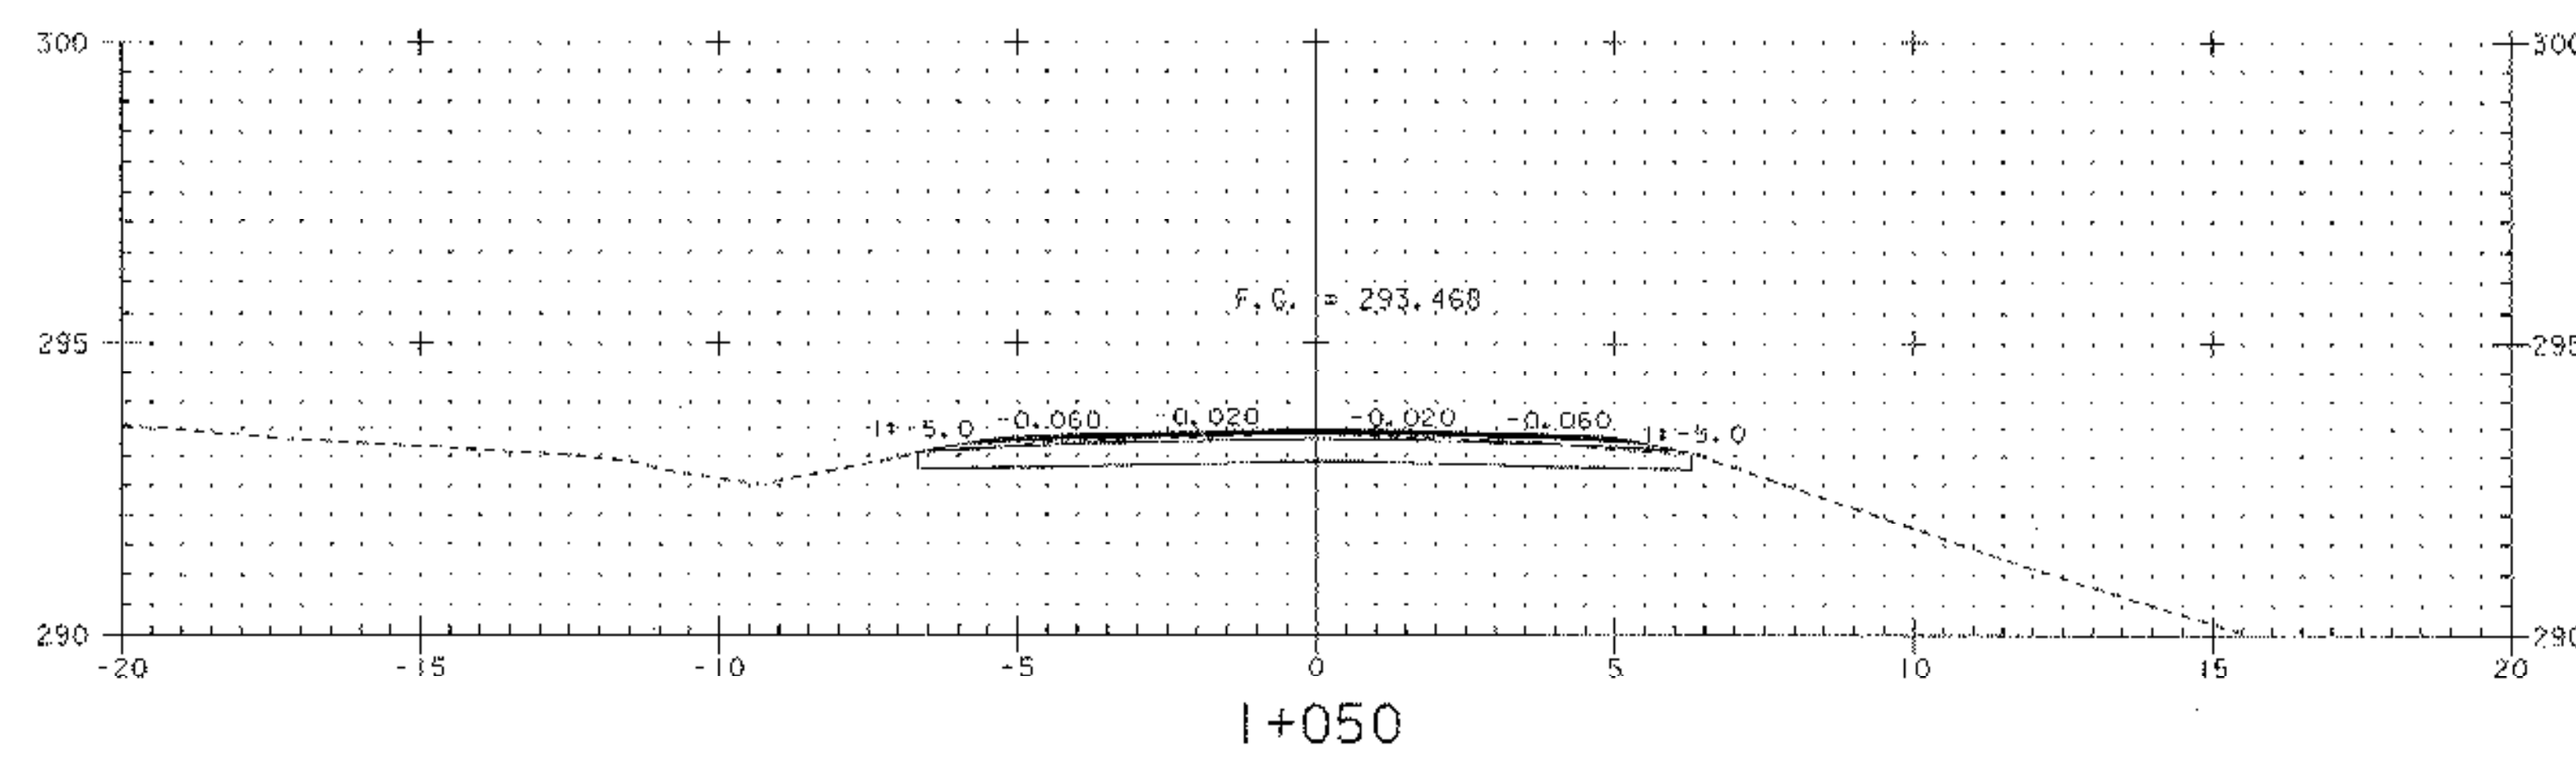

203.15	5.2	5.25	5.28m ²	
	10.5	5.3		
	5.4	5.3		
	10.6	5.3		
				KRM 2-24-04
301.15	4.5	4.5	4.5m ²	
	9.0	4.5		
	4.5	4.5		
	9.0	4.5		
				KRM 3-8-04

**ARCHIVED
ON CADD**

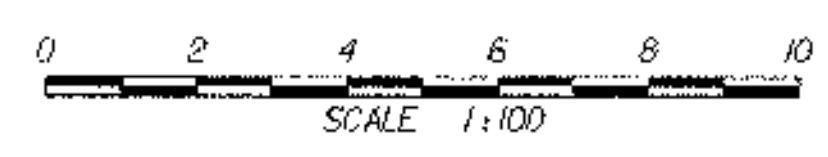

PROJECT: BARTON	PROJECT NO.: STP 0113 (58) S
DESIGN FILE NAME: 96c116/structures/sc116u5s.dgn	PLOT DATE: 03-JAN-2002
IPARM FILE NAME: sc116502.i	Relocated USS Cross Sections
Sta I+050 Thru I+070	SHEET: 90 OF 120