



203.15	9.0	9.1	9.05m <sup>2</sup>	
	18.2			
	8.9	9.0		
	18.0			
613.11	3.0	3.0	3.0m <sup>2</sup>	KRM 2-24-04
	6.0			
	3.0	3.0		
	6.0			
301.25	6.0	6.0	6.0m <sup>2</sup>	KRM 3-8-04
	12.0			
	5.9	6.0		
	12.0			

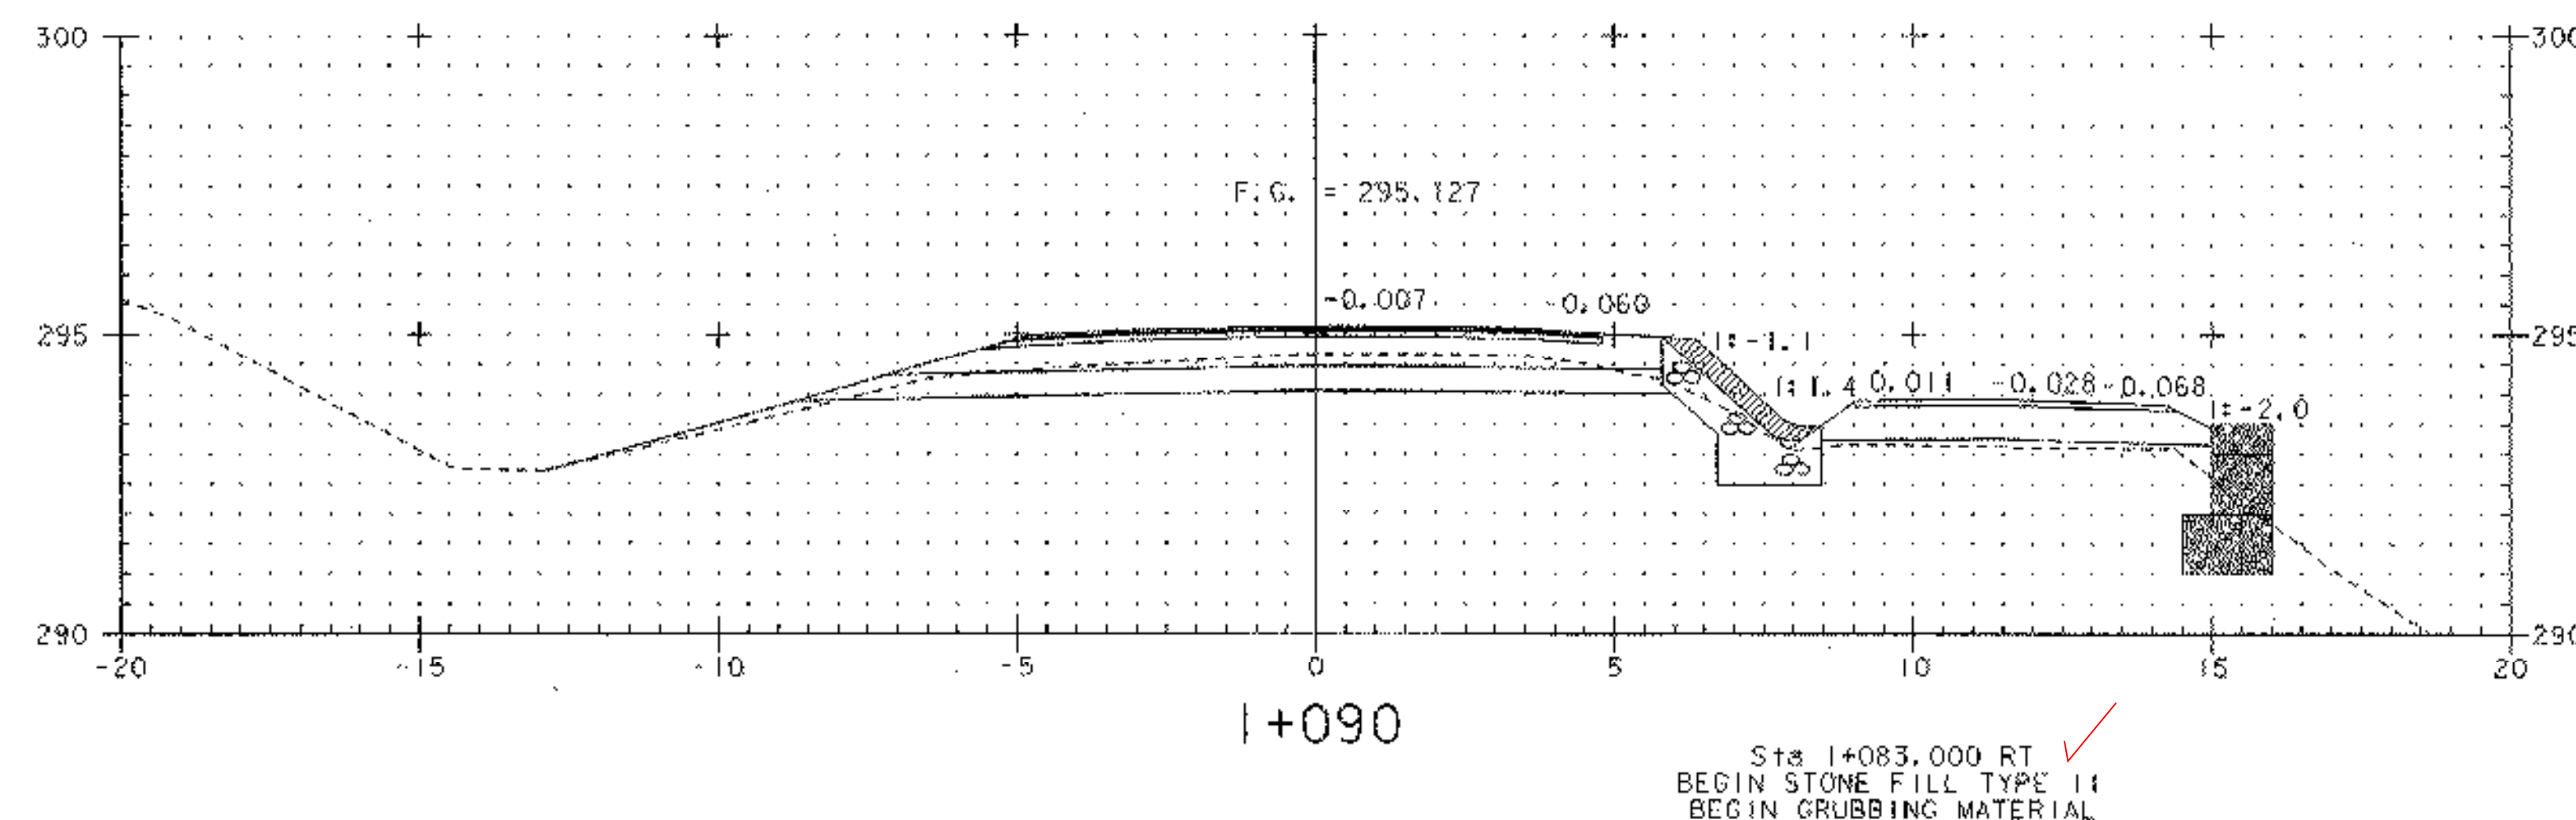

203.15	8.3	8.3	8.3m <sup>2</sup>	
	16.6			
	8.4	8.3		
	16.6			
613.11	2.5	2.5	2.5m <sup>2</sup>	KRM 2-24-04
	5.0			
	2.5	2.5		
	5.0			
301.25	6.0	5.95	6.0m <sup>2</sup>	KRM 3-8-04
	11.9			
	6.0	6.05		
	12.1			

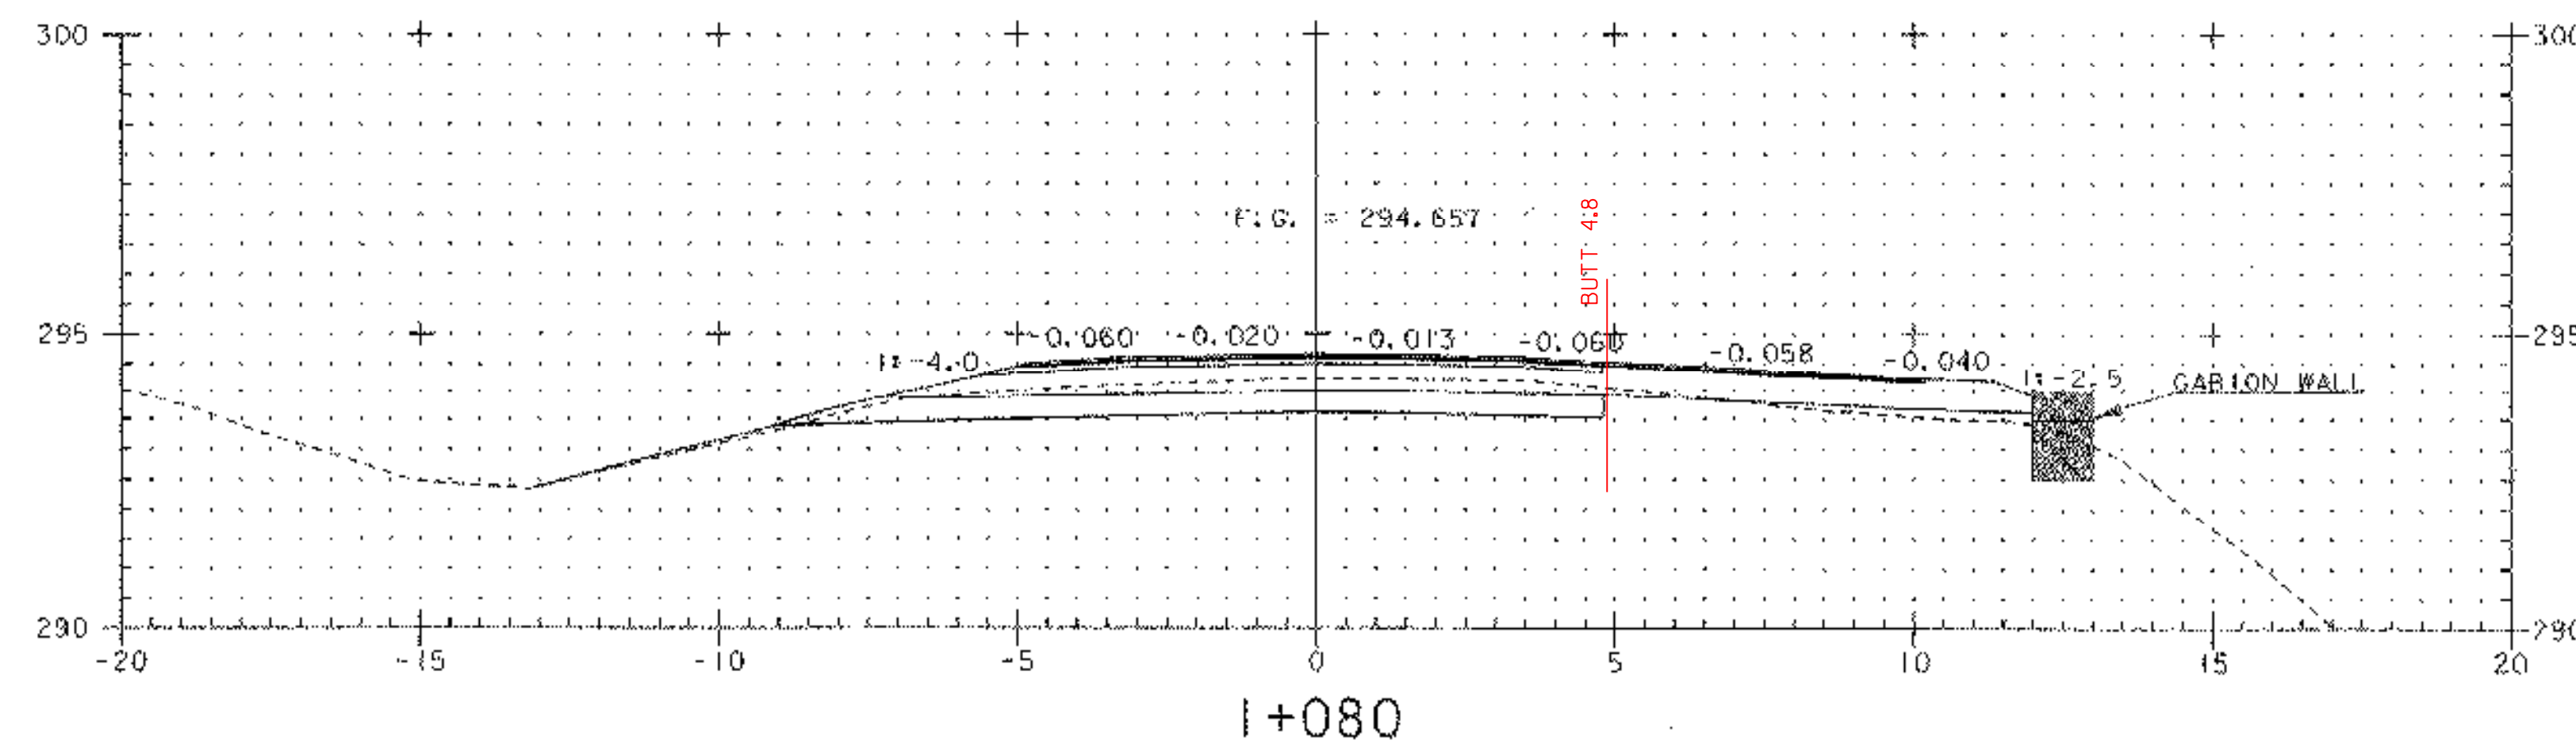

203.15	7.3	7.4	7.4m <sup>2</sup>	KRM 2-24-04
	14.8			
	7.4	7.4		
	14.8			
301.25	5.2	5.2	5.2m <sup>2</sup>	KRM 3-8-04
	10.4			
	5.2	5.2		
	10.4			

**ARCHIVED  
ON CADD**



PROJECT:	BARTON	PROJECT NO.:	STP 0113 (58) S
DESIGN FILE NAME:	96G116/structures/sc116u5s.dgn	PLOT DATE:	03-JAN-2002
IPARM FILE NAME:	sc116503.i		
Relocated US5 Cross Sections			
Sta I+080 Thru I+100		SHEET:	91 OF 120