



| | | |
|-----------|----------------------------|-----------------------------------|
| 203.15 RT | 2.4 4.8 2.4 4.8 | 2.4 2.4m ² 2.4 |
| 203.15 LT | 2.0 4.1 1.9 3.9 | 2.05 2.0m ² 1.95 |
| 203.15 | | 4.4m ² |
| 301.25 | 6.0 12.1 5.9 11.9 | 6.05 6.0m ² 5.95 |
| 613.11 RT | 8.7 17.4 8.9 17.6 | 8.7 8.75m ² 8.8 |
| 613.11 LT | 7.2 14.2 7.2 14.4 | 7.1 7.15m ² 7.2 |
| 613.11 | | 15.9m ² |

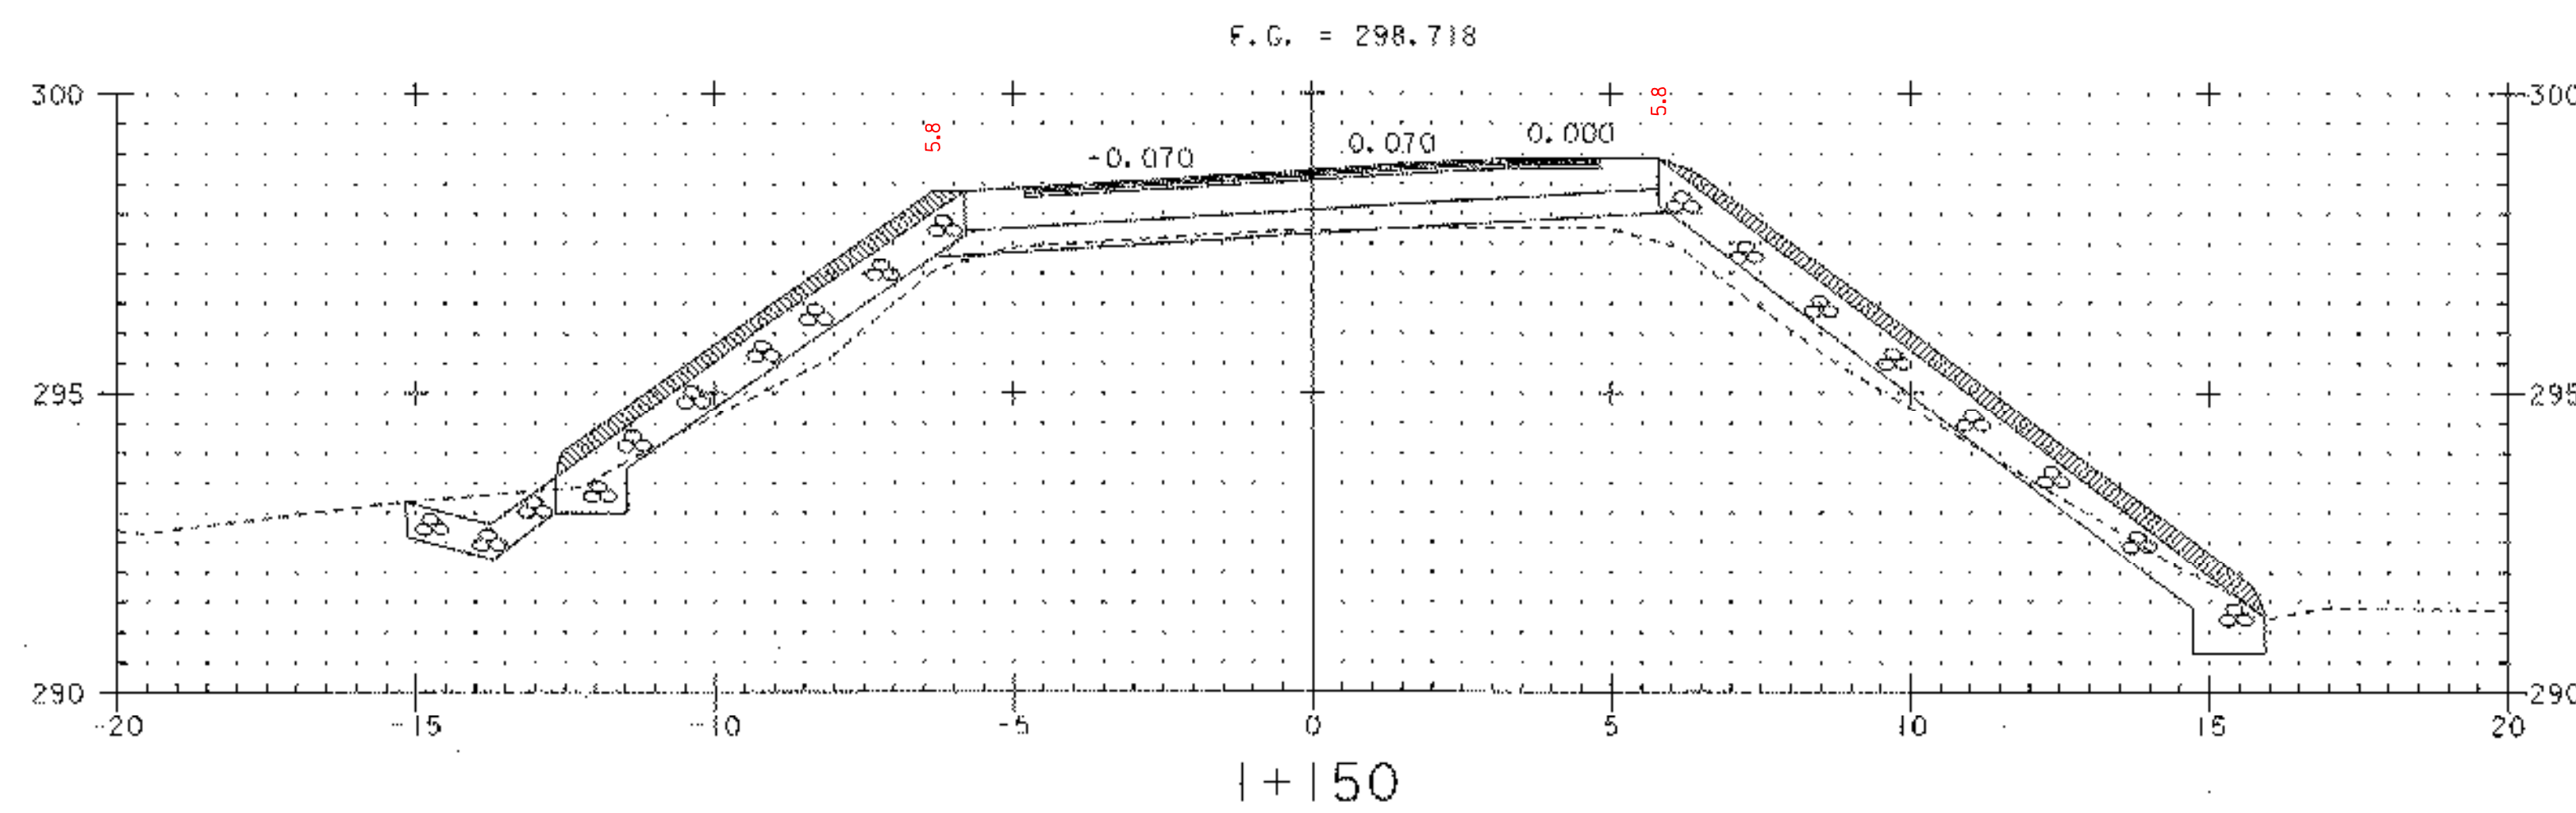

| | | |
|-----------|----------------------------|-----------------------------------|
| 203.15 RT | 2.4 4.8 2.4 4.8 | 2.4 2.4m ² 2.4 |
| 203.15 LT | 3.0 6.0 2.9 6.0 | 3.0 3.0m ² 3.0 |
| 203.15 | | 5.95m ² |
| 301.25 | 6.0 12.1 6.0 11.9 | 6.05 6.0m ² 5.95 |
| 613.11 RT | 8.2 16.4 8.1 16.4 | 8.2 8.2m ² 8.2 |
| 613.11 LT | 6.8 13.7 6.9 13.8 | 6.85 6.88m ² 6.9 |
| 613.11 | | 15.08m ² |

SEE DRAINAGE SHEET FOR DRAINAGE DETAILS

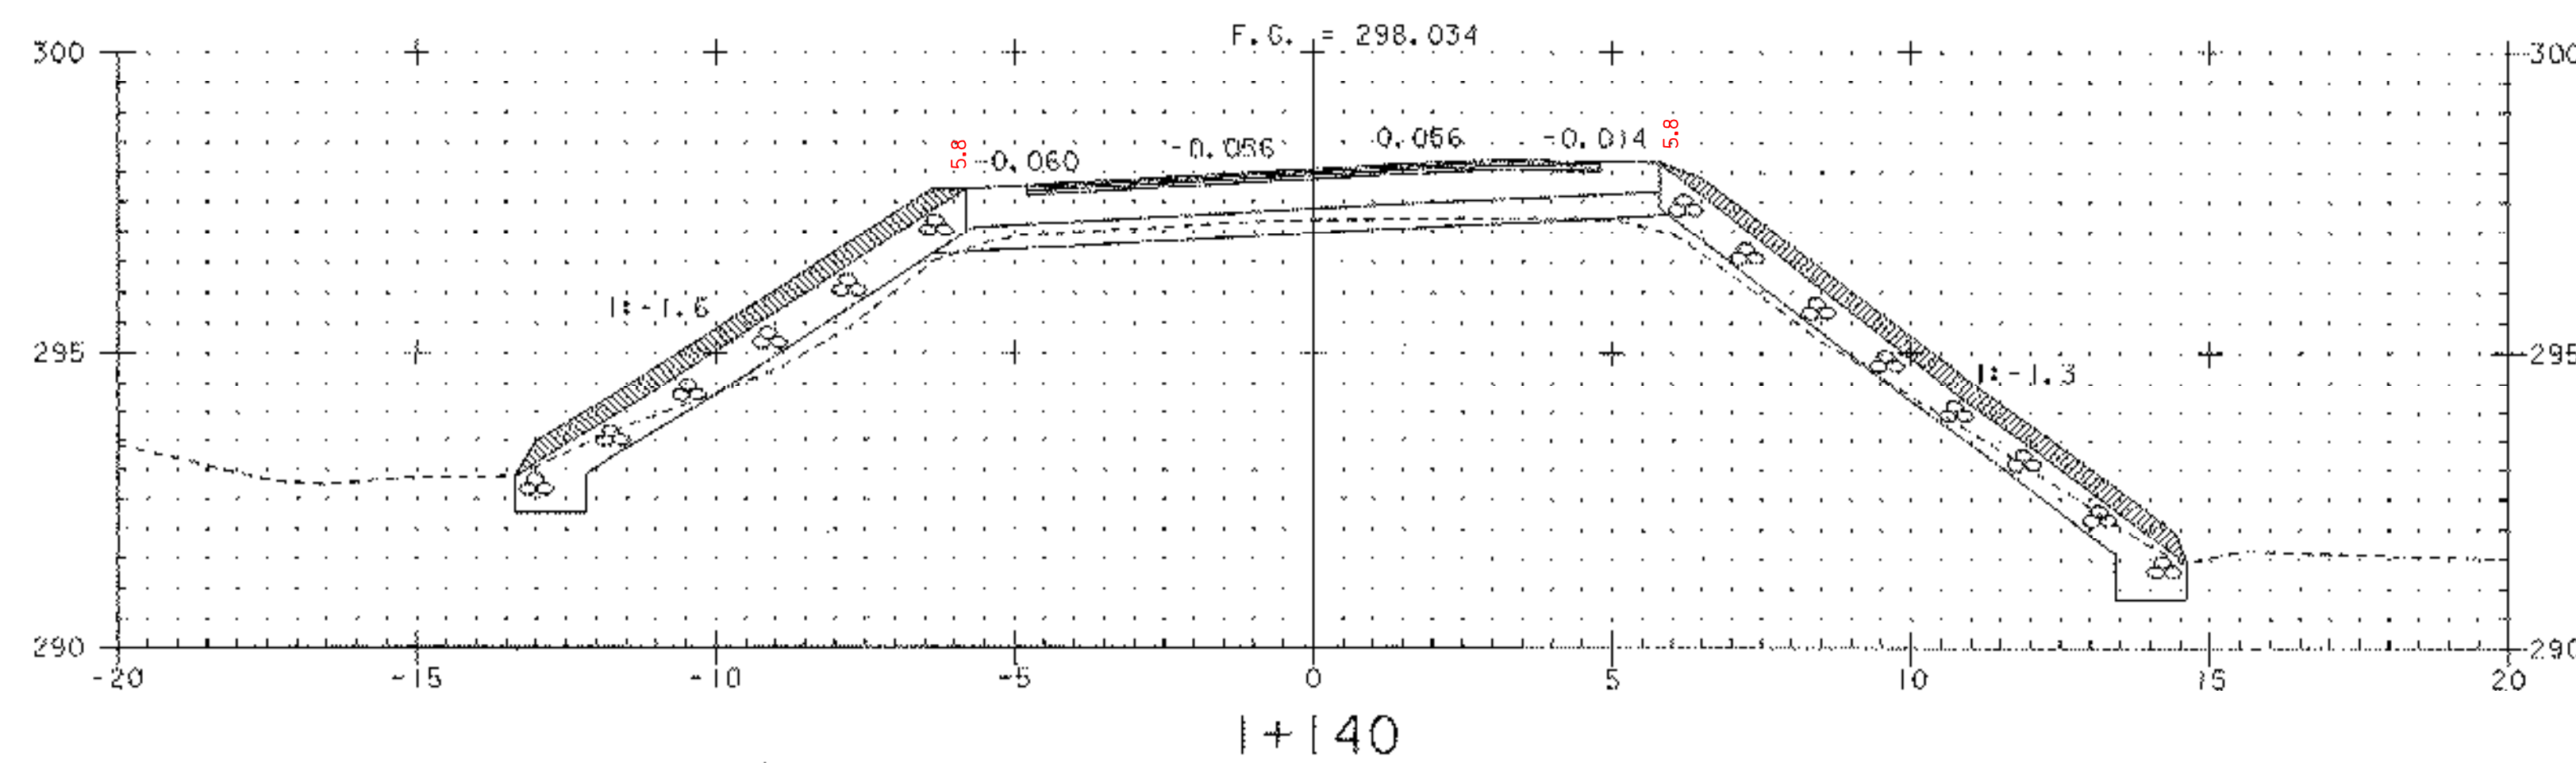

| | | |
|-----------|----------------------------|-----------------------------------|
| 203.15 RT | 5.6 11.2 5.7 11.5 | 5.6 5.68m ² 5.75 |
| 203.15 LT | 5.9 11.8 5.9 11.8 | 5.9 5.9m ² 5.9 |
| 203.15 | | 11.9m ² |
| 301.25 | 5.9 11.8 5.9 11.8 | 5.9 5.9m ² 5.9 |
| 613.11 RT | 6.6 13.3 6.8 13.5 | 6.65 6.7m ² 6.75 |
| 613.11 LT | 5.2 10.4 5.1 10.4 | 5.2 5.2m ² 5.2 |
| 613.11 | | 11.9m ² |

**ARCHIVED
ON CADD**



PLOTTED 03-JAN-2002
KRM 2-25-04

| | |
|--|------------------------------|
| PROJECT: BARTON | PROJECT NO.: STP 0113 (58) S |
| DESIGN FILE NAME: 96c116/structures/sc116u5e.dgn | PLOT DATE: 03-JAN-2002 |
| IPARM FILE NAME: sc116505.1 | Relocated US5 Cross Sections |
| Sta I+140 Thru I+160 | SHEET: 93 OF 120 |