



203.15	RT	3.3	3.3	3.3m <sup>2</sup>
		6.6		
		3.2	3.3	
		6.6		
203.15	LT	1.8	1.95	1.98m <sup>2</sup>
		3.9		
		1.9	2.0	
		4.0		
				5.28m <sup>2</sup> DHS
301.25		5.9	5.9	6.0m <sup>2</sup>
		11.8		
		6.0	6.1	
		11.2		
613.11	RT	13.4	13.5	13.43m <sup>2</sup>
		27.0		
		13.3	13.35	
		26.7		
613.11	LT	8.0	8.1	8.1m <sup>2</sup>
		16.2		
		8.1	8.1	
		16.2		

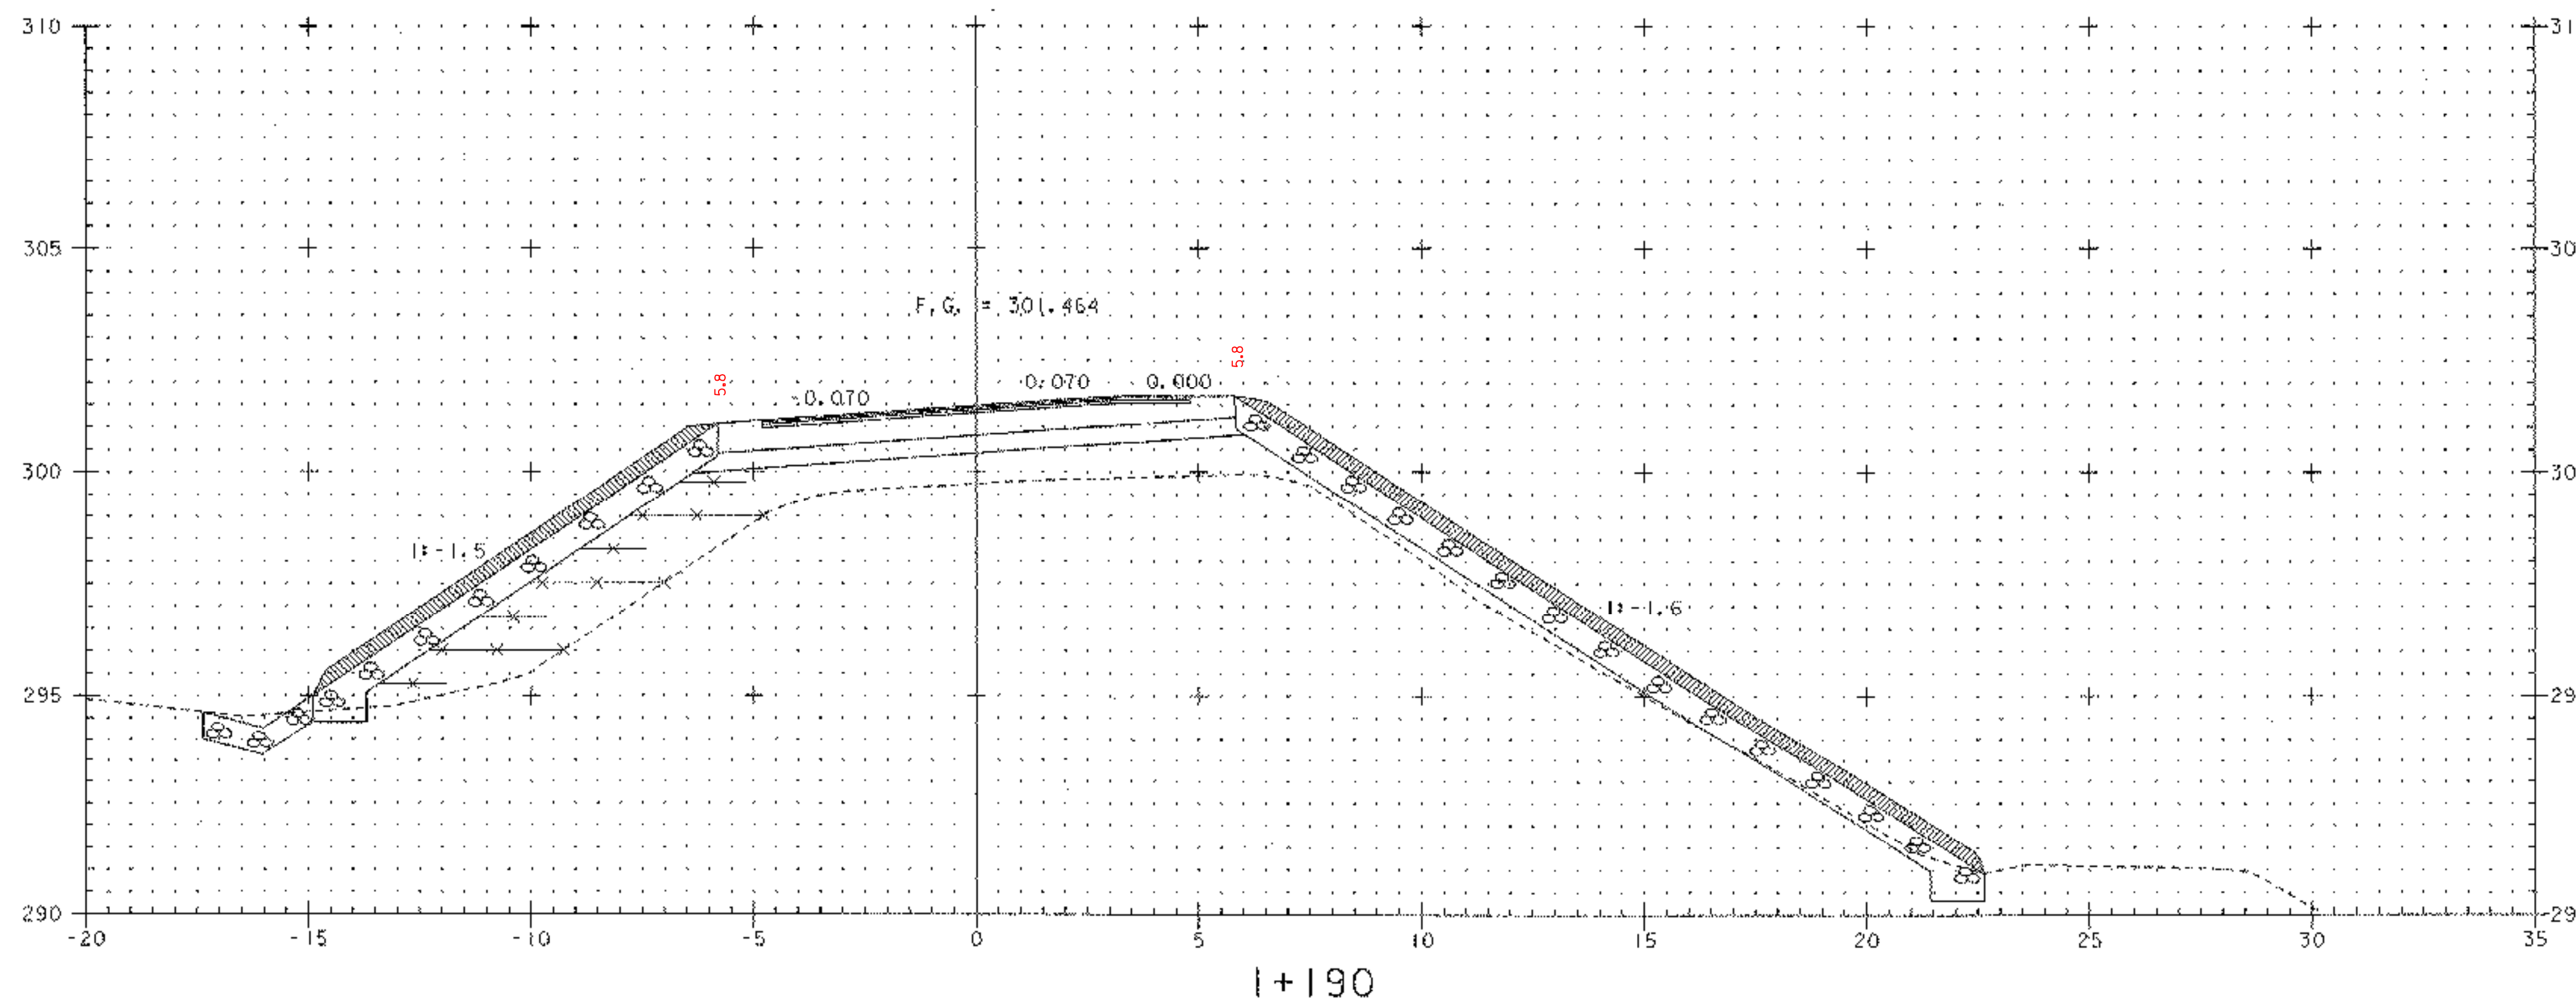

203.15	RT	1.6	1.6	1.6m <sup>2</sup>
		3.2		
		1.5	1.6	
		3.2		
203.15	LT	2.1	2.15	2.2m <sup>2</sup>
		4.3		
		2.2	2.25	
		4.3		
				3.8m <sup>2</sup>
301.25		6.0	6.0	6.0m <sup>2</sup>
		12.0		
		6.0	6.0	
		12.0		
613.11	RT	12.3	12.3	12.28m <sup>2</sup>
		24.6		
		12.2	12.25	
		24.5		
613.11	LT	8.2	8.25	8.2m <sup>2</sup>
		16.5		
		8.1	8.15	
		16.3		

ARCHIVED  
ON CADD

KRM 2-25-04

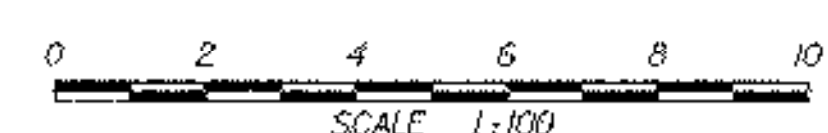

PLOTTED 03-JAN-2002

PROJECT: BARTON	PROJECT NO. 1 STP 0113 (58) S
DESIGN FILE NAME: 96c116/structures/sc116u5s.dgn	PLOT DATE: 03-JAN-2002
IPARM FILE NAME: sc116507.i	
Relocated US Cross Sections	
Sta I+190 THRU Sta I+200	SHEET: 95 OF 120