



203.15	LT	1.0	1.0	1.0m ²
		2.0		
		1.0		
		2.0		
203.15	RT	25.2	25.3	25.3m ²
		50.6		
		25.4		
		50.6		
203.15		26.3m ²		DHS
301.25		5.9	6.0	6.0m ²
		12.0		
		6.0		
		12.0		
613.11	RT	16.5	16.6	16.5m ²
		33.2		
		16.4		
		32.8		
613.11	LT	7.5	7.4	7.5m ²
		14.8		
		7.6		
		15.2		

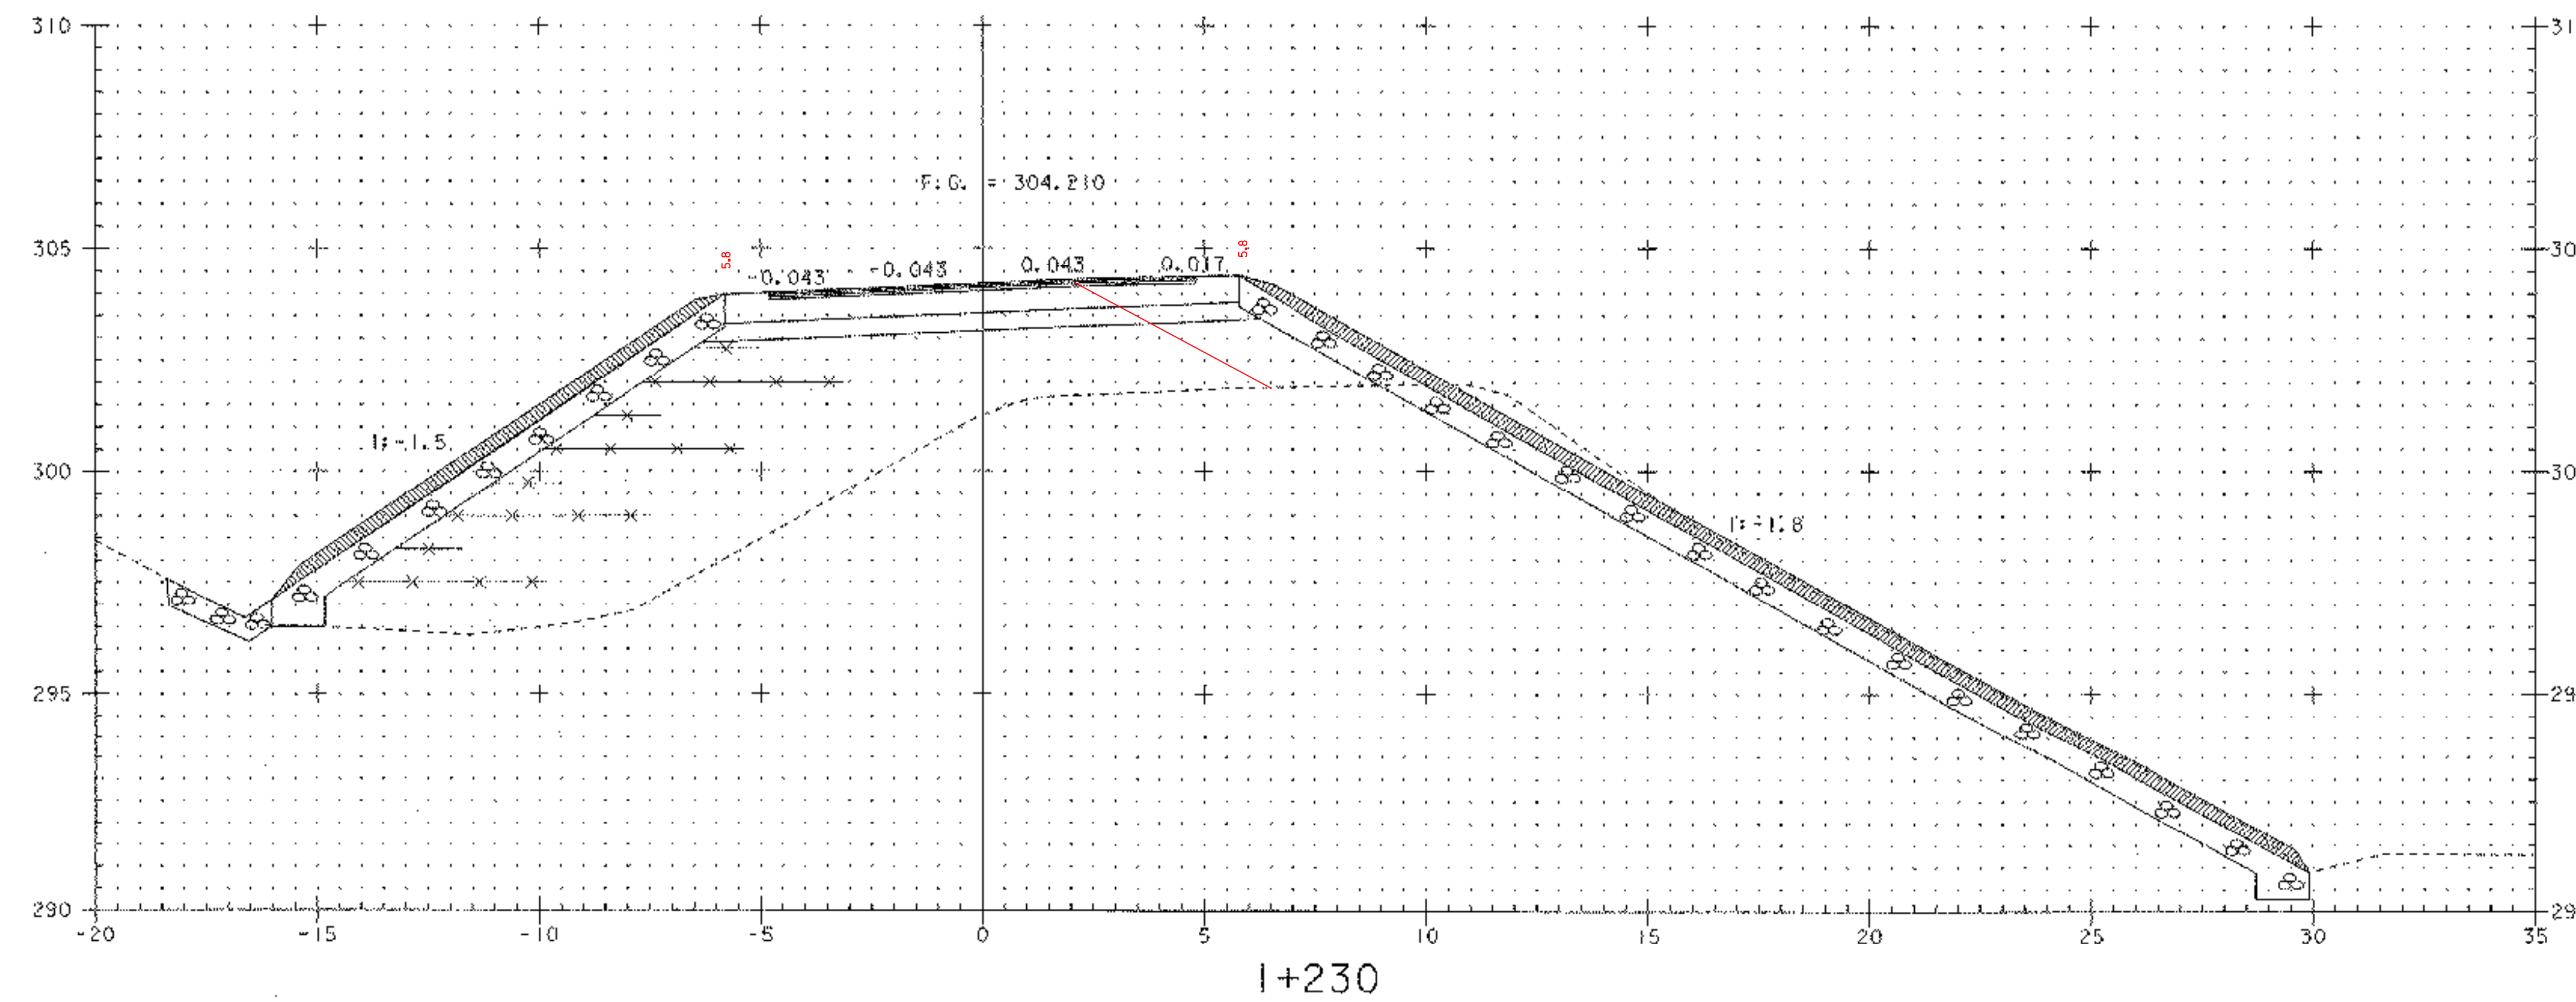

203.15	RT	20.0	20.0	20.0m ²
		40.0		
		19.8		
		40.0		
203.15	LT	1.1	1.1	1.1m ²
		2.2		
		1.1		
		2.2		
203.15		2.1m ²		DHS
301.25		6.0	6.0	6.0m ²
		12.0		
		6.1		
		12.0		
613.11	RT	15.5	15.5	15.55m ²
		31.0		
		15.5		
		31.2		
613.11	LT	8.5	8.4	8.4m ²
		16.8		
		8.4		
		16.8		

ARCHIVED
ON CADD

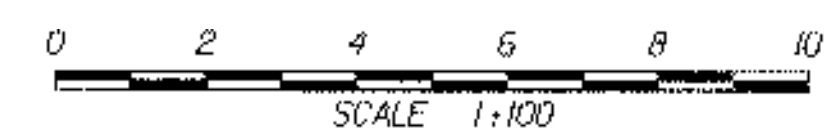

PLOTTED 03-JAN-2002

PROJECT:	BARTON	PROJECT NO.:	STP 0113 (58) S
DESIGN FILE NAME:	96c116/structures/sc116u5s.dgn	PLAT DATE:	03-JAN-2002
IPARM FILE NAME:	sc116503.i		
Relocated US5 Cross Sections		Sta I+230 THRU Sta I+240	
		SHEET: 97 OF 120	