



|        |    |      |       |                     |
|--------|----|------|-------|---------------------|
| 203.15 | RT | 33.0 | 33.2  | 33.18m <sup>2</sup> |
| 66.4   |    | 32.8 | 33.15 |                     |
| 66.3   |    |      |       |                     |
| 203.15 | LT | 7.1  | 7.0   | 7.05m <sup>2</sup>  |
| 14.0   |    | 7.2  | 7.1   |                     |
| 14.2   |    |      |       |                     |
| 203.15 |    |      |       | 40.23m <sup>2</sup> |
| 30.25  |    | 6.6  | 6.55  | 6.6m <sup>2</sup>   |
| 13.1   |    | 6.6  | 6.65  |                     |
| 13.3   |    |      |       |                     |
| 613.11 | RT | 20.2 | 20.05 | 20.13m <sup>2</sup> |
| 40.1   |    | 20.2 | 20.2  |                     |
| 40.4   |    |      |       |                     |
| 613.11 | LT | 4.2  | 4.1   | 4.15m <sup>2</sup>  |
| 8.2    |    | 4.2  | 4.2   |                     |
| 8.4    |    |      |       |                     |

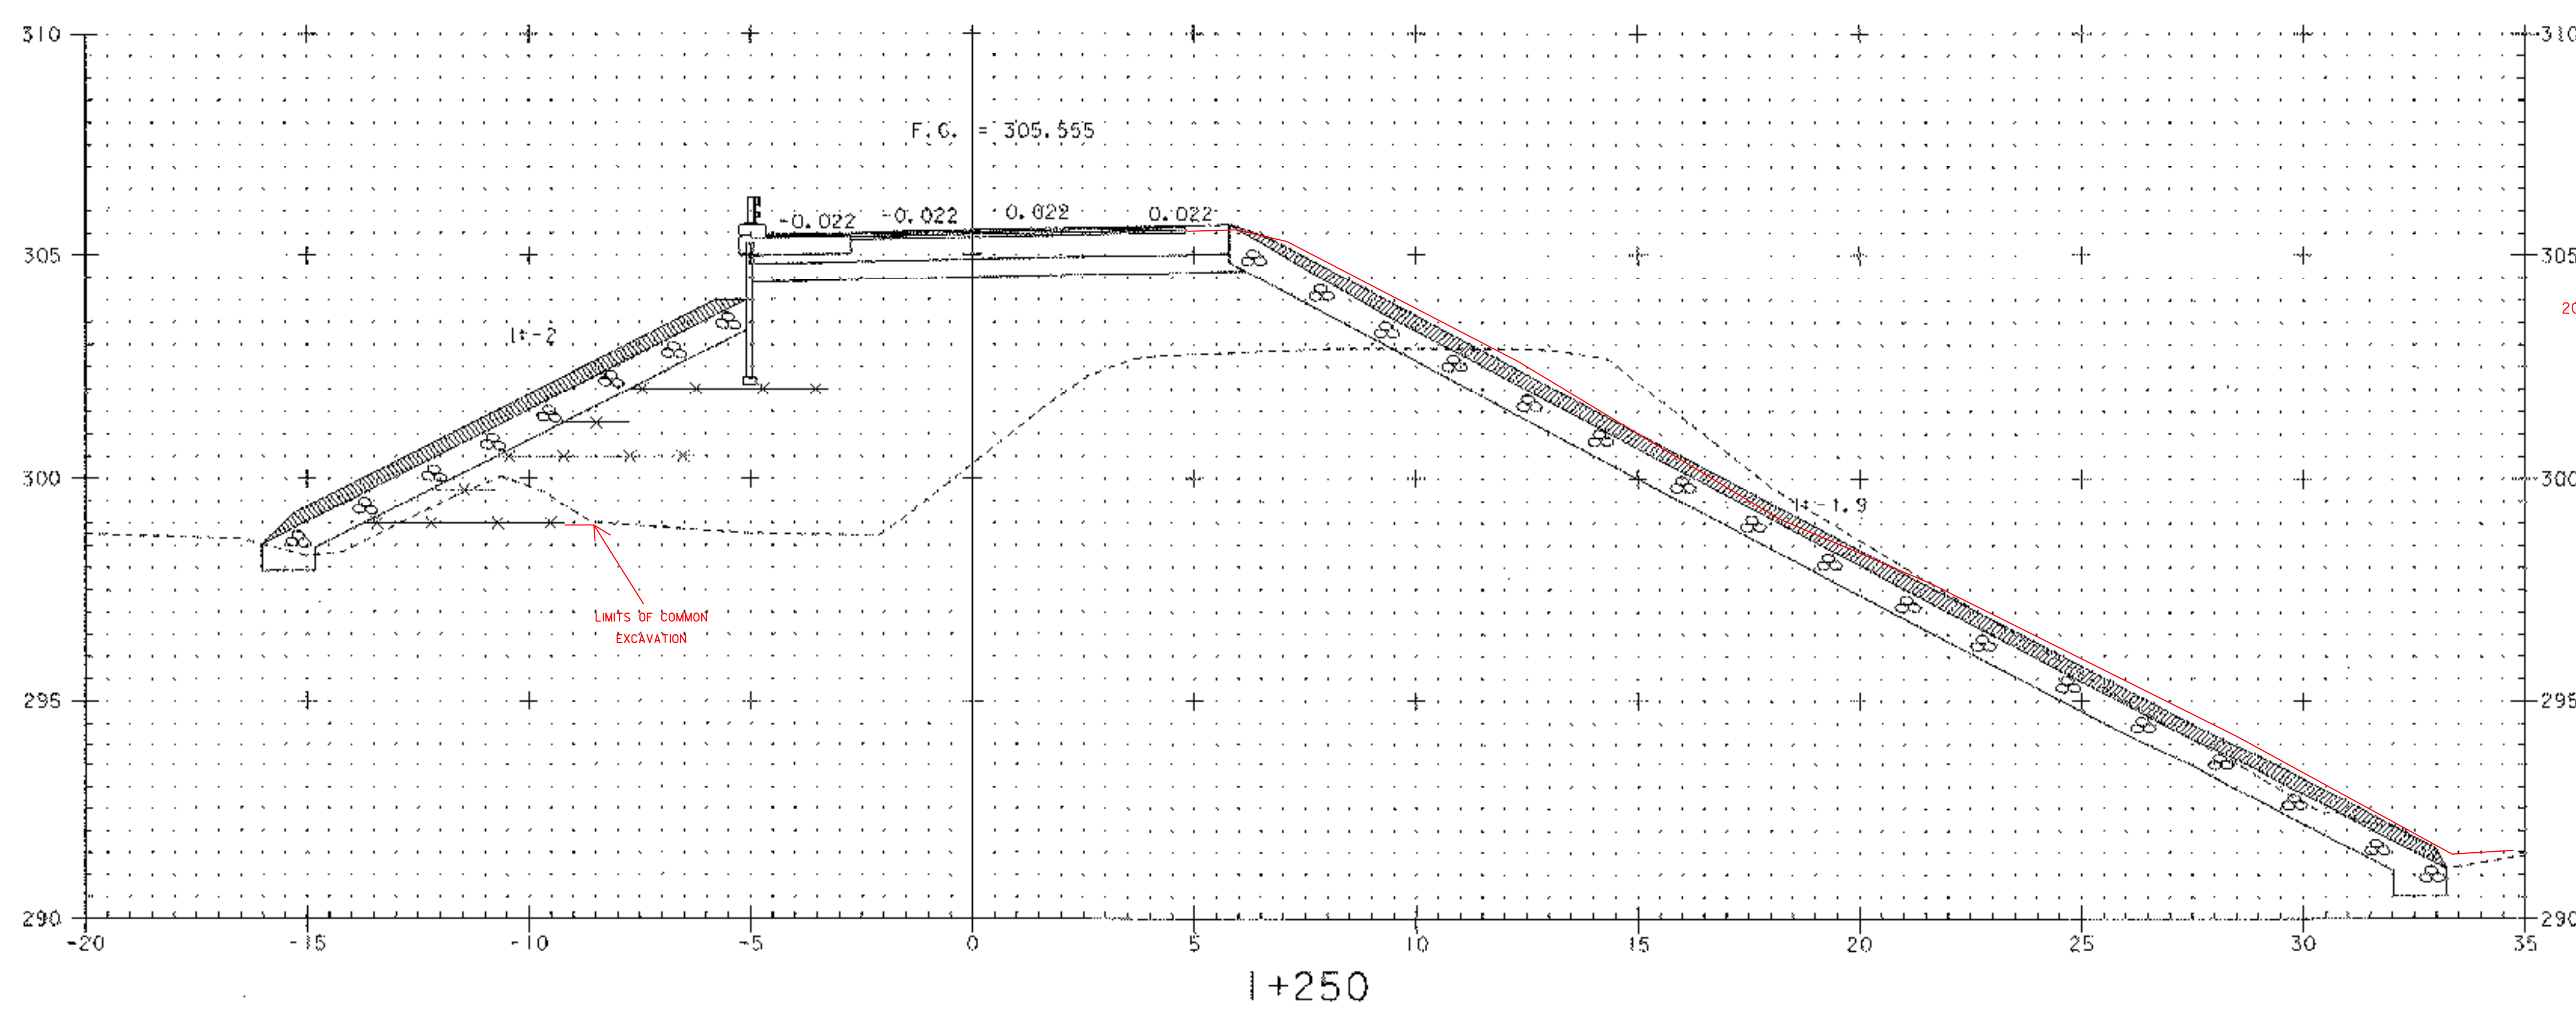

|        |    |      |      |                         |
|--------|----|------|------|-------------------------|
| 203.15 | RT | 26.1 | 26.2 | 26.25m <sup>2</sup>     |
| 52.4   |    | 26.4 | 26.3 |                         |
| 52.6   |    |      |      |                         |
| 203.15 | LT | 3.0  | 3.0  | 3.0m <sup>2</sup>       |
| 6.0    |    | 3.1  | 3.0  |                         |
| 6.0    |    |      |      |                         |
| 203.15 |    |      |      | 29.25m <sup>2</sup> DHS |
| 30.25  |    | 4.7  | 4.8  | 4.75m <sup>2</sup>      |
| 9.6    |    | 4.7  | 4.7  |                         |
| 9.4    |    |      |      |                         |
| 613.11 | RT | 19.6 | 19.5 | 19.6m <sup>2</sup>      |
| 39.0   |    | 19.8 | 19.7 |                         |
| 39.4   |    |      |      |                         |
| 613.11 | LT | 7.5  | 7.5  | 7.5m <sup>2</sup>       |
| 15.0   |    | 7.4  | 7.5  |                         |
| 15.0   |    |      |      |                         |

**ARCHIVED  
ON CADD**

SEE DRAINAGE SHEET FOR DRAINAGE DETAILS

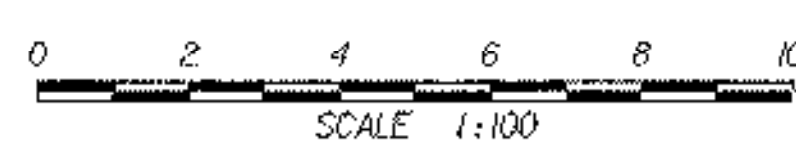

PLOTTED 03-JAN-2002

|  |                              |
|--|------------------------------|
| PROJECT: BARTON                                  | PROJECT NO.: STP 0113 (58) S |
| DESIGN FILE NAME: 96c116/structures/sc116u5s.dgn | PLOT DATE: 03-JAN-2002       |
| PARM FILE NAME: sc116510.i                       |                              |
| Relocated US5 Cross Sections                     |                              |
| Sta I+250 THRU Sta I+260                         | SHEET: 98 OF 120             |