


I+300

SEE DRAINAGE SHEET FOR DRAINAGE DETAILS

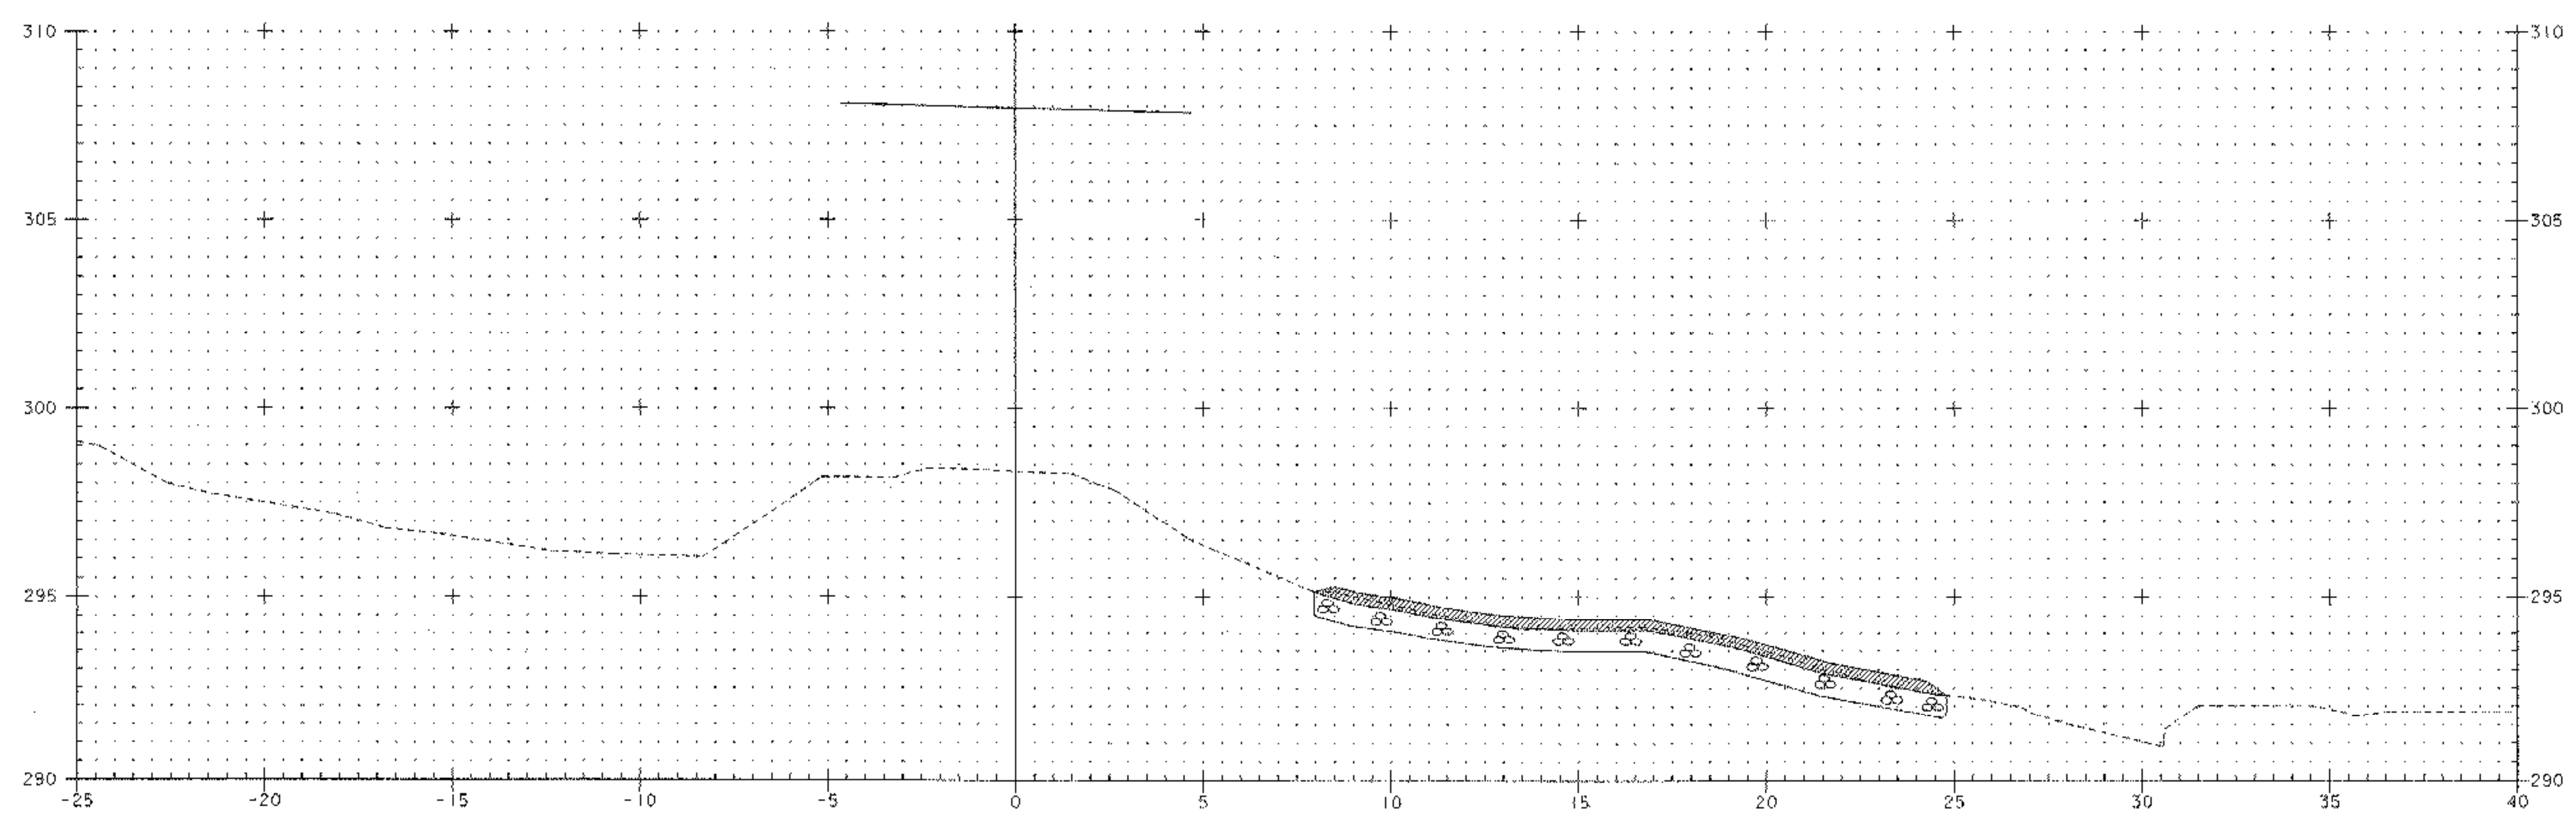

I+290

**ARCHIVED
ON CADD**



PLOTTED 03-JAN-2002

PROJECT:	BARTON	PROJECT NO.:	STP 0113 (58) S
DESIGN FILE NAME:	96c116/structures/sc116u5.dgn	PLOT DATE:	03-JAN-2002
IPARM FILE NAME:	sc116512.i	Relocated USB Cross Sections	
Sta I+290 THRU Sta I+300		SHEET: 100 OF 120	