


203.15 RT	0.7	0.7	0.7m <sup>2</sup>
	1.4	0.7	
	0.7	0.7	
	1.4	0.7	
203.15 LT	2.0	2.0	2.0m <sup>2</sup>
	4.0	2.0	
	2.0	2.0	
	4.0	2.0	
203.15	2.7m <sup>2</sup>		DHS
613.11 LT	8.8	8.85	8.88m <sup>2</sup>
	9.0	8.9	
	17.8	8.9	
613.11 RT	4.5	4.4	4.45m <sup>2</sup>
	8.8	4.5	
	4.5	4.5	
	9.0	4.5	KRM 2-26-04
301.25	5.6	5.6	5.65m <sup>2</sup>
	11.2	5.7	
	5.7	5.7	
	11.4	5.7	

**ARCHIVED  
ON CADD**

1+320  
SEE DRAINAGE SHEET FOR DRAINAGE DETAILS  
Sta 1+311.408  
END BRIDGE

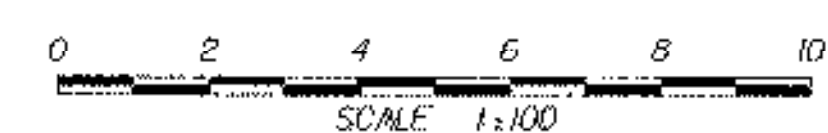

PLOTTED 03-JAN-2002

PROJECT: BARTON	PROJECT NO.: STP 0113 (58) S
DESIGN FILE NAME: 96c116/structures/sc116u5s.dgn	PLOT DATE: 03-JAN-2002
IPARM FILE NAME: sc116514.i	
Relocated US5 Cross Sections	
Sta 1+320	SHEET: 102 OF 120