


203.15	RT	1.5	1.55	1.55m ²
		3.1	1.55	
		1.6	1.55	
		3.1	1.55	
203.15	LT	0.7	0.7	0.7m ²
		1.4	0.7	
		0.7	0.7	
		1.4	0.7	
203.15		2.25m ²		DHS
613.11	RT	7.4	7.4	7.4m ²
		14.8	7.4	
		7.3	7.4	
		14.8	7.4	
613.11	LT	8.0	8.0	7.95m ²
		16.0	8.0	
		8.0	7.9	
		15.8	7.9	
301.25		4.6	4.7	4.75m ²
		9.4	4.7	
		4.7	4.8	
		9.6	4.8	
				KRM 2-26-04

**ARCHIVED
ON CADD**

1+330

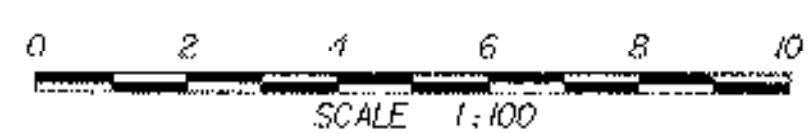

PROJECT:	BARTON	PROJECT NO.:	STP 0113 (58) S
DESIGN FILE NAME:	96c116/structures/sc116u5s.dgn	PLOT DATE:	03-JAN-2002
IPARM FILE NAME:	sc116u5s.i		
Relocated US5 Cross Sections			
Sta	1+330	SHEET:	103 OF 120

PLOTTED 03-JAN-2002