


203.15	RT	16.2	16.2	16.2m ²
		32.4	32.4	
		16.4	16.2	
		32.4	16.2	
203.15	LT	0.4	0.4	0.4m ²
		0.8	0.4	
		0.4	0.4	
		0.8		
203.15				16.6m ² DHS
301.25		4.4	4.45	4.5m ²
		8.9		
		4.5	4.55	
		9.1		
613.11	RT	13.0	13.1	13.1m ²
		26.2		
		13.2	13.1	
		26.2		
613.11	LT	4.0	4.0	4.0m ²
		8.0		
		4.0	4.0	
		8.0		

KRM 2-26-04

**ARCHIVED
ON CADD**

1+350

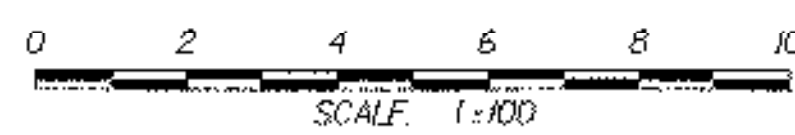

PROJECT:	BARTON	PROJECT NO. :	STP 0113 (58) S
DESIGN FILE NAME:	96c116/structures/sc116u58.dgn	PLOT DATE:	03-JAN-2002
IPARM FILE NAME:	sc116517.1		
Relocated US5 Cross Sections			
Sta 1+350		SHEET:	105 OF 120

PLOTTED 03-JAN-2002