


203.15	RT	3.3	3.3	3.3m ²
6.6		3.3		
6.6		3.3		
203.15	LT	0.4	0.4	0.4m ²
0.8		0.4		
0.4		0.4		
0.8		0.4		
203.15			3.7m ²	DHS
301.25		5.9	5.9	5.9m ²
11.8		5.9		
5.9		5.9		
11.8		5.9		
613.11	RT	15.1	15.0	15.05m ²
30.0		15.0		
15.0		15.1		
30.2		15.1		
613.11	LT	4.2	4.15	4.2m ²
8.3		4.2		
4.2		4.25		
8.5		4.25		

KRM 2-26-04

**ARCHIVED
ON CADD**

1+360

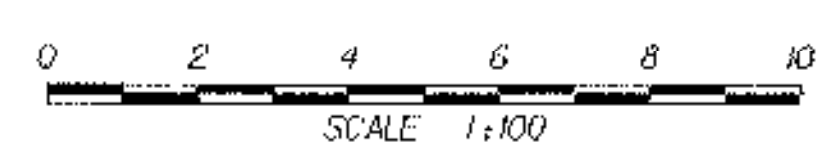

PLOTTED 03-JAN-2002

PROJECT:	BARTON	PROJECT NO.:	STP 0113 (58) S
DESIGN FILE NAME:	96c116/structures/sc116u5s.dgn	PLOT DATE:	03-JAN-2002
IPARM FILE NAME:	sc116518.1		
Relocated US5 Cross Sections			
Sta 1+360		SHEET:	106 OF 120