


203.15	14.6	14.6	14.65m ²
29.2	14.6	14.7	
29.4	14.6	14.7	
203.15 KEY LT	0.3m		
	14.95m		DHS
613.11 RT	17.5	17.55	17.6m ²
	35.1	17.6	
	17.6	17.65	
	35.3		
613.11 LT	8.5	8.45	8.53m ²
	16.9	8.5	
	8.5	8.6	
	17.2		
301.25	5.9	5.9	5.9m ²
	11.8	5.9	
	5.9	5.9	
	11.8		KRM 2-27-04

**ARCHIVED
ON CADD**

1+380

SEE DRAINAGE SHEET FOR DRAINAGE DETAILS

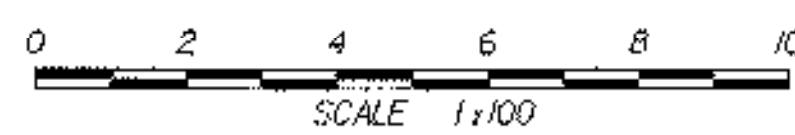

PLOTTED 03-JAN-2002

PROJECT: BARTON	PROJECT NO.: STP 0113 (58) S
DESIGN FILE NAME: 96c116/structures/sc11605s.dgn	PLOT DATE: 03-JAN-2002
IPARM FILE NAME: sc116520.1	Relocated US5 Cross Sections
Sta 1+380	SHEET: 108 OF 120