


301.25	6.0	6.0	5.9m ²
203.15	12.0	5.8	23.85m ²
613.11	11.9	23.9	17.4m ²
	23.9	47.8	
	23.7	47.6	
	17.4	34.7	
	17.4	34.9	

KRM 2-27-04

**ARCHIVED
ON CADD**

Sta 1+395.000 LT
END STONE FILL TYPE 11
END GRUBBING MATERIAL

1+390

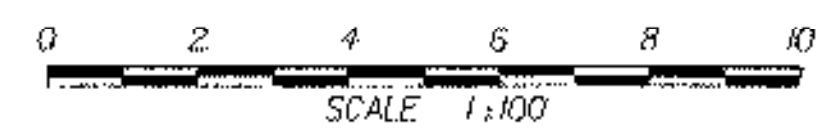

PLOTTED 03-JAN-2002

PROJECT: BARTON	PROJECT NO.: STP 0113 (58) S
DESIGN FILE NAME: 96c116/structures/sc116u5s.dgn	PLOT DATE: 03-JAN-2002
IPARM FILE NAME: sc116521.i	Relocated US Cross Sections
Sta 1+390	SHEET: 109 OF 120