


**ARCHIVED
ON CADD**

1+400

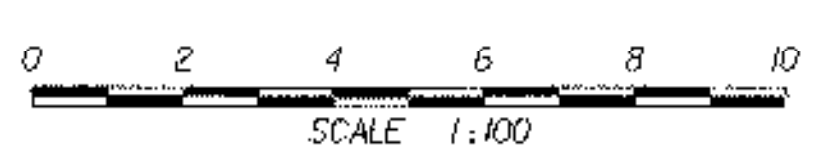

Sta 1+399.000 RT
END STONE FILL TYPE 11
END GRUBBING MATERIAL

PLOTTED 03-JAN-2002

PROJECT: BARTON	PROJECT NO.: STP 0113 (58) S
DESIGN FILE NAME: 96c116/structures/sc116u5s.dgn	PLOT DATE: 03-JAN-2002
IPARM FILE NAME: sc116522.i	Relocated US5 Cross Sections
Sta 1+400	SHEET: 110 OF 120