


203.15
1.9 2.0
4.0 2.0m²
2.0 2.0
4.0

301.25
6.1 6.1
12.2 6.1m²
6.0 6.1
12.2 6.1

KRM 2-27-04

**ARCHIVED
ON CADD**

1+420

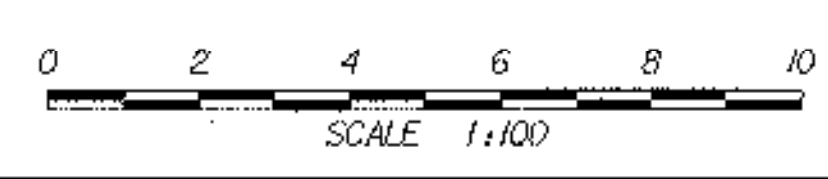

PLOTTED 03-JAN-2002

PROJECT: BARTON	PROJECT NO. 1 STP 0113 (58) S
DESIGN FILE NAME: 96c116/structures/sc116u5s.dgn	PLOT DATE: 03-JAN-2002
IPARM FILE NAME: ec116524.i	
Relocated US5 Cross Sections	
Sta 1+420	SHEET: 102 OF 120