


**ARCHIVED
ON CADD**

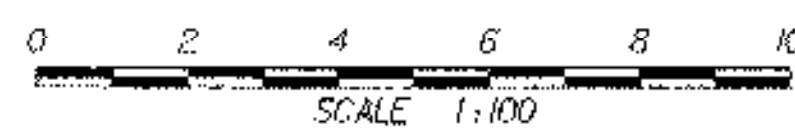

PLOTTED 03-JAN-2002

PROJECT: BARTON	PROJECT NO. 1 STP 0113 (58) S
DESIGN FILE NAME: 96c116/structures/sc116u5s.dgn	PLOT DATE: 03-JAN-2002
JPARM FILE NAME: sc116525.i	Relocated US5 Cross Sections
Sta I+430 THRU Sta I+440	SHEET: 113 OF 120