


**ARCHIVED
ON CADD**

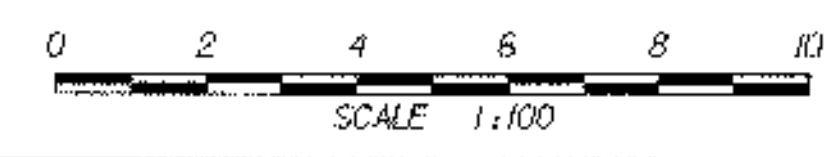

PROJECT: BARTON	PROJECT NO.: STP 0113 (58) S
DESIGN FILE NAME: 96c116/structures/sc116u5s.dgn	PLOT DATE: 03-JAN-2002
IPARM FILE NAME: sc116526.i	
Relocated US5 Cross Sections	
Sta I+450 THRU Sta I+460	SHEET: 114 OF 120