


**ARCHIVED  
ON CADD**

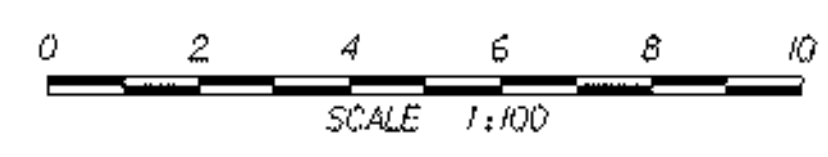

PLOTTED 03-JAN-2002

PROJECT:	BARTON	PROJECT NO.:	STP 0113 (58) S
DESIGN FILE NAME:	96g116/structures/sc116u5s.dgn	PLOT DATE:	03-JAN-2002
JPARM FILE NAME:	sc116527.i		
Relocated USS Cross Sections		Sta I+470 THRU Sta I+480	
		SHEET:	115 OF 120