


203.15	12.7	12.7	12.7m <sup>2</sup>
25.4	12.7	12.7	12.7m <sup>2</sup>
25.4	12.7	12.7	12.7m <sup>2</sup>
301.25	5.6	5.6	5.6m <sup>2</sup>
11.2	5.6	5.6	5.6m <sup>2</sup>
5.5	5.6	5.6	5.6m <sup>2</sup>
11.2	5.6	5.6	5.6m <sup>2</sup>
613.11	1.5	1.5	1.5m <sup>2</sup>
3.0	1.5	1.5	1.5m <sup>2</sup>
1.5	1.5	1.5	1.5m <sup>2</sup>
3.0	1.5	1.5	1.5m <sup>2</sup>

I+520

Sta 1+520.000  
END PROJECT

SEE DRAINAGE SHEET FOR DRAINAGE DETAILS

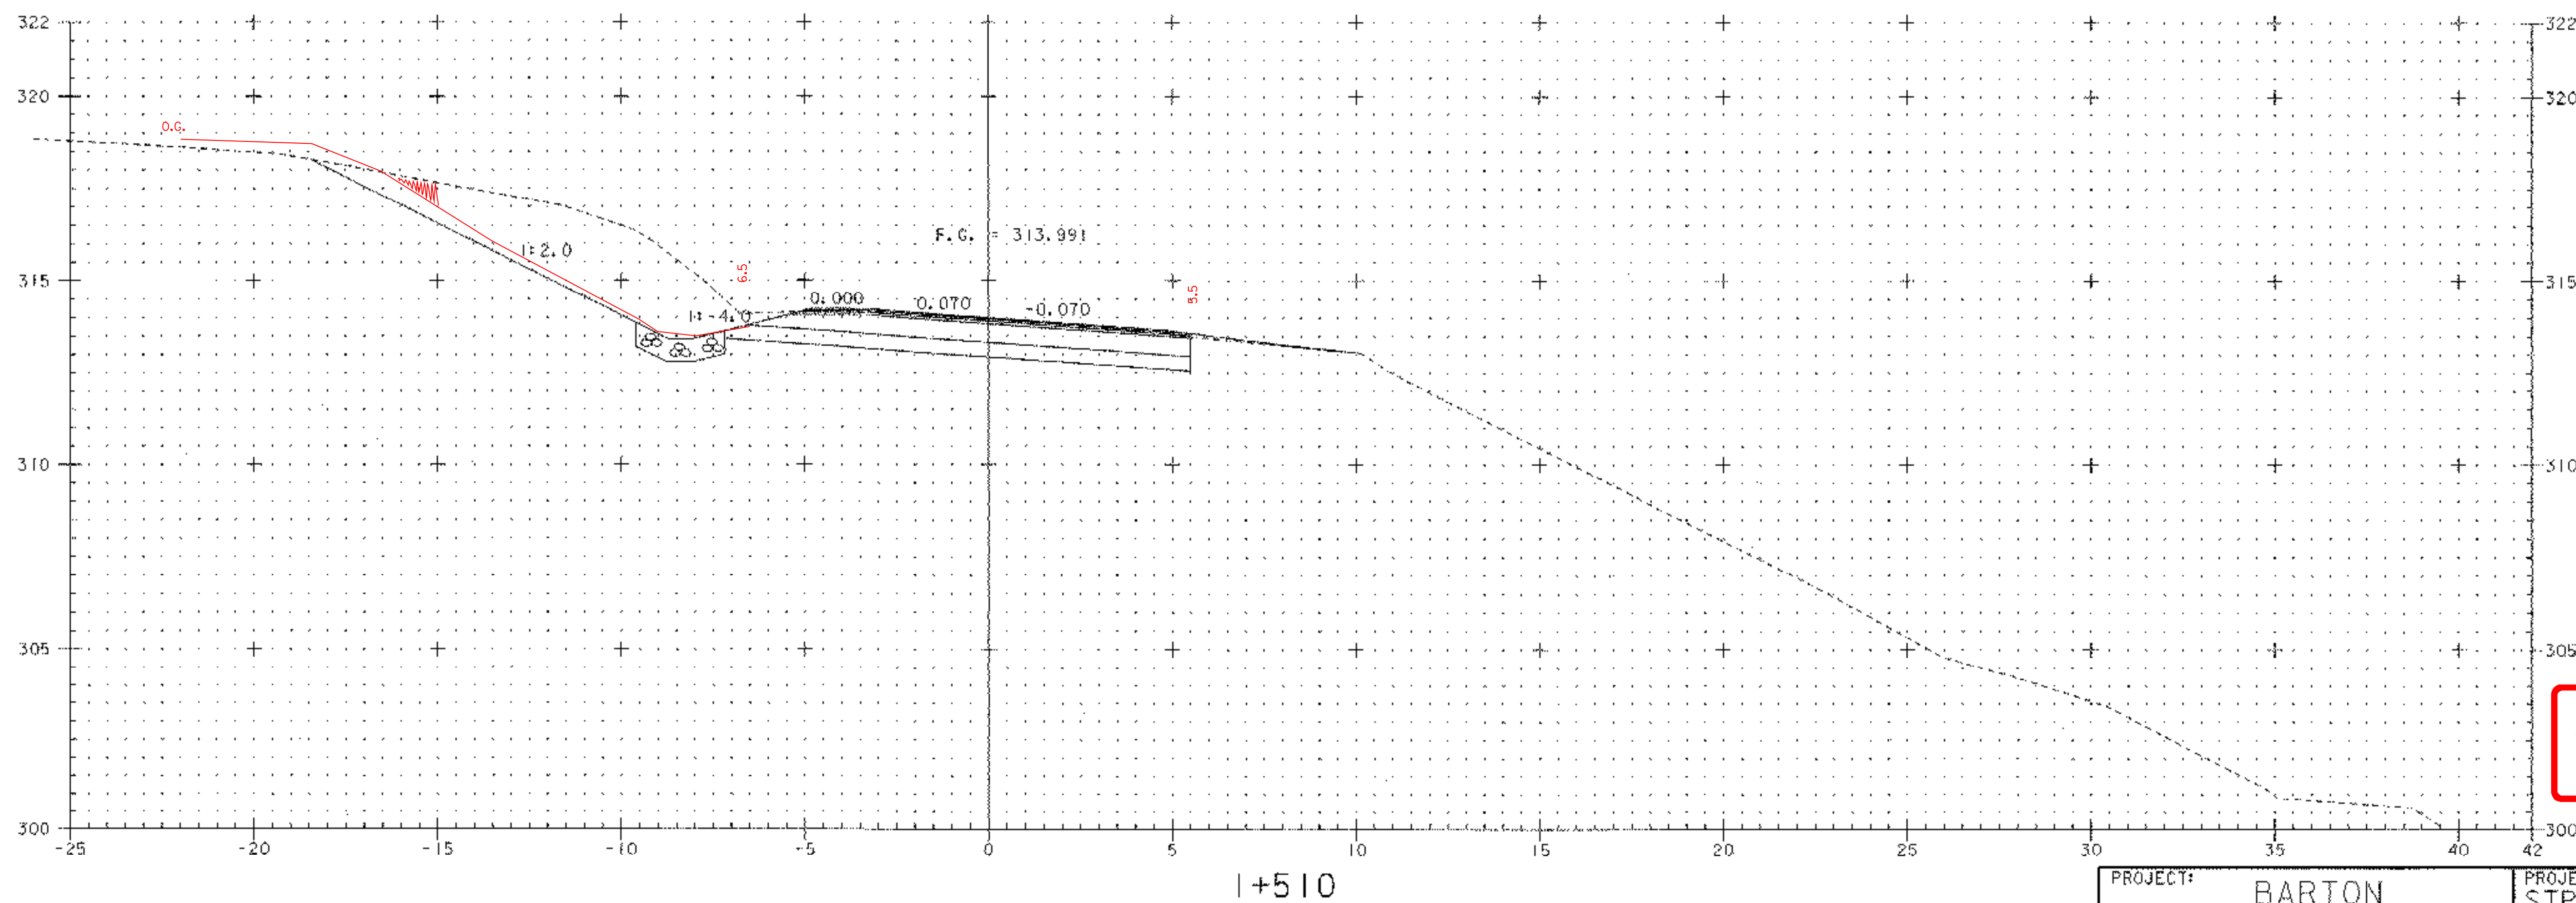


203.15	27.0	27.1	27.1m <sup>2</sup>
54.2	27.1	27.1	27.1m <sup>2</sup>
27.1	27.1	27.1	27.1m <sup>2</sup>
54.2	27.1	27.1	27.1m <sup>2</sup>
301.25	5.6	5.6	5.6m <sup>2</sup>
11.2	5.6	5.6	5.6m <sup>2</sup>
5.7	5.6	5.6	5.6m <sup>2</sup>
11.2	5.6	5.6	5.6m <sup>2</sup>
613.11	1.5	1.5	1.5m <sup>2</sup>
3.0	1.5	1.5	1.5m <sup>2</sup>
1.5	1.5	1.5	1.5m <sup>2</sup>
3.0	1.5	1.5	1.5m <sup>2</sup>

KRM 2-27-04

I+510

**ARCHIVED  
ON CADD**

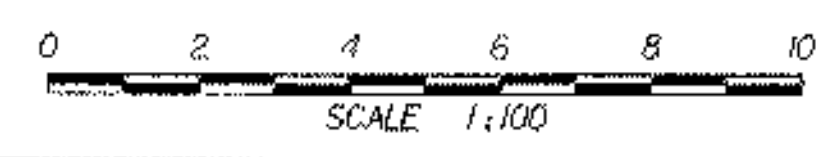

PROJECT: BARTON	PROJECT NO.: STP 0113 (58) S
DESIGN FILE NAME: 96c116/structures/sc116u5s.dgn	IPARM FILE NAME: sc116529.i
Relocated US5 Cross Sections	PLOT DATE: 03-JAN-2002
Sta 1+510 THRU Sta 1+520	SHEET: 117 OF 120

PLOTTED 03-JAN-2002