


203.15
 4.6 4.6
 9.2 4.6 4.65m²
 4.6 4.7
 9.4

301.25
 12.1m x 0.3m = 3.6m²

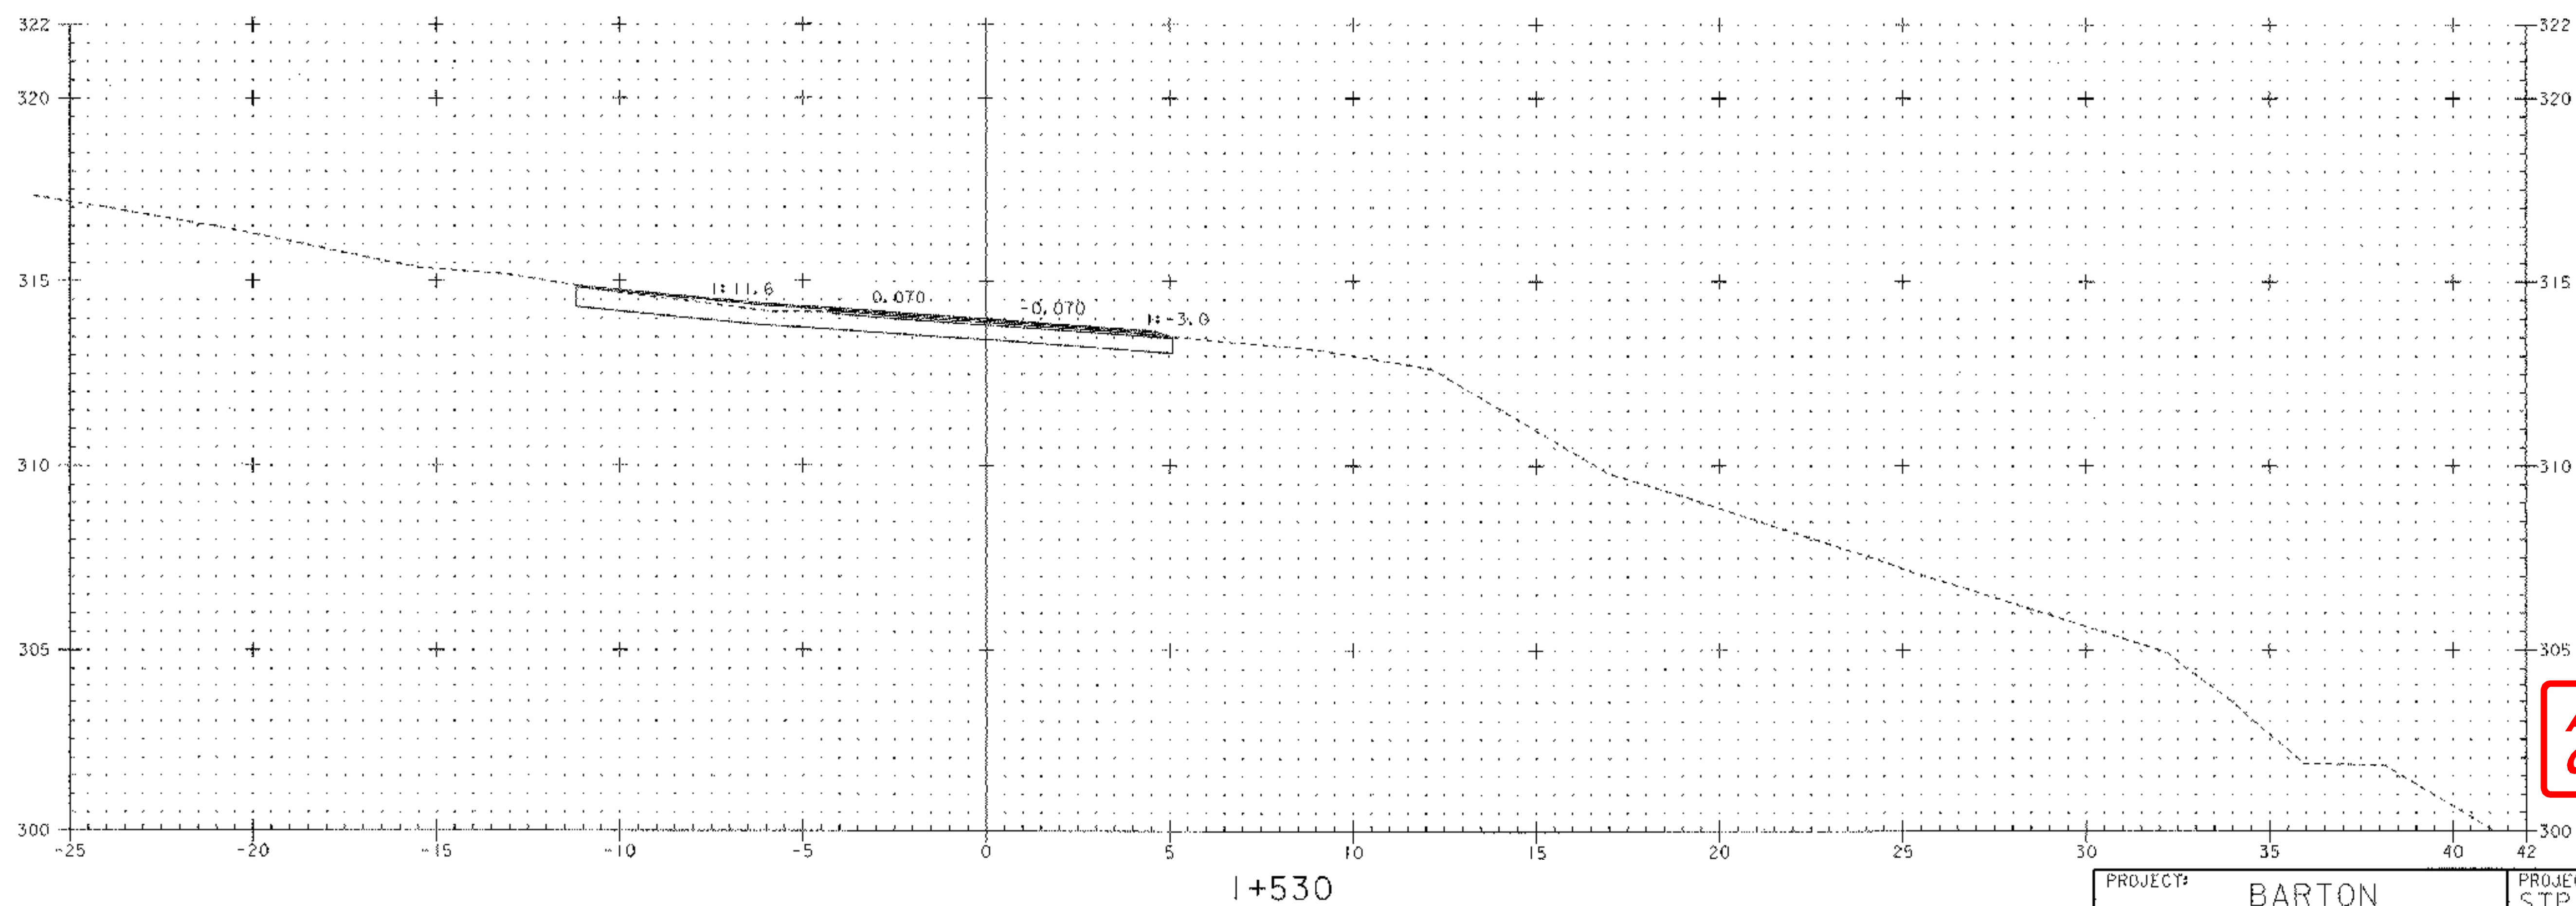


203.15
 7.5 7.4
 14.8 7.4 7.45m²
 7.6 7.5
 15.0

301.25
 16.3m x 0.4m = 6.52m²

KRM 2-27-04

ARCHIVED
ON CADD

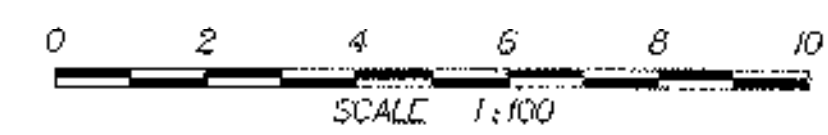

PROJECT: BARTON	PROJECT NO.: STP 0113 (58) S
DESIGN FILE NAME: 96c116/structures/sc116u5s.dgn	PLOT DATE: 03-JAN-2002
Relocated US5 Cross Sections	
Sta I+530 THRU Sta I+540	SHEET: 118 OF 120