


203.15  
2.6 2.6  
5.2 2.6m<sup>2</sup>  
2.6 2.6  
5.2  
301.25  
7.6m x 0.2m = 1.52m<sup>2</sup>  
KRM 2-27-04

**ARCHIVED  
ON CADD**

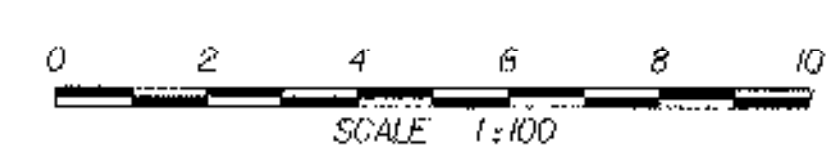

PROJECT: BARTON	PROJECT NO.: STP 0113 (58) S
DESIGN FILE NAME: 96c116/structures/sc116u5a.dgn	PLOT DATE: 03-JAN-2002
IPARM FILE NAME: sc116531.i	
Relocated US5 Cross Sections	
Sta I+550 THRU Sta I+560	SHEET: 119 OF 120