
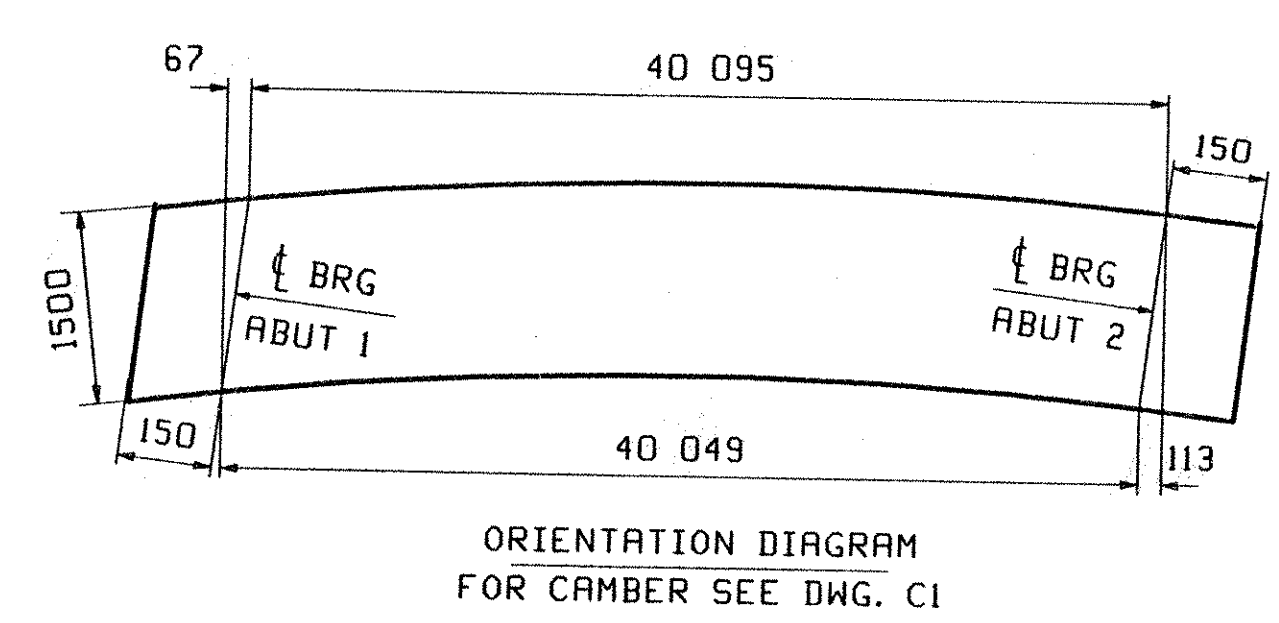
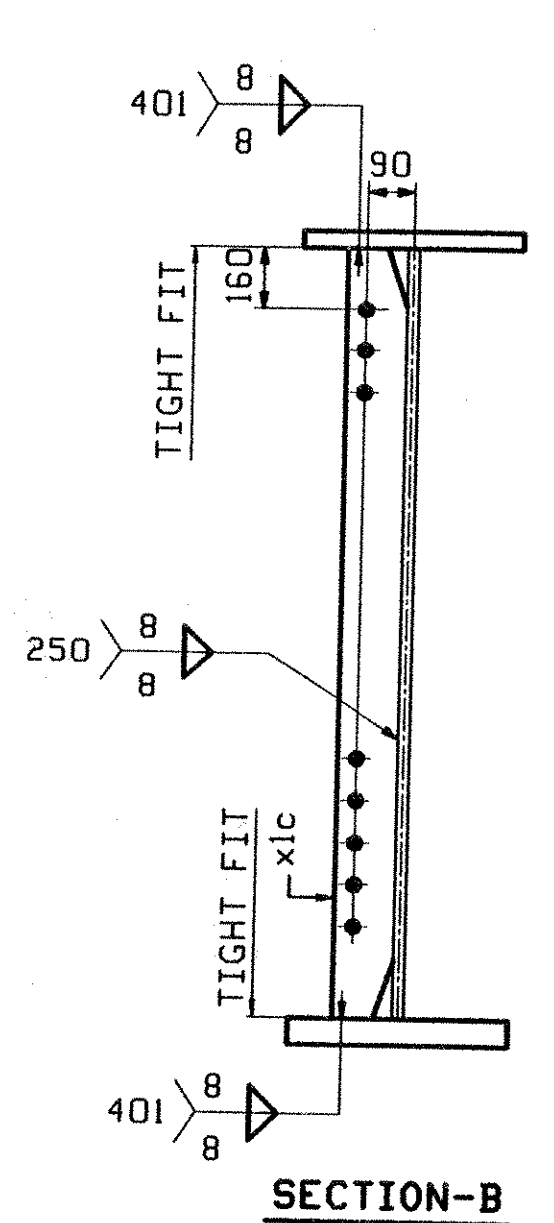
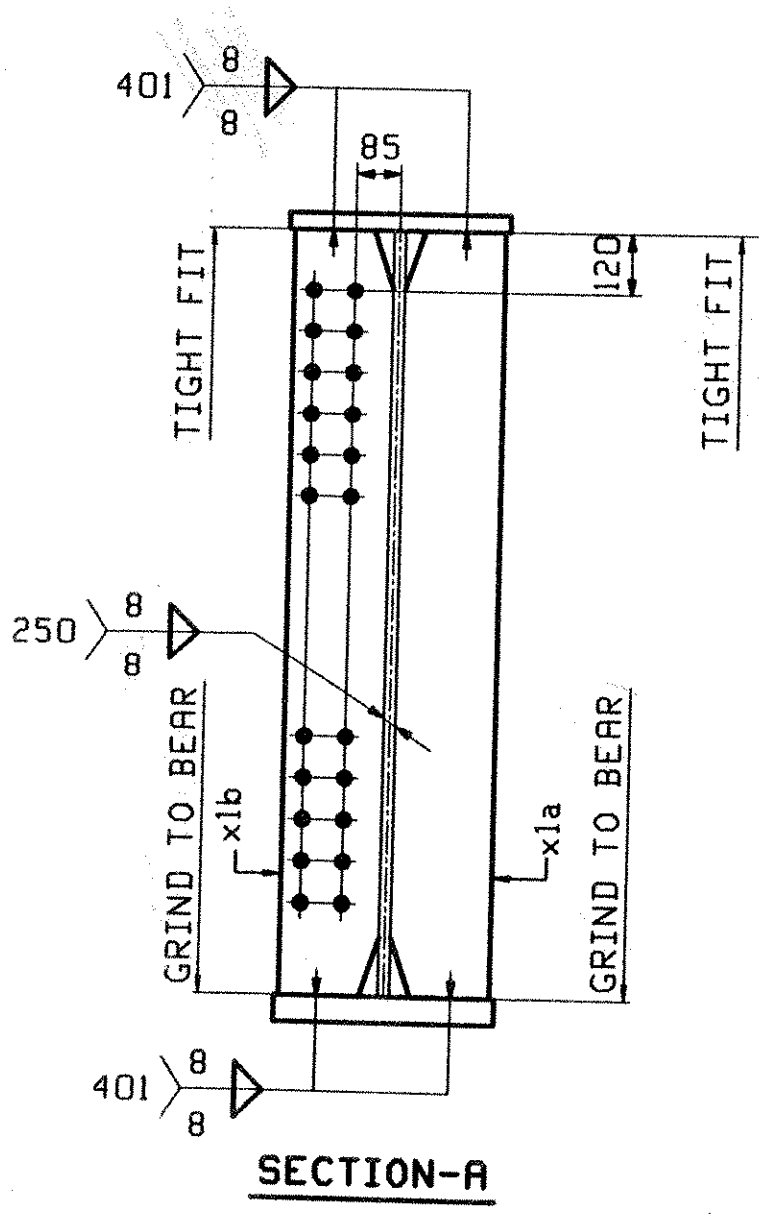
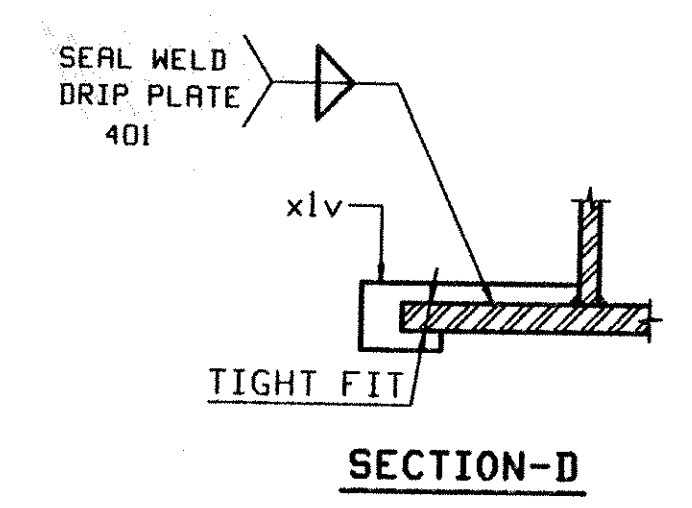


ABM INFO		BILL OF MATERIAL				JOB NO.		DRAWING NO.		REV.
PAGE	LINE	MARK	QTY	MARK	MATERIAL	LENGTH		REMARKS	WT	PROCUREMENT NOTES
						m	mm			
		GIA	1		GIRDER					13848 30529
1	G		1	wa	PL 14x1555	19	869	(M270M-345MT2)	(H2-3)	
1	E		1	wb	PL 14x1558	20	613	(M270M-345MT2)	(H2-3)	
1	J		1	ta	PL 22x426	20	450			
1	L		1	tb	PL 22x426	19	945			
1	C		1	ba	PL 22x426	10	160	(M270M-345MT2)	(H2-3)	
1	A		1	bb	PL 32x426	20	030	(M270M-345MT2)	(H2-3)	
1	C		1	bc	PL 22x426	10	159	(M270M-345MT2)	(H2-3)	
2	B		2	xlb	PL 22x200	1	500			
2	B		2	xla	PL 22x200	1	500			
2	C		5	xlc	PL 14x127	1	500			
2	D		1	xlv	PL 6x72	0	291	DRIP BAR		

**ONE - GIRDER - GIA**

1. FOR GIRDER STANDARD DETAILS SEE DRAWING XI.
2. FOR CAMBER AND FLANGE DIAGRAMS SEE DRAWING CI.
3. FOR GENERAL NOTES SEE DRAWING GNI.

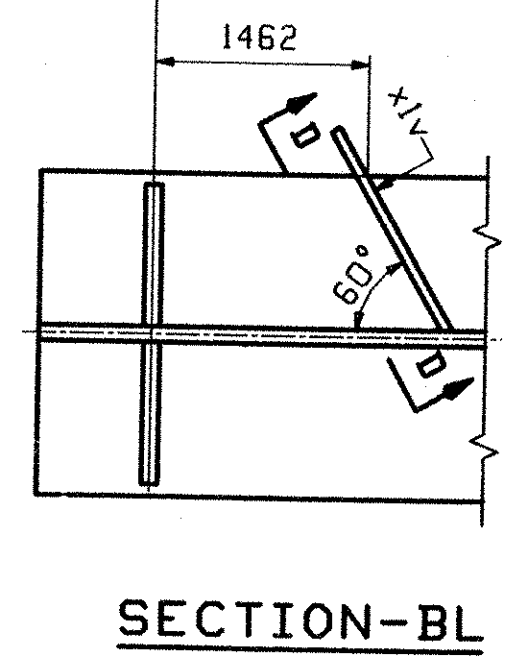

RECEIVED  
 OK'D BY: *LS* OK'D BY: *RSY*  
 SEP 04 2002  
 RESUBMIT: \_\_\_\_\_ APPROVED: *A*  
 BY: *AW* DATE: 9/17/02

OUT FOR APPROVAL	8-30-02									
OUT FOR APPROVAL										
ISSUED TO SHOP										
FIELD & OFFICE										

REV.	REMARKS	DATE	DWN	CHK	APP	Q.A.	NO.	DIA.	LGT	TYPE	WASHER
	MATERIAL: M270M-345W										SHOP BOLTS:
	ELECTRODES:										
	HOLES: (24mm) (15/16)φ										

SURFACE PREP. & PAINT:  
 -STEEL WITHIN 1500 OF ABUT. 2 END OF GIRDERS SHALL BE PAINTED (SEE GNI)  
 -ALL OTHER STEEL SHALL BE BLAST CLEANED AND LEFT UNPAINTED.

DESCRIPTION:	GIRDER - GIA	DRAWN BY	DATE
JOB:	US Route 5 over Northern Vermont RR	PHG	08/23
	BRIDGE NO. 161	CHKD BY	
	BARTON, VERMONT (ORLEANS COUNTY)	JB	08/25
	CONTRACTOR: WINTERSET	APPROV BY	
		SUPERVISOR	H. J. GATTI
PROJ NO.	AC STP 0113 (58) S	Q.A.	
CUSTOMER:	VERMONT AGENCY OF TRANSPORTATION		

<b>CASCO BAY STEEL STRUCTURES, INC.</b>	JOB NO.	DRG. NO.
75 SPRING HILL ROAD PHONE (207) 282-7360	SACO, MAINE 04072 FAX. (207) 282-1179	163 1
	REV.	△

P&G  
 Rev. 28 10/20/03 EDT 2002  
 04/11/02/03/04/1936/1937