
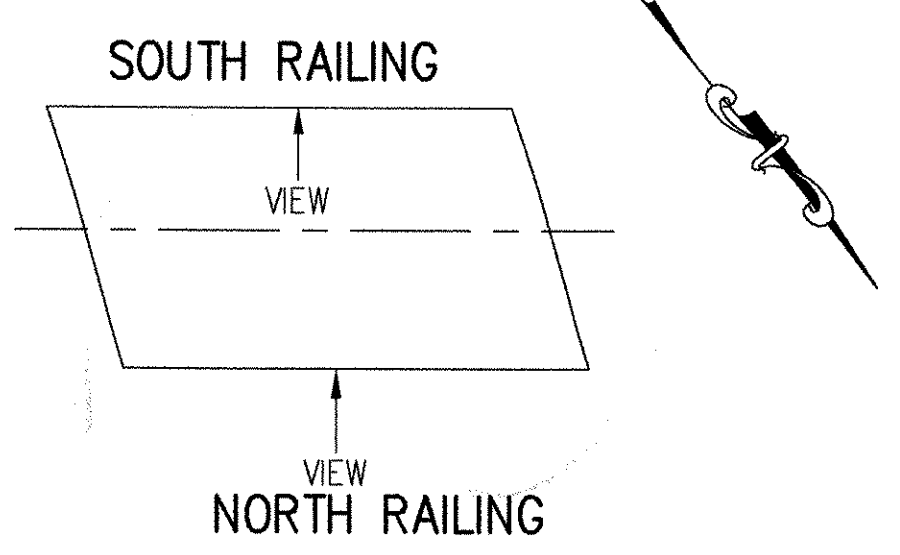
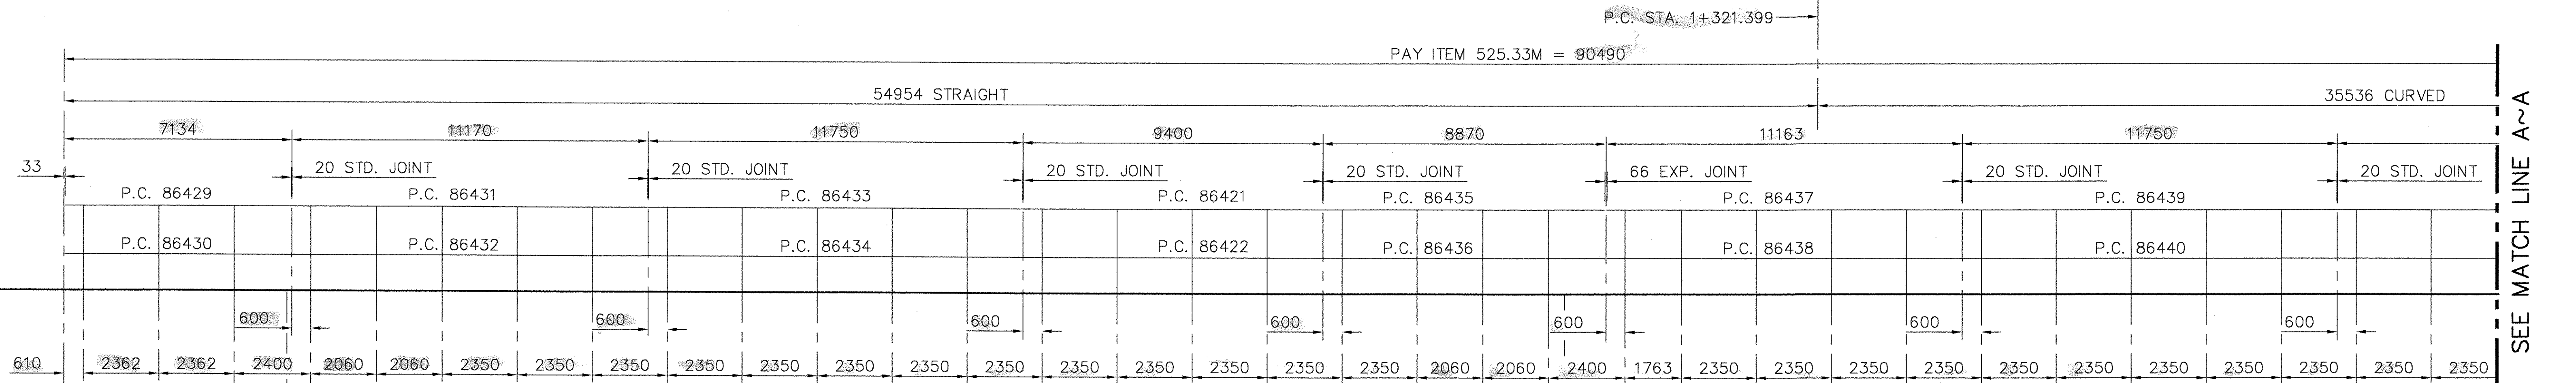


F:\RA\Share\Engineering\WIP\VT1004148\22-1004148-E2.dwg 6/25/02 12:18:03

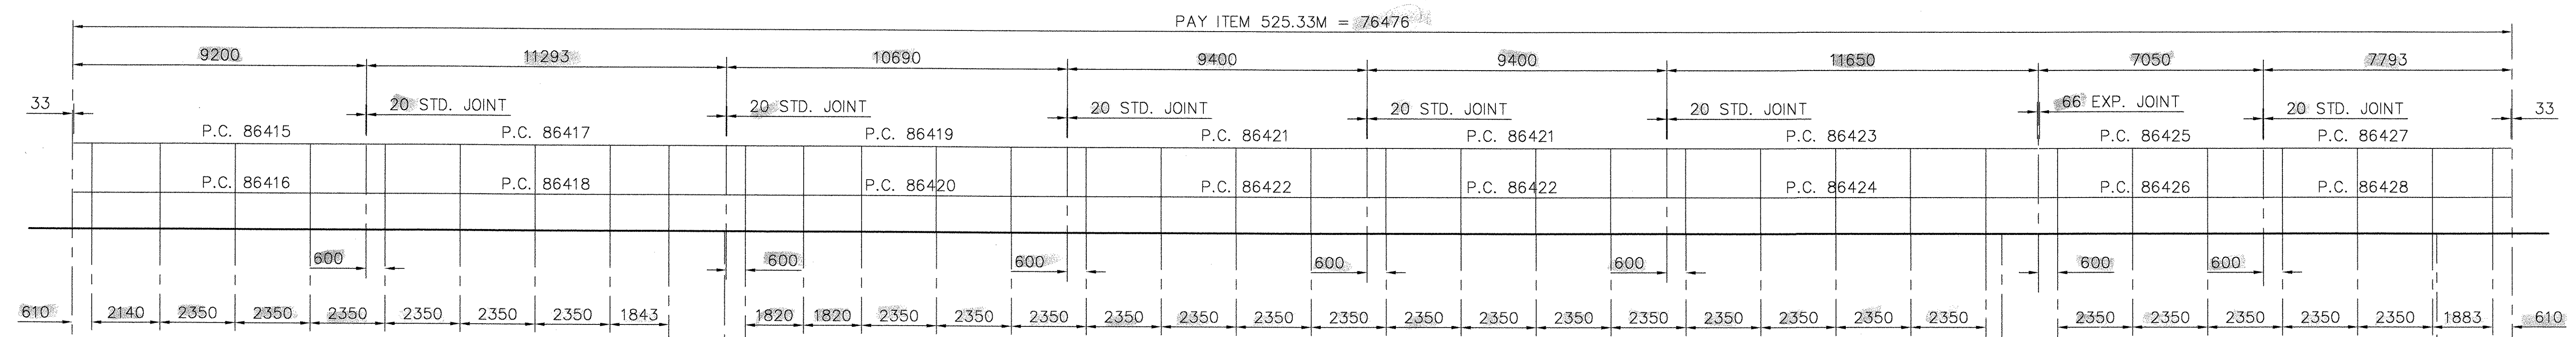

ISSUED
JUN 25 2002
TRINITY INDUSTRIES, INC.
1170 N. STATE STREET
GRIARD, OHIO 44420

NOTE: APPROVAL DRAWING
ALL DIMENSIONS ARE SHOWN ALONG
PROFILE GRADE (SLOPE LENGTH) AT Q OF
ANCHORAGE.

FOR ERECTION DETAILS AND NOTES SEE SH. E1 OF 2 (22) 1004148
FOR DETAILS SEE DETAIL DRAWINGS D1, D2, D3 & D4 OF 4 (22) 1004148

RECEIVED
OK'D BY RSK OK'D BY LJB
JUL 23 2002
RESUBMIT APPROVED BY [Signature]
BY CPW DATE [Signature]

- NOTES:
- 1) ALL RAILING POSTS ARE P.C. 86443.
 - 2) ALL T.S. 203 x 102 RAIL SPLICES ARE P.C. 35107.
 - 3) ALL T.S. 102 x 102 RAIL SPLICES ARE P.C. 35103.
 - 4) TOTAL PAY LENGTH: 166.966m
 - 5) FINISH: GALV. A123
HARDWARE: GALV. A153
 - 6) ALL DIMENSIONS ARE IN mm UNLESS NOTED.

This drawing and the information shown thereon is the sole property of TRINITY INDUSTRIES, INC. Neither the drawing nor such information is to be used for any purpose other than that for which it was specifically furnished by TRINITY INDUSTRIES, INC. nor is any reproduction authorized without written permission.

REV.	CHK'D	BY	DATE	REMARKS

PAY ITEM NUMBER 525.33M ST. BR. RL. 2 RL. NETC

STATE OF VERMONT AGENCY OF TRANSPORTATION TOWN OF BARTON COUNTY OF ORLEANS US ROUTE 5 OVER NORTHERN VERMONT RAILROAD PROJECT #STP0113(58)S BRIDGE No. 161	DRAWN SAR CHECKED JRS SCALE: NTS DATE 6/7/02
CUSTOMER NORTHLAND SPECIALTIES P.O. No. VERBAL	ENG. FILE # 22-1004148-E2 SHT.No. E2 OF 2 TRINITY SALES ORDER NO. (22) 1004148

TRINITY INDUSTRIES, INC.
HIGHWAY SAFETY PRODUCTS
2525 STEMMONS FREEWAY, DALLAS, TX 75207

SEE MATCH LINE A~A