
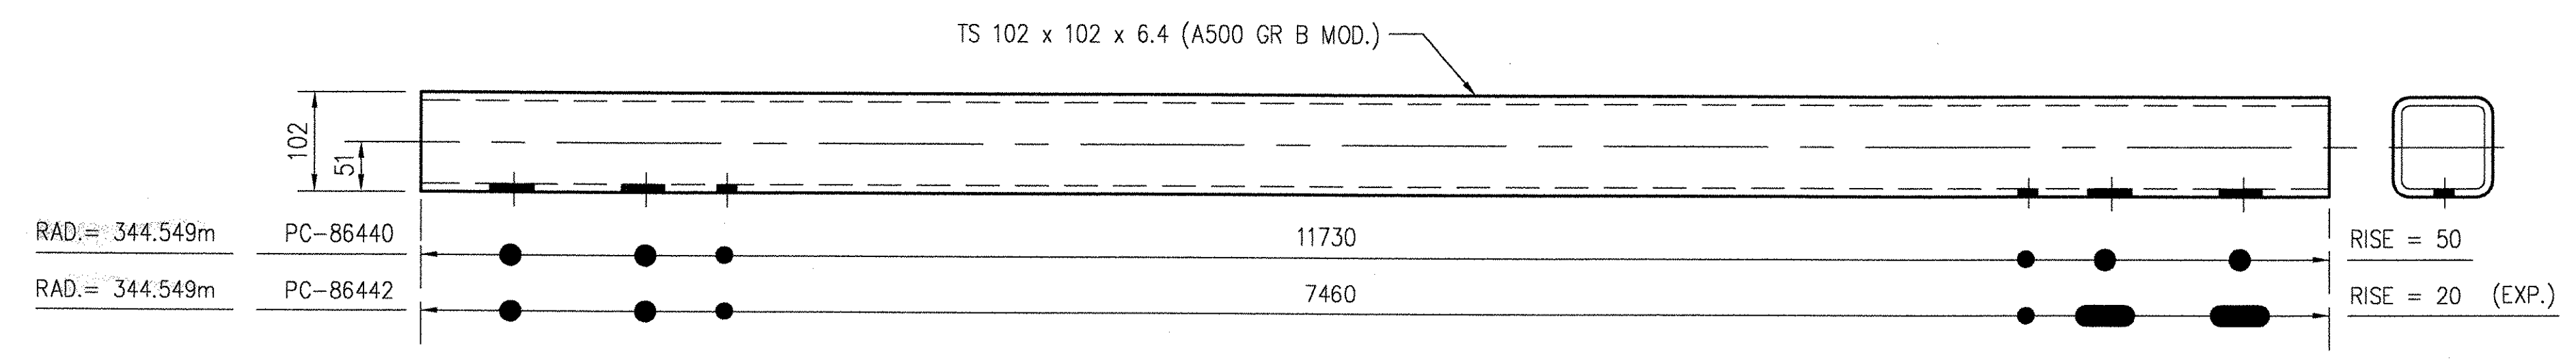
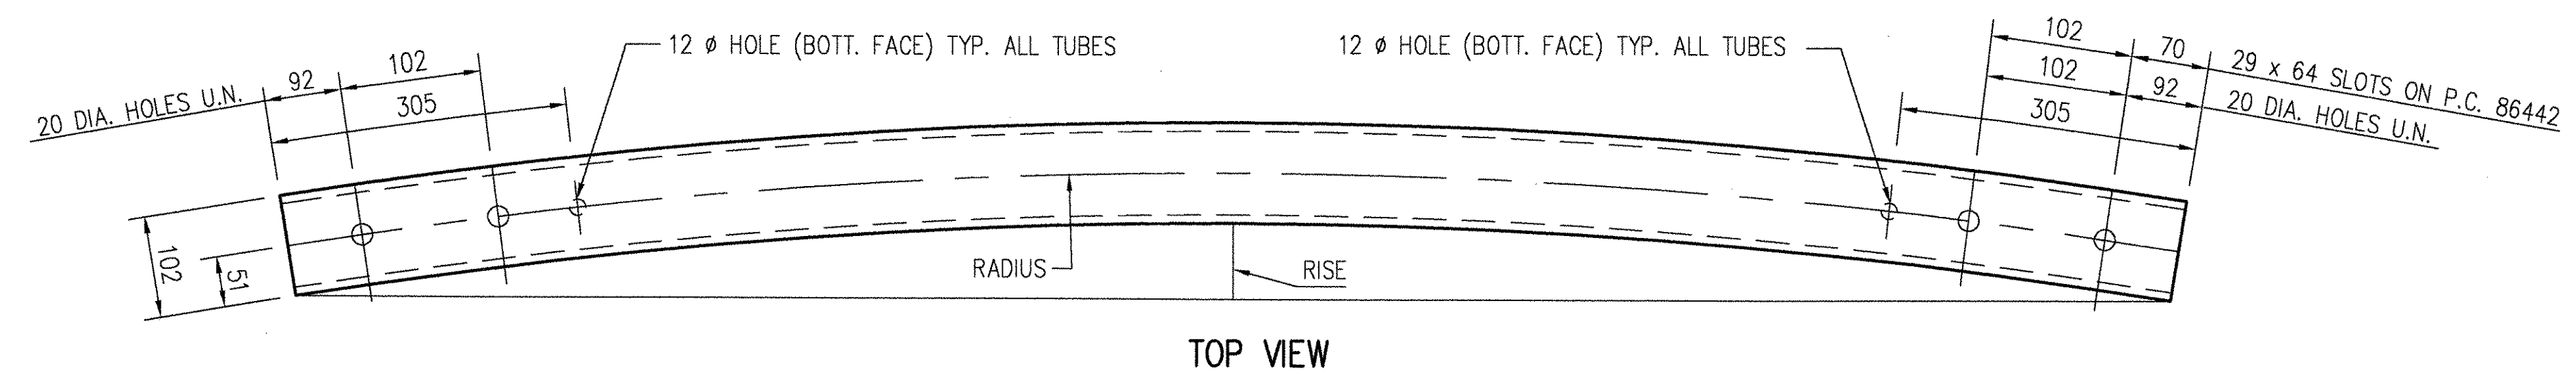
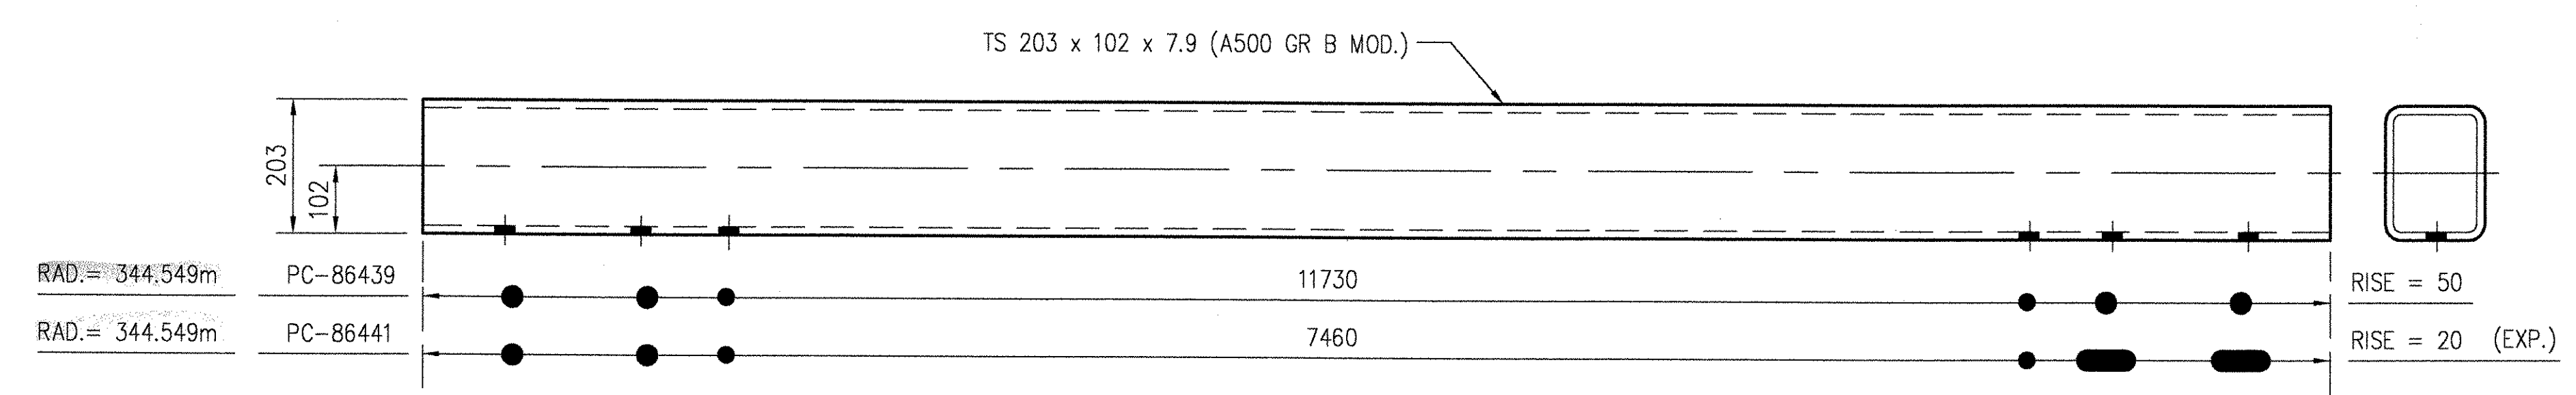


F:\P\Share\Engineering\WIP\VT1004148\22-1004148-D3.dwg 6/25/02 12:18:00

BILL OF MATERIAL				
PRODUCT CODE	QTY.	DESCRIPTION	WT. EA.	REMARKS
86439A	2	TS 203 x 102 x 7.9 x11730	433 kg.	
86441A	1	TS 203 x 102 x 7.9 x 7460	275 kg.	
86440A	2	TS 102 x 102 x 6.4 x11730	226 kg.	
86442A	1	TS 102 x 102 x 6.4 x 7460	144 kg.	

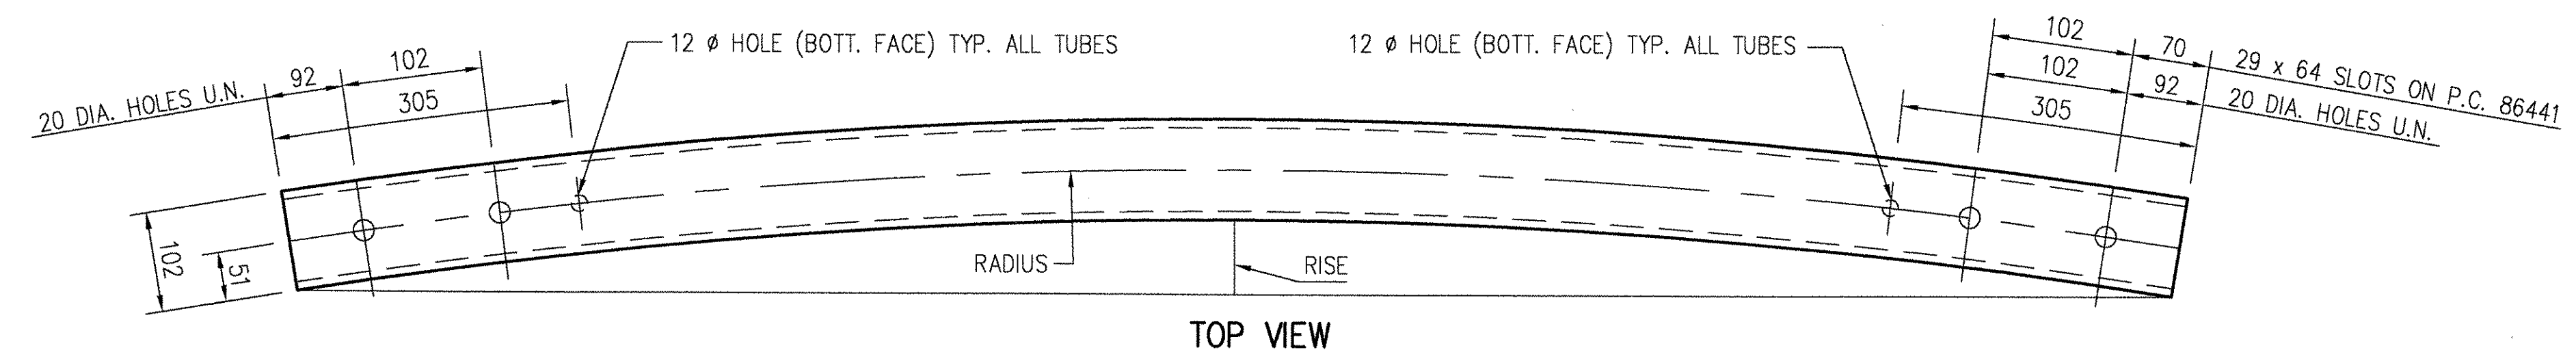


**APPROVAL DRAWING**

**NOTES:**


- FOR GENERAL NOTES PLEASE REFER TO SHEET D1 OF 4
- FOR ERECTION LAYOUT SEE SHEET E2 OF 2 (22) 1004148
- DETAIL DIMENSIONS SHOWN ARE ALONG CENTERLINE OF RAIL.

RECEIVED  
 CKD BY RSY OK'D BY WJES  
 JUL 23 2002  
 RESUBMIT \_\_\_\_\_ APPROVED   
 BY OPW DATE 8/14/02  
 TRINITY INDUSTRIES, INC.  
 1170 N. STATE STREET  
 GRIARD, OHIO 44420

REV.	CHK'D	BY	DATE	REMARKS
<b>PAY ITEM NUMBER 525.33M ~ ST. BR. RL 2 RL. NETC</b>				
STATE OF VERMONT AGENCY OF TRANSPORTATION TOWN OF BARTON COUNTY OF ORLEANS US ROUTE 5 OVER NORTHERN VERMONT RAILROAD PROJECT #STP0113(58)S BRIDGE No. 161				DRAWN SAR CHECKED JRS SCALE: N.T.S. DATE 06/12/02
CUSTOMER NORTHLAND SPECIALTIES P.O. No. VERBAL				ENG. FILE # 22-1004148-D3 SHT.No. D3 OF 4 TRINITY SALES ORDER NO. (22) 1004148 REV. 0

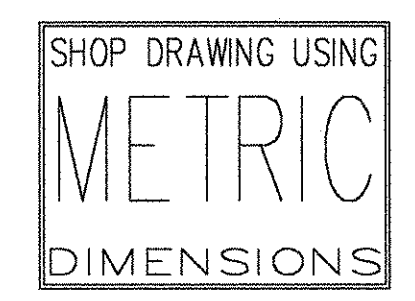

This drawing and the information shown thereon is the sole property of TRINITY INDUSTRIES, INC. Neither the drawing nor such information is to be used for any purpose other than that for which it was specifically furnished by TRINITY INDUSTRIES, INC. nor is any reproduction authorized without written permission.

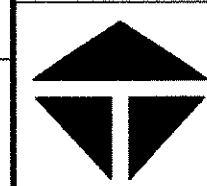

**TRINITY INDUSTRIES, INC.**  
 HIGHWAY SAFETY PRODUCTS  
 2525 STEMMONS FREEWAY, DALLAS, TX 75207