



Profile Along Temporary Detour

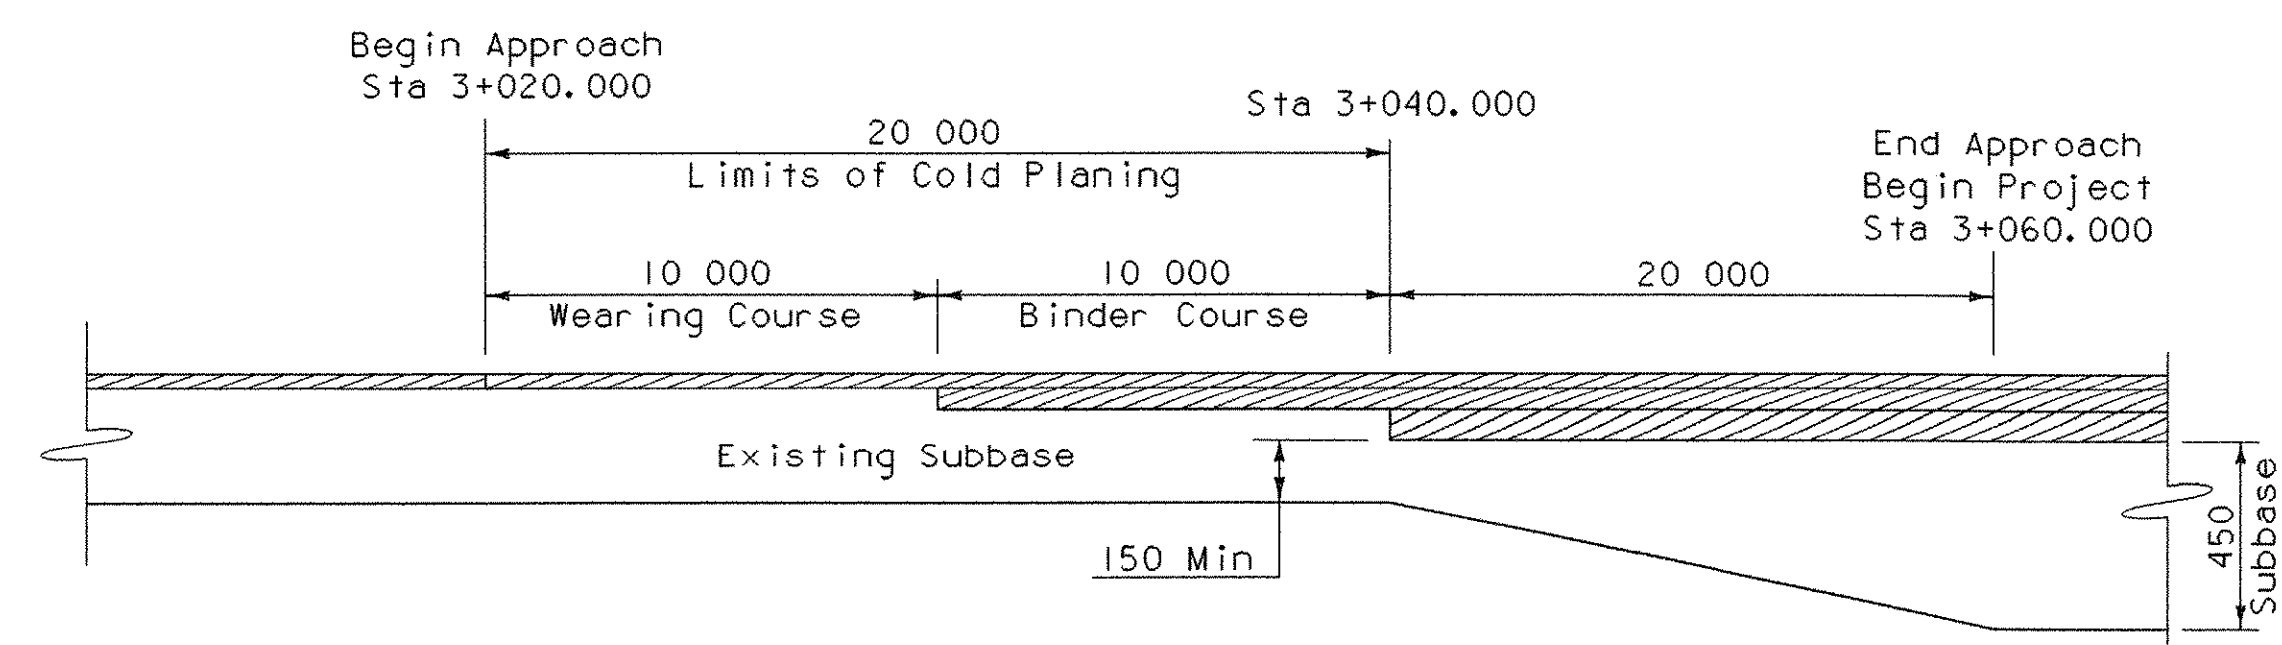


SUBBASE TAPER AT BEGIN PROJECT
NTS

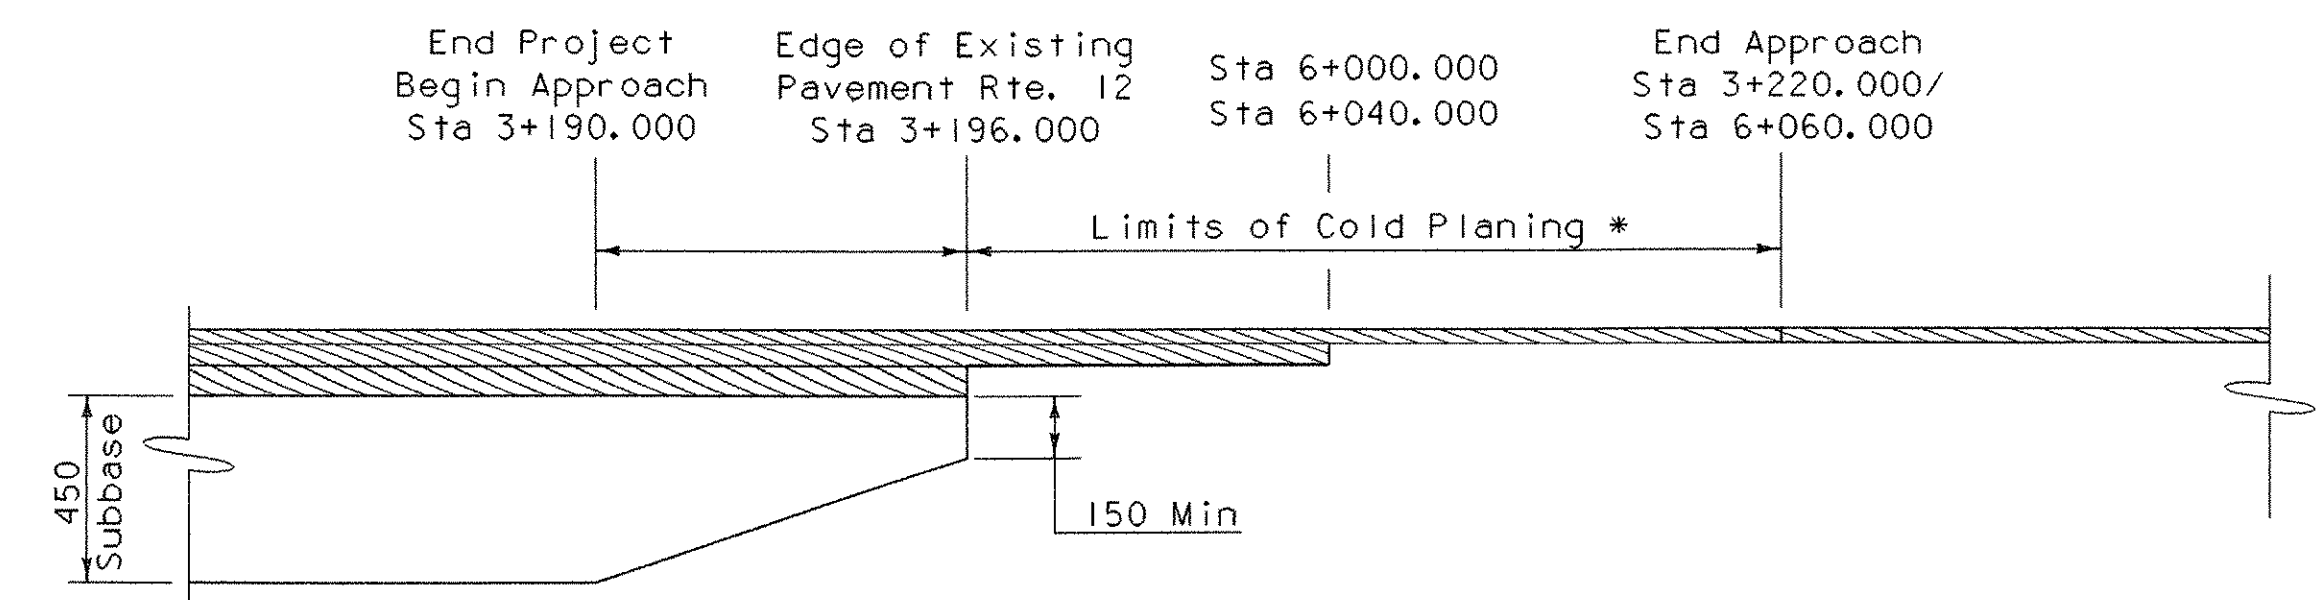

SUBBASE TAPER AT END PROJECT
NTS

* Limits of Cold Planing may be adjusted in the field as deemed necessary by the resident engineer.

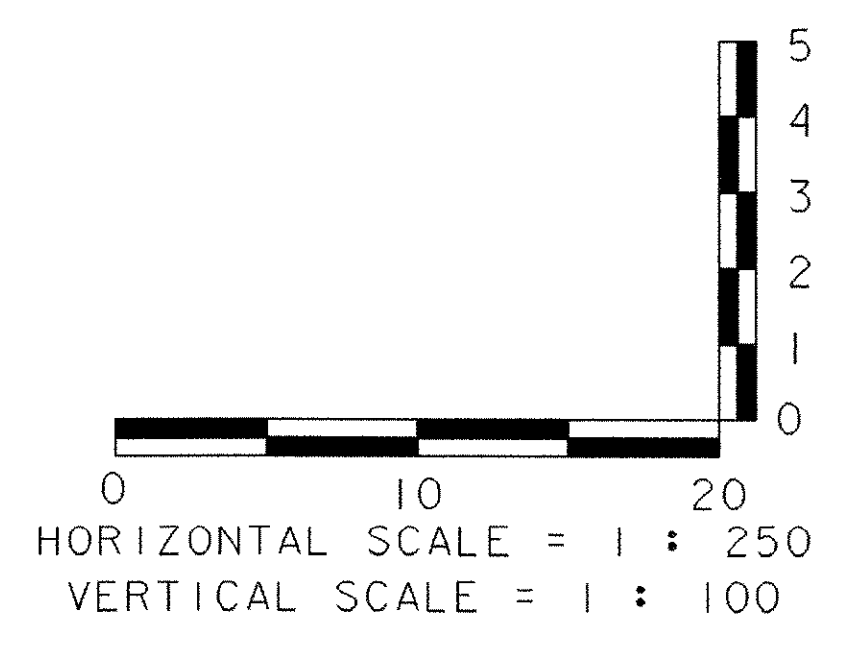

DATUM	
VERTICAL	NAVD 88
HORIZONTAL	NAD 83/92

PROJECT: BETHEL	PROJECT NO. : BRF 0241 (33) - C1
DESIGN FILE NAME: 96j250/structures/s96j250pro-cl.dgn	PLOT DATE: 09-JUL-2003
IPARM FILE NAME: s96j250pr1-cl.i	SURVEYED BY: ORVIS
SQUAD LEADER: C. P. WILLIAMS	DRAWN BY: KMH
TEMPORARY DETOUR PROFILE	SHEET: 10 OF 47