




Profile Bethel Mills Drive

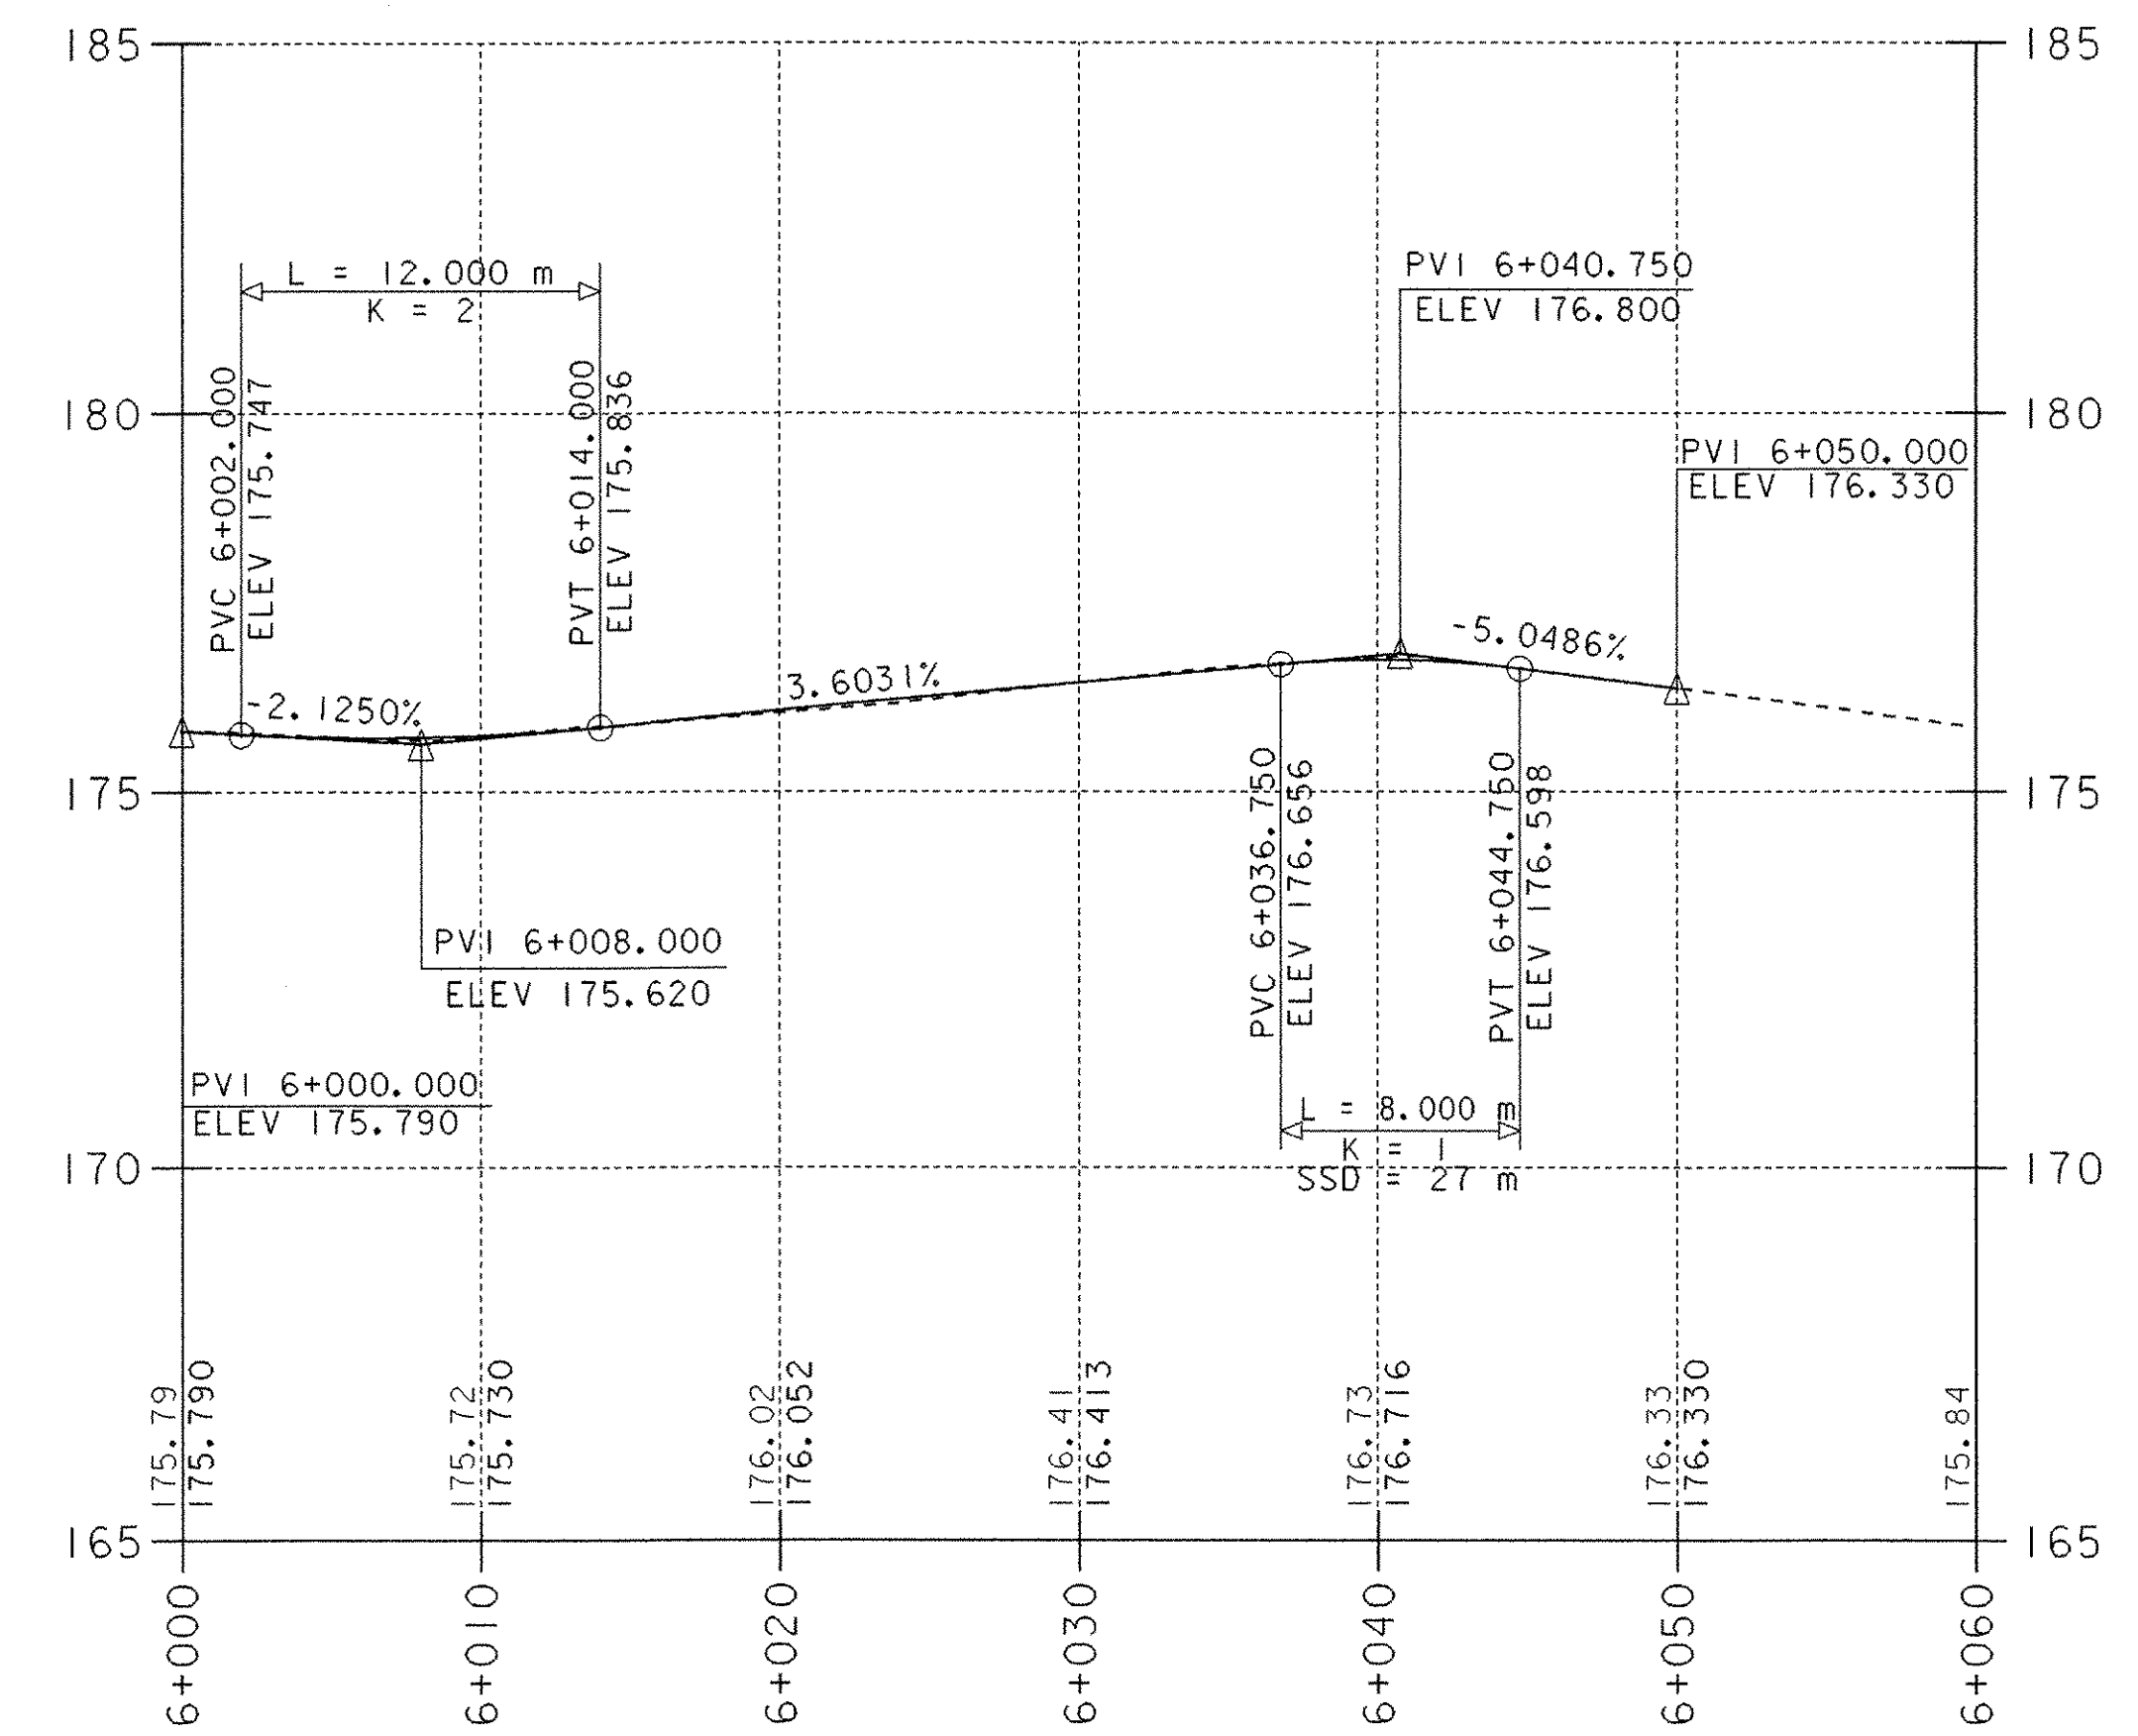

Profile Along TH 5

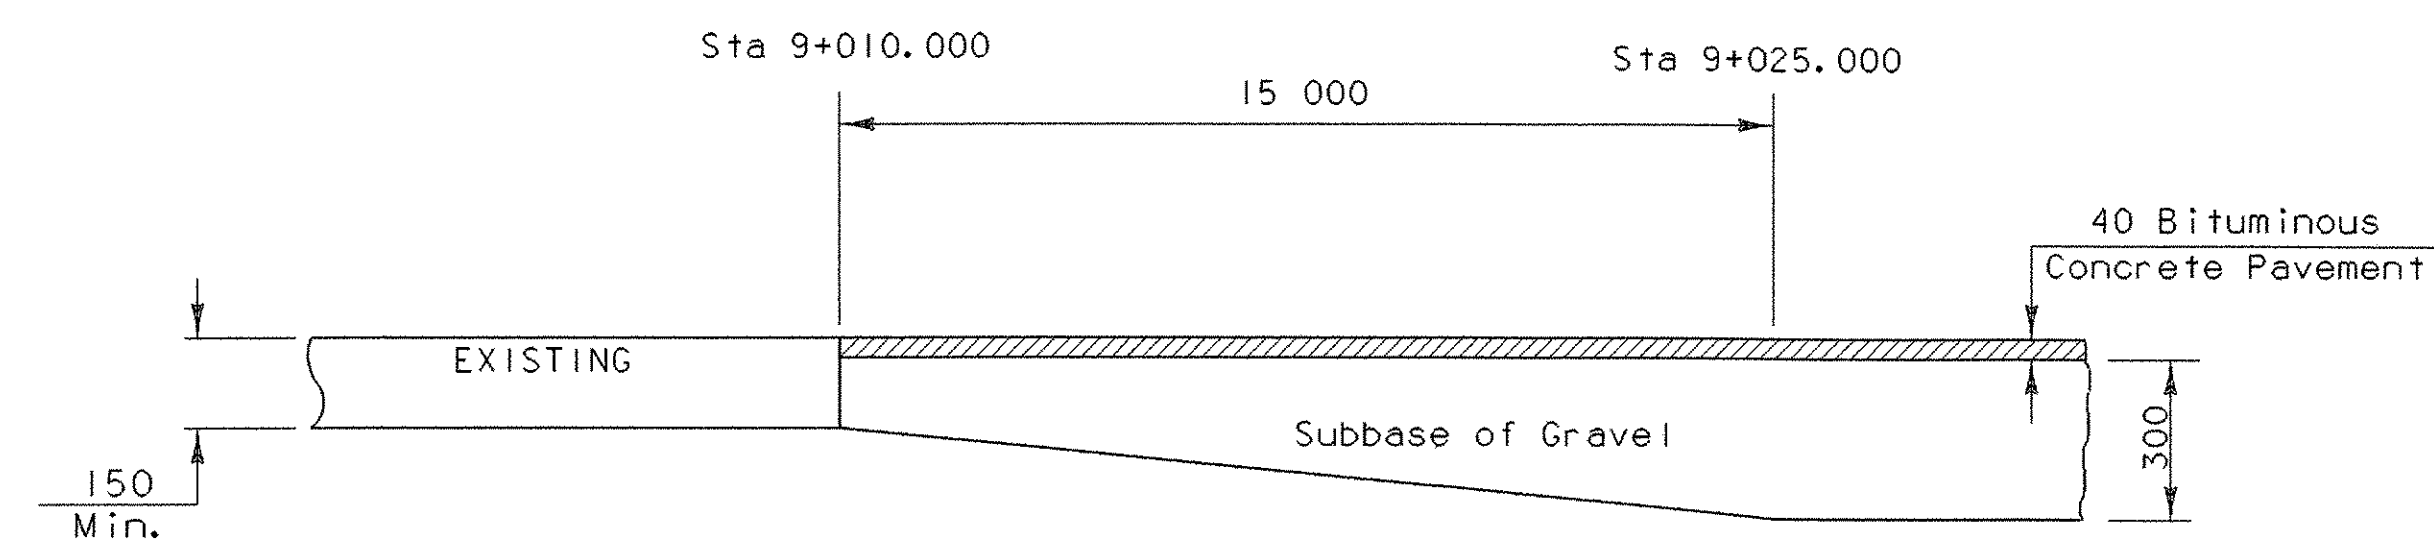

SUBBASE TAPER BETHEL MILLS DRIVE
NTS

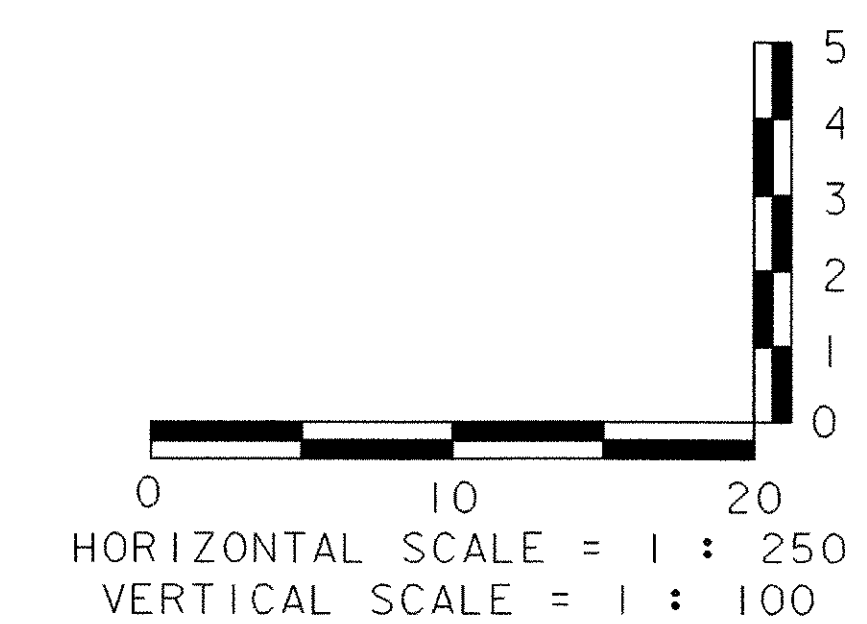

DATUM	
VERTICAL	NAVD 88
HORIZONTAL	NAD 83/92

PROJECT:	BETHEL	PROJECT NO. :	BRF 0241 (33) -C1
DESIGN FILE NAME:	96j250/structures/s96j250pro-cl.dgn	PLOT DATE:	09-JUL-2003
IPARM FILE NAME:	s96j250pr2-cl.i	SURVEY DATE:	10/99
SURVEYED BY:	ORVIS	DRAWN BY:	KMH
SQUAD LEADER:	C. P. WILLIAMS		
BETHEL MILLS DRIVE & TH5 PROFILE		SHEET:	11 OF 47