


**MAINTENANCE OF TRAFFIC NOTES:**

1. TEMPORARY APPROACH TRAFFIC SIGNS SHALL BE ACCORDING TO VERMONT STANDARDS E-107M AND E-100AM UNLESS DETAILED OTHERWISE ON THIS SHEET.
2. FOR ADDITIONAL SIGNING INSTRUCTION SEE VERMONT STANDARDS E-100M, E-100AM, E-101M, E-102M, E-102AM, AND E-106M.

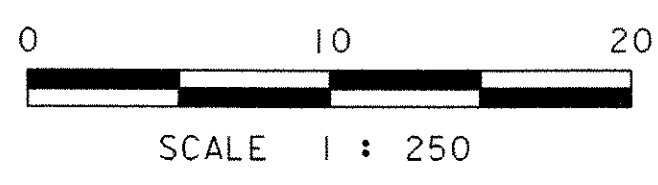

**SIGN LEGEND**  
 ALL SIGNS AND POSTS WILL BE NEW UNLESS OTHERWISE NOTED:

R - REMOVE  
 R&S - REMOVE & SALVAGE  
 S - SALVAGE  
 RET - RETAIN

**DATUM**

VERTICAL NAVD 88  
 HORIZONTAL NAD 83/92

PROJECT: <b>BETHEL</b>	PROJECT NO. : <b>BRF 0241 (33) - C1</b>
DESIGN FILE NAME: 96j250/structures/s96j250bdr-cl.dgn	PLT DATE: 09-JUL-2003
IPARM FILE NAME: s96j250trf1-cl.i	SURVEY DATE: 10/99
SURVEYED BY: ORVIS	DRAWN BY: T. ANDERSON
SQUAD LEADER: C. P. WILLIAMS	SHEET: 12 OF 47
TRAFFIC CONTROL SHEET 1	