

NOT IN ON 12/22/03

BRIDGE CLOSED  
ENTER (RET)

**SIGN LEGEND**  
ALL SIGNS AND POSTS WILL BE NEW UNLESS OTHERWISE NOTED:  
R - REMOVE  
R&S - REMOVE & SALVAGE  
S - SALVAGE  
RET - RETAIN

**DETOUR LEGEND**  
□ - SIGN POSTS  
⊗ - TYPE III BARRICADES (MOD.)  
□ - TYPE III BARRICADES  
▬ - TEMP. TRAFFIC BARRIER

**REMOVE & SALVAGE SIGNS**  
STA 3+190.000 LT  
STA 6+030.600 RT R&S (3)  
STA 6+037.000 RT R&S (3)  
STA 6+050.000 LT R&S (3)  
STA 6+051.500 LT R&S (3)  
STA 3+033, RT R&S (1)  
**SETTING SALVAGED SIGNS**  
STA 3+209.000 RT  
STA 6+007.000 RT (3)  
STA 6+022.300 RT (3)  
STA 6+030.200 LT (3)  
STA 6+032.400 LT (1)  
**SETTING SALVAGED POSTS**  
STA 3+209.000 RT  
STA 6+007.000 RT  
STA 6+022.300 RT  
STA 6+030.200 LT  
STA 6+032.400 LT

**ADD NEW SIGNS**  
STA 3+080.000 LT (2)  
STA 3+209, RT (1)  
**ADD NEW POSTS**  
STA 3+080.000 LT  
600 STOP BAR  
(THS) - STA 6+310.000 LT (13m)  
**LETTER OR SYMBOL**  
STA 6+033.500 LT


**REMOVE SIGNS**  
STA 3+098, LT(R) (1)  
STA 3+190, LT (R) (1)

**CROSSWALK MARKINGS W/DIAGONAL LINES**  
STA 3+028.000 +/-  
(Line up cross walk with Church walk)  
**100 DASHED WHITE LINE**  
STA 3+035.000 LT - STA 3+048.000 LT  
STA 3+176.680 LT - STA 3+210.000 LT  
**100 YELLOW LINE (DOUBLE)**  
STA 3+020.000 ♀ - STA 3+220.000 ♀  
**100 WHITE LINE**  
STA 3+000.000 LT - STA 3+038.000 LT  
STA 3+035.000 LT - THS STA 6+060.000 LT  
STA 3+000.000 RT - STA 3+052.200 RT  
STA 3+067.800 RT - STA 3+220.000 RT  
STA 5+093.820 RT - STA 6+060.000 RT

**MAINTENANCE OF TRAFFIC NOTES:**  
1. TEMPORARY APPROACH TRAFFIC SIGNS SHALL BE ACCORDING TO VERMONT STANDARDS E-107M AND E-100AM UNLESS DETAILED OTHERWISE ON THIS SHEET.  
2. FOR ADDITIONAL SIGNING INSTRUCTION SEE VERMONT STANDARDS E-100M, E-100AM, E-101M, E-102M, E-102AM, AND E-106M.

**DATUM**  
VERTICAL NAVD 88  
HORIZONTAL NAD 83/92

**NOTE:**  
THE RESIDENT ENGINEER SHALL DETERMINE THE FINAL LOCATION OF ALL CROSSWALK MARKINGS AND SIGNS. NEW SIGNS MAY BE ADDED AS REQUIRED. ALL NEW OR SALVAGED SIGNS REQUIRED THAT HAVE NOT BEEN SHOWN ON THE PLANS SHALL BE PAID FOR UNDER THEIR APPROPRIATE PAY ITEMS.

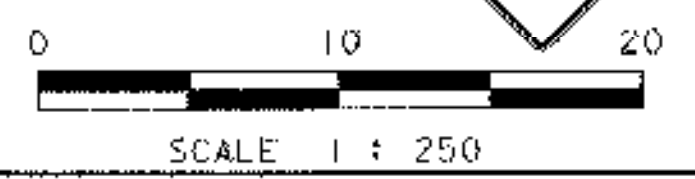

**PROJECT:**  
BETHEL  
DESIGN FILE NAME: 96j250/structures/s96j250br-cl.dgn  
IPARM FILE NAME: s96j250trf2-cl.i  
SURVEYED BY: ORVIS  
SQUAD LEADER: C.P. WILLIAMS  
TRAFFIC SIGN SHEET 2

**PROJECT NO.:**  
BRF 0241 (33) - C1  
PLOT DATE: 09-JUL-2003  
SURVEY DATE: 10/99  
DRAWN BY: T. ANDERSON  
SHEET: 13 OF 47