


DATUM
 VERTICAL NAVD88
 HORIZONTAL NAD83 (92)

NOTE : MATCH THE EXISTING GRADE.
 MATCH THE EXISTING CROSS SLOPES ALONG TRAVEL AND SHOULDER LANES.

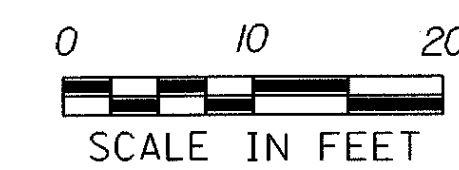

PROJECT: <u>LUDLOW</u>	PROJECT NO.: <u>NH 025-1(38)S</u>
DESIGN FILE NAME: <u>/SODB/97B016/DE076WRK.DGN</u>	PLOT DATE: <u>07-APR-2000</u>
IPARM FILE NAME: <u>DB076X01</u>	SURVEY DATE: <u>09/15/97</u>
SURVEYED BY: <u>ORVIS</u>	DRAWN BY: <u>SQUAD B</u>
SQUAD LEADER: <u>DELLA SANTA</u>	SHEET: <u>19</u> OF <u>31</u>