


136+50

DATUM
 VERTICAL NAVD88
 HORIZONTAL NAD83 (92)

NOTE : MATCH THE EXISTING GRADE.
 MATCH THE EXISTING CROSS SLOPES ALONG TRAVEL AND SHOULDER LANES.

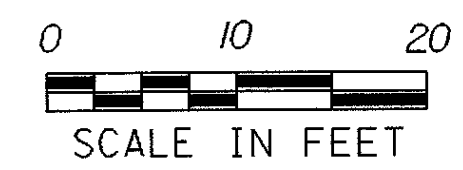

| | | | |
|-------------------|---------------------------|--------------|---------------|
| PROJECT: | LUDLOW | PROJECT NO.: | NH 025-11381S |
| DESIGN FILE NAME: | /S0DB/97B076/DB076WRK.DGN | PLOT DATE: | 07-APR-2000 |
| IPARM FILE NAME: | DB076X02 | SURVEY DATE: | 09/15/97 |
| SURVEYED BY: | ORVIS | DRAWN BY: | SQUAD B |
| SQUAD LEADER: | DELLA SANTA | SHEET: | 20 OF 31 |