


137+00

DATUM  
 VERTICAL NAVD88  
 HORIZONTAL NAD83 (92)

NOTE : MATCH THE EXISTING GRADE.  
 MATCH THE EXISTING CROSS SLOPES ALONG TRAVEL AND SHOULDER LANES.

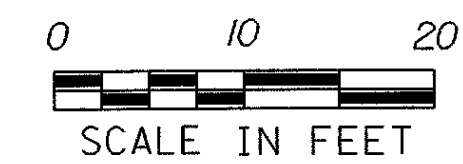

PROJECT:	<u>LUDLOW</u>	PROJECT NO.:	<u>NH 025-11381S</u>
DESIGN FILE NAME:	<u>/SODB/97B076/DB076WRK.DGN</u>	PLOT DATE:	<u>07-APR-2000</u>
IPARM FILE NAME:	<u>DB076X03</u>	SURVEY DATE:	<u>09/15/97</u>
SURVEYED BY:	<u>ORVIS</u>	DRAWN BY:	<u>SQUAD B</u>
SQUAD LEADER:	<u>DELLA SANTA</u>	SHEET:	<u>21 OF 31</u>