


139+50

DATUM  
 VERTICAL NAVD88  
 HORIZONTAL NAD83 (92)

NOTE : MATCH THE EXISTING GRADE.  
 MATCH THE EXISTING CROSS SLOPES ALONG TRAVEL AND SHOULDER LANES.

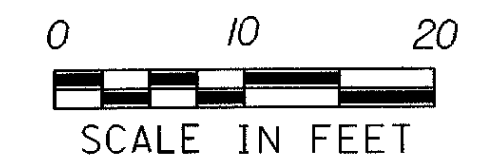

PROJECT: LUDLOW	PROJECT NO.: NH 025-1(38)S
DESIGN FILE NAME: /S0DB/97B076/DB076WRK.DGN	PLOT DATE: 07-APR-2000
IPARM FILE NAME: DB076X08	SURVEY DATE: 09/15/97
SURVEYED BY: ORVIS	DRAWN BY: SQUAD_B
SQUAD LEADER: DELLA SANTA	SHEET: 26 OF 31