


140+00

DATUM  
 VERTICAL NAVD88  
 HORIZONTAL NAD83 (92)

NOTE : MATCH THE EXISTING GRADE.  
 MATCH THE EXISTING CROSS SLOPES ALONG TRAVEL AND SHOULDER LANES.

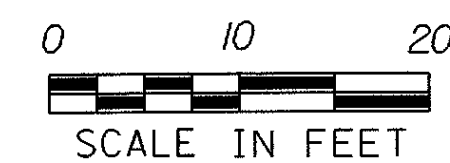

PROJECT:	LUDLOW	PROJECT NO.:	NH 025-K38/S
DESIGN FILE NAME:	/SODB/97B076/DB076WRK.DGN	PLOT DATE:	07-APR-2000
IPARM FILE NAME:	DB076X09	SURVEY DATE:	09/15/97
SURVEYED BY:	ORVIS	DRAWN BY:	SQUAD B
SQUAD LEADER:	DELLA SANTA	SHEET:	27 OF 31