

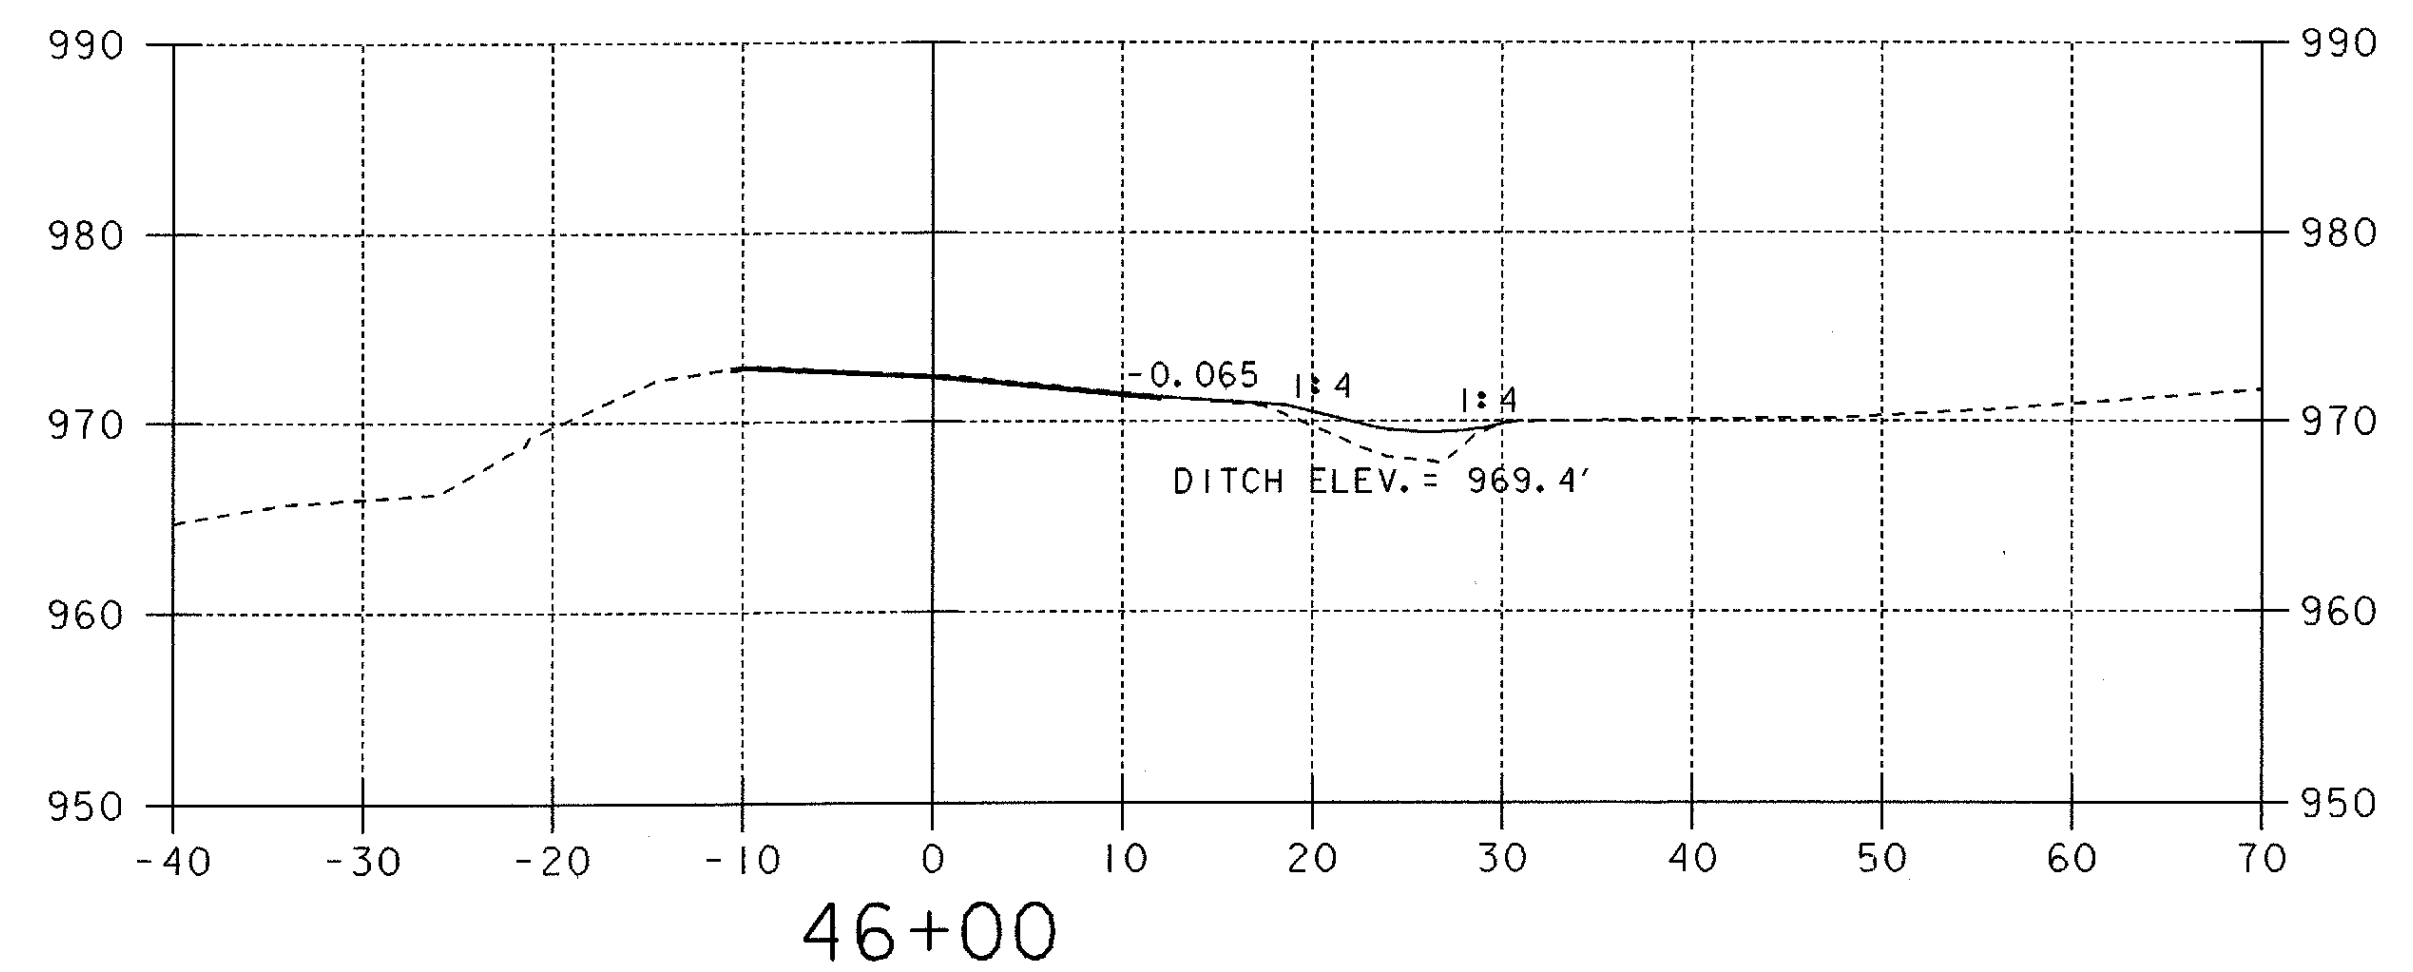
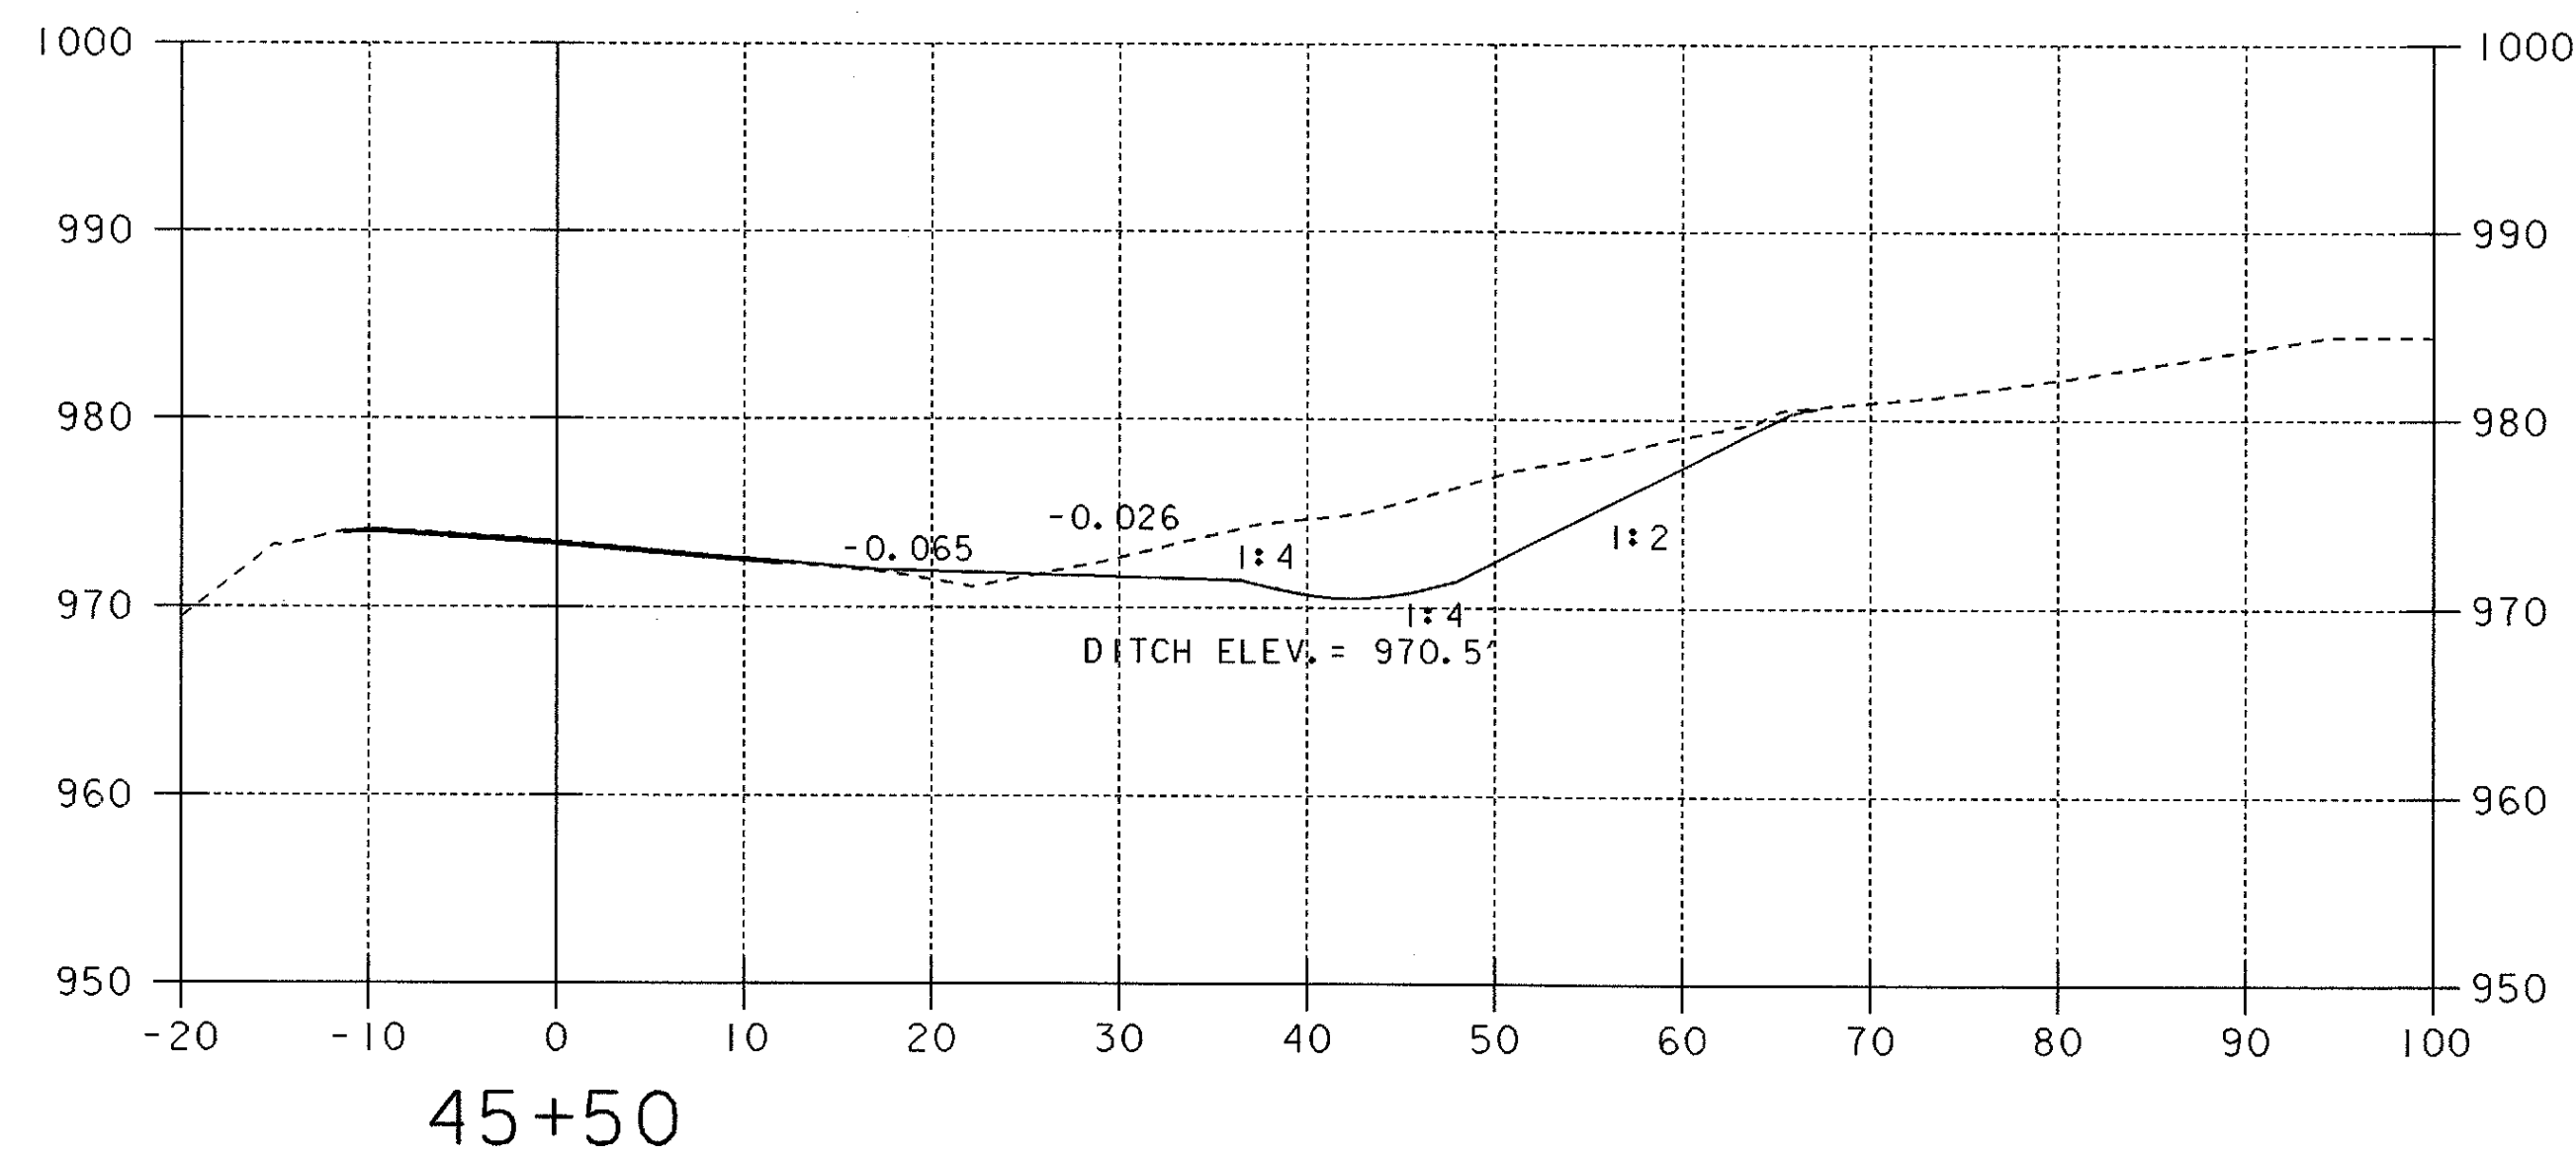


RETAIN EXISTING CULVERT AND D. I.

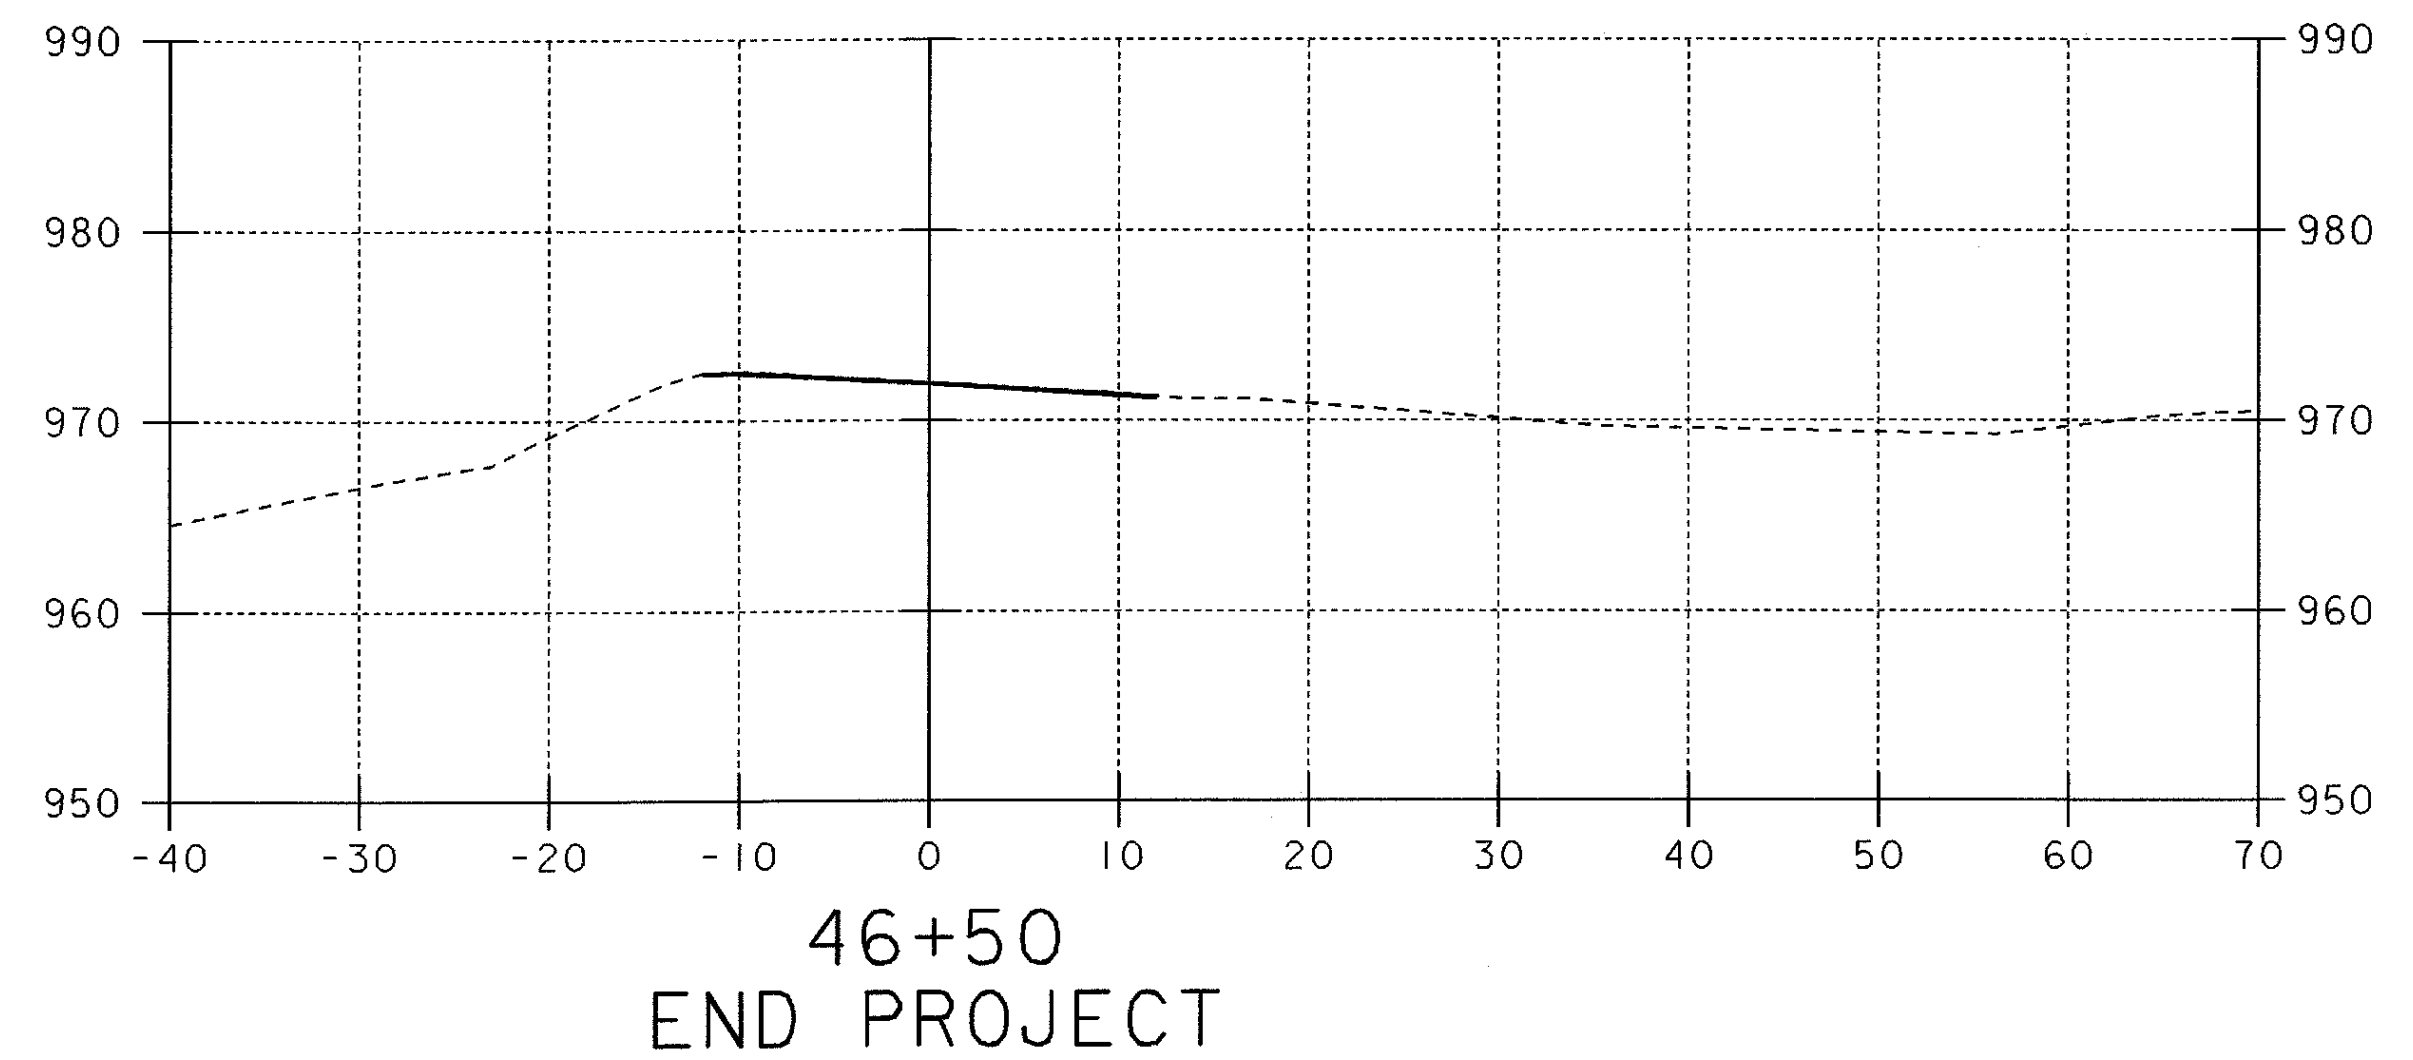

DATUM  
 VERTICAL NAVD88  
 HORIZONTAL NAD83 (92)

NOTE : MATCH THE EXISTING GRADE.  
 MATCH THE EXISTING CROSS SLOPES ALONG TRAVEL AND SHOULDER LANES.

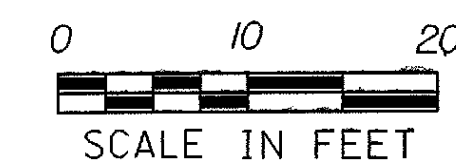

PROJECT:	LUDLOW	PROJECT NO.:	NH 025-1(38)S
DESIGN FILE NAME:	/SODB/97B076/DBOT6WRK.DGN	PLOT DATE:	07-APR-2000
IPARM FILE NAME:	DB076X13	SURVEY DATE:	09/15/97
SURVEYED BY:	ORVIS	DRAWN BY:	SQUAD B
SQUAD LEADER:	DELLA SANTA	SHEET:	31 OF 31