

646.41 DURABLE 100 mm YELLOW LINE  
 (ALL LINES WILL INCLUDE C/L BREAKS FOR TOWN HIGHWAYS) S=SOLID, D=DASHED  
 RUTLAND: STA. I+080.000 - STA. I+620.000 LT S RT S  
 STA. I+316.443 DOUBLE SOLID LT, T-30

646.40 DURABLE 100 mm WHITE LINE  
 (ALL LINES WILL INCLUDE EDGE LINE BREAKS AND RADIUS FOR TOWN HIGHWAYS)  
 RUTLAND: STA. I+080.000 - STA. I+620.000 LT & RT  
 STA. I+080.000 - STA. I+620.000 DASHED LINE 3.6 m RT


646.46 DURABLE 600 mm STOP BAR  
 RUTLAND: STA. I+316.443 LT, T-30  
 646.66 TEMPORARY 600 mm STOP BAR  
 RUTLAND: STA. I+316.443 LT, T-30

675.50 REMOVING SIGNS  
 AS SHOWN - 19  
 675.60 ERECTING SALVAGED SIGNS  
 AS SHOWN - 9

646.61 TEMPORARY 100 mm YELLOW LINE  
 (ALL LINES WILL INCLUDE C/L BREAKS FOR TOWN HIGHWAYS) S=SOLID, D=DASHED  
 RUTLAND: STA. I+080.000 - STA. I+620.000 LT S RT S  
 STA. I+316.443 DOUBLE SOLID LT, T-30

646.60 TEMPORARY 100 mm WHITE LINE  
 (ALL LINES WILL INCLUDE EDGE LINE BREAKS AND RADIUS FOR TOWN HIGHWAYS)  
 RUTLAND: STA. I+080.000 - STA. I+620.000 LT & RT  
 STA. I+080.000 - STA. I+620.000 DASHED LINE 3.6 m RT

646.50 DURABLE LETTER OR SYMBOL  
 RUTLAND: STA. I+316.443 LT, T-30, "S,T,O,P" (4 EA)  
 646.70 TEMPORARY LETTER OR SYMBOL  
 RUTLAND: STA. I+316.443 LT, T-30, "S,T,O,P" (4 EA)

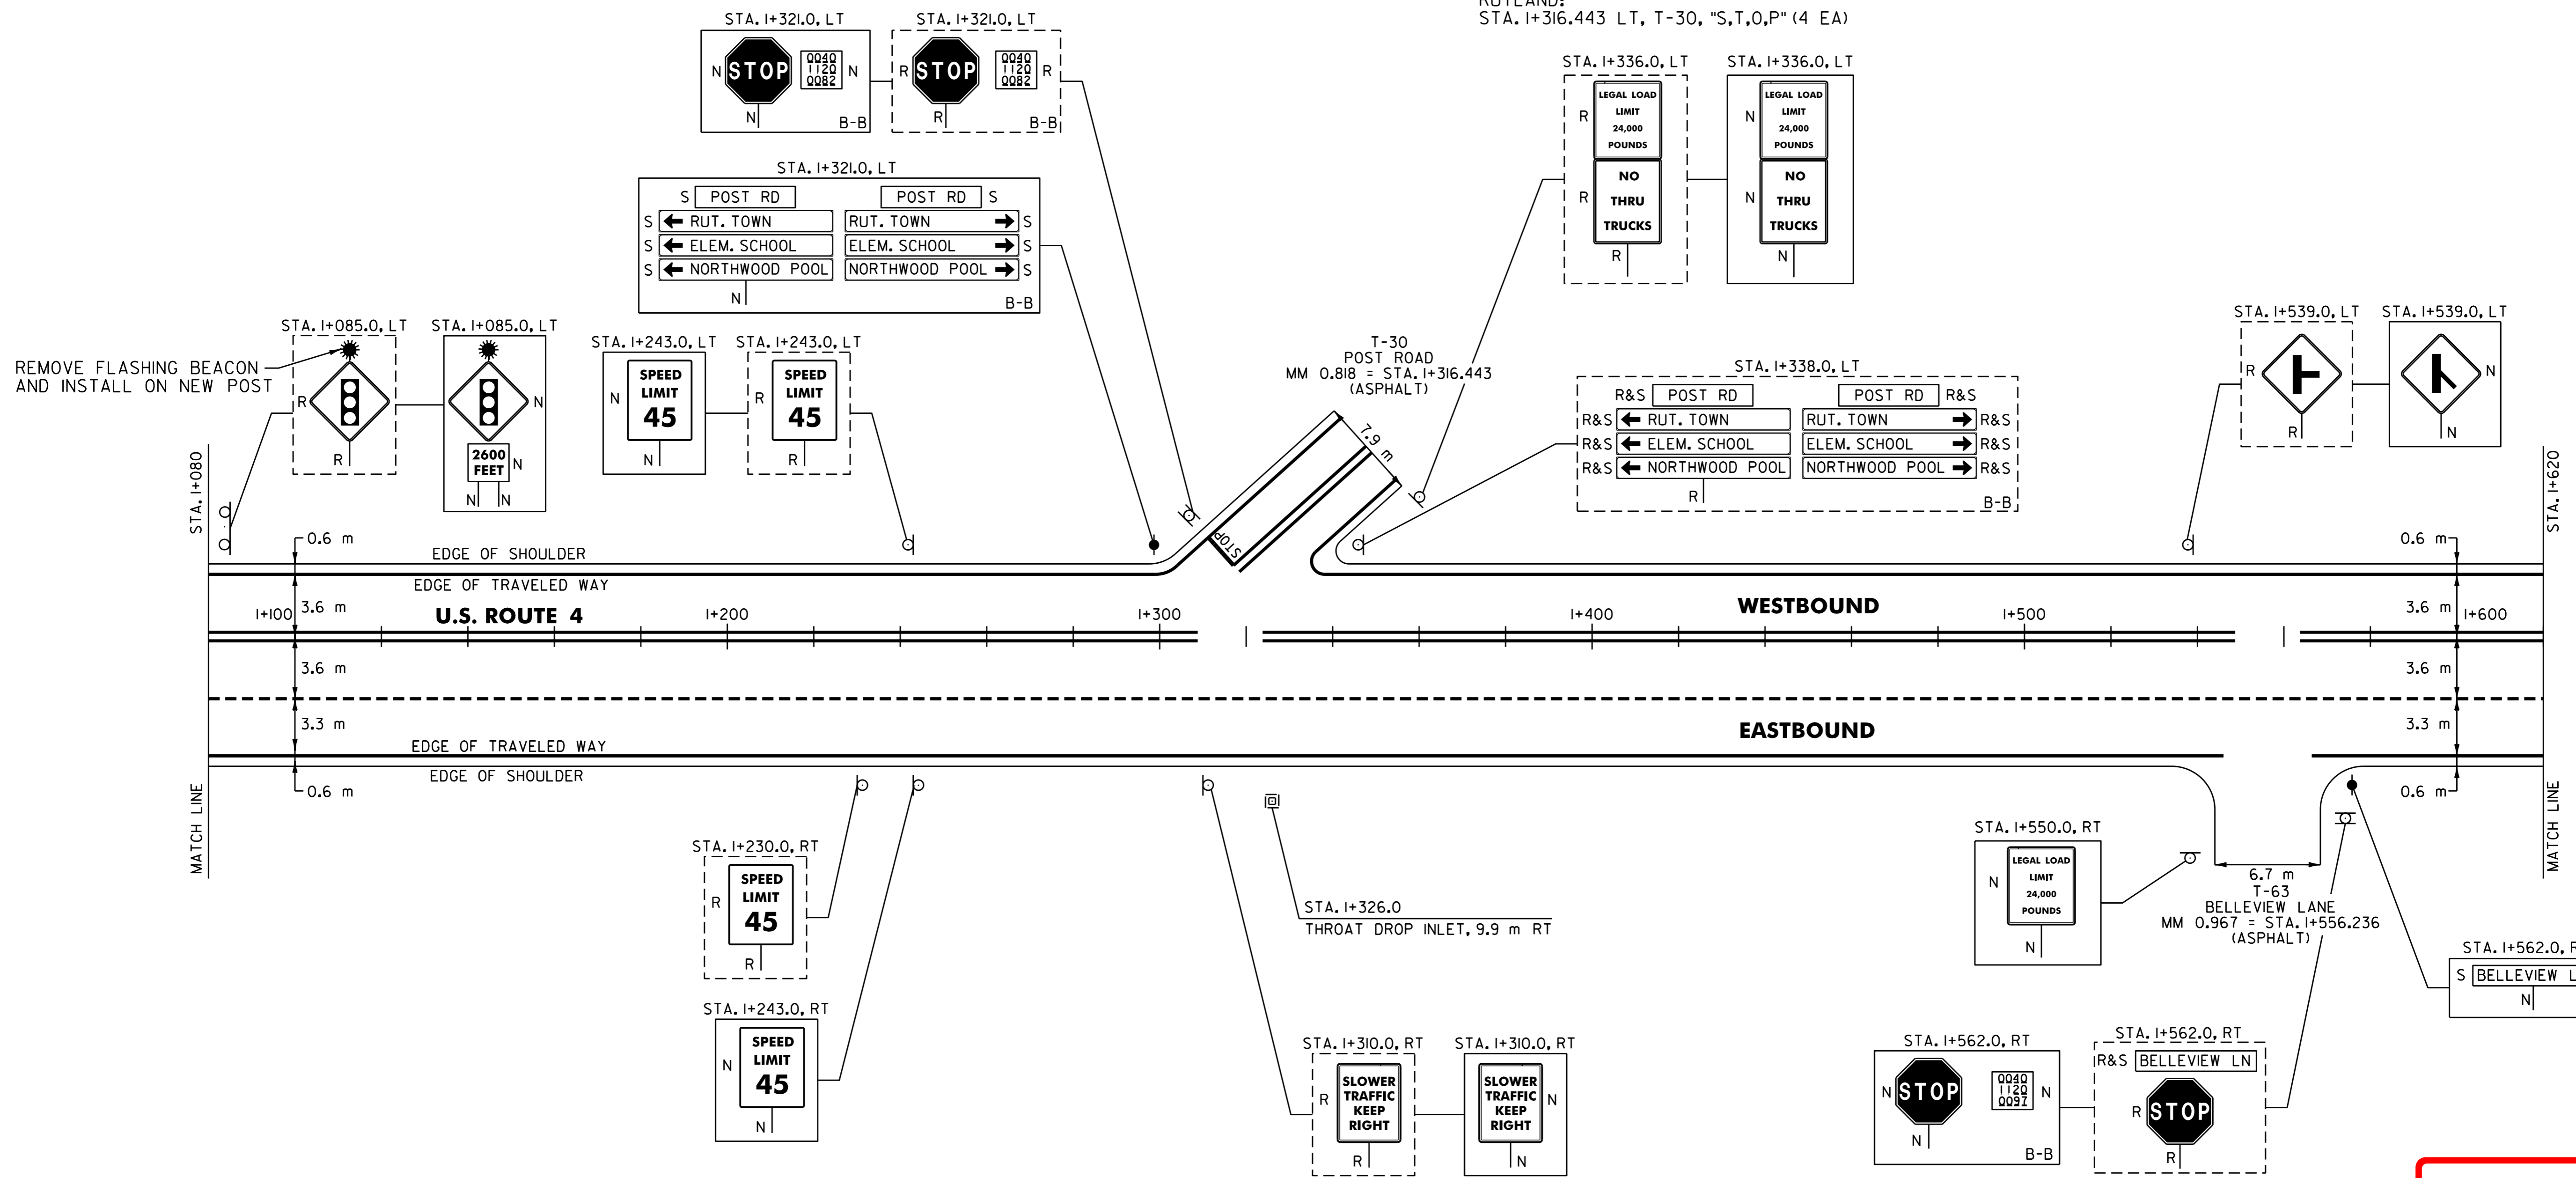

**ARCHIVED  
IN DPR**

**BUILT AS DESIGNED**

NOTE:  
 1. PAVING LIMIT ON ALL TOWN HIGHWAYS SHALL BE MEASURED 8 m BACK FROM U.S. ROUTE 4 EDGE OF SHOULDER UNLESS DENOTED OTHERWISE ON THE PLANS OR AS DIRECTED BY THE RESIDENT ENGINEER.

604.412 REHABING DI'S, CB'S OR MH'S, CLASS I  
 (SEE NOTE 7, SHEET 2 OF 83)  
 RUTLAND: STA. I+326.0 RT  
 678.16 FLASHING BEACON - GROUND MOUNTED (MOD.)  
 AS SHOWN - 1

|            |     |
|------------|-----|
| DATUM      |     |
| VERTICAL   | N/A |
| HORIZONTAL | N/A |

SIGN LEGEND  
 R= REMOVE  
 S= SALVAGE  
 N= NEW  
 RET= RETAIN  
 B-B= BACK TO BACK  
 EXISTING= - - - - -  
 NEW= \_\_\_\_\_

|                                      |                       |                        |      |          |  |
|--------------------------------------|-----------------------|------------------------|------|----------|--|
| <b>PAVING<br/>PROJECT<br/>LAYOUT</b> | SURVEYED BY           | N/A                    | DATE | N/A      |  |
|                                      | DRAWN BY              | C.A.K.                 | DATE | 11/29/99 |  |
|                                      | SQUAD LEADER          | T.P.K.                 |      |          |  |
|                                      | DESIGN FILE NO.       | Zpave/97b160/pb160.dgn |      |          |  |
| IPARM FILE                           | pb160ps3.i            | DATE PLOTTED           | N/A  |          |  |
| PROJ. NAME                           | RUTLAND - KILLINGBORN |                        |      |          |  |
| PROJ. NO.                            | NH_980911S            |                        |      |          |  |
| SHEET                                | 12                    | OF                     | 83   | SHEETS   |  |