


**BR 22 RUTLAND MM 0.478 = STA. 0+769.266**  
NOT TO SCALE

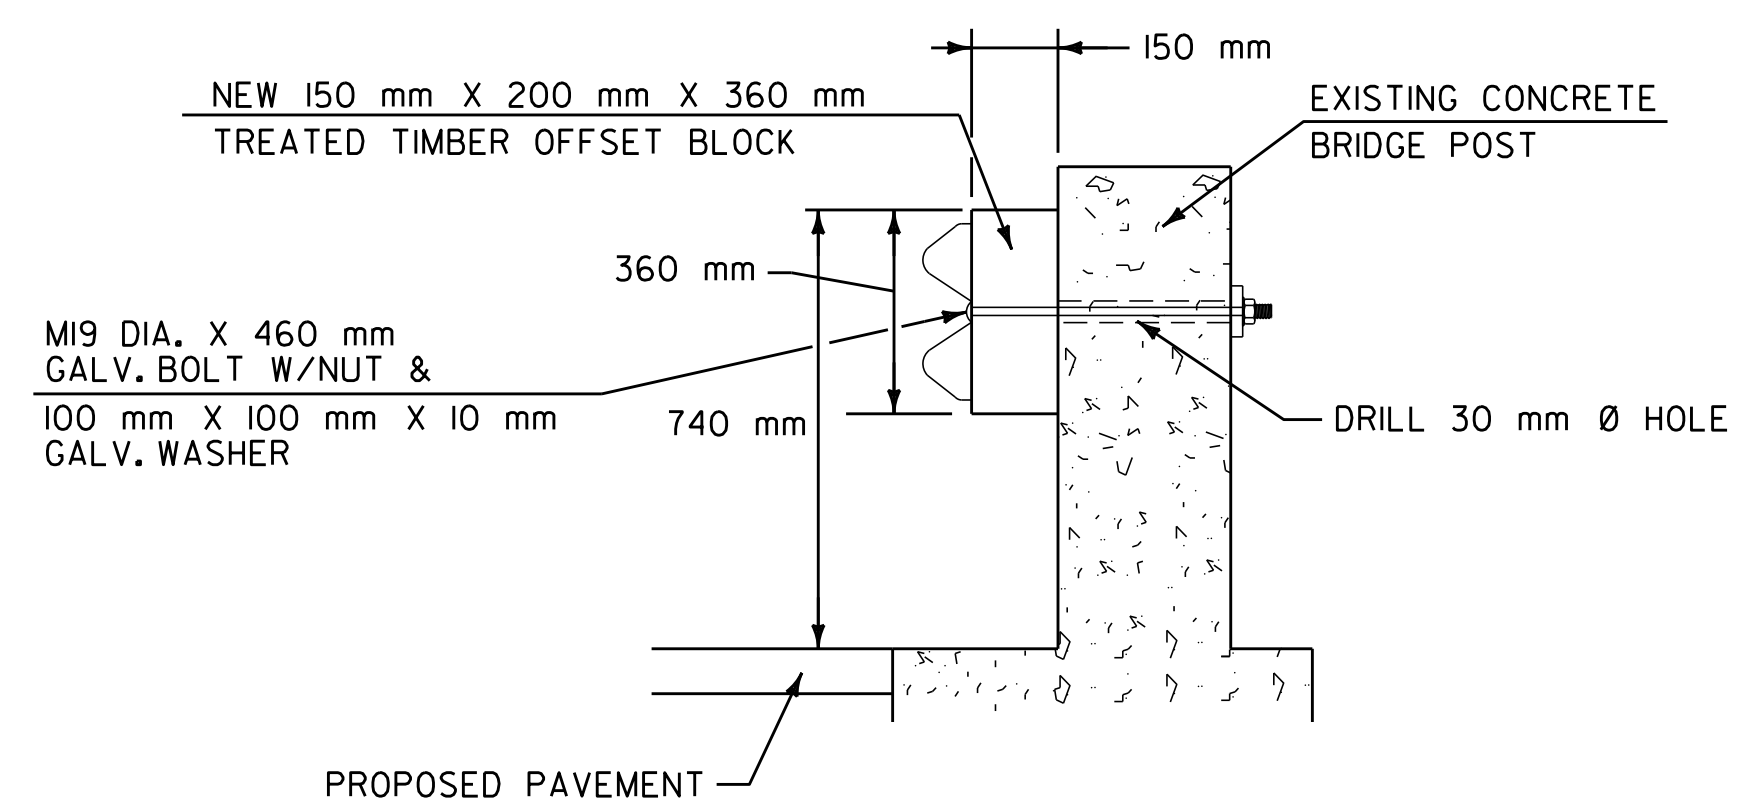

**BR 22 POST DETAIL**  
NOT TO SCALE

NOTE: THIS POST DETAIL ONLY APPLIES TO THE WESTBOUND RUN OF BRIDGE RAIL ON BR 22.

**ARCHIVED  
IN DPR**

DATUM	
VERTICAL	N/A
HORIZONTAL	N/A

<b>BRIDGE DETAIL SHEET 2</b>	SURVEYED BY	N/A	DATE	N/A
	DRAWN BY	C.A.K.	DATE	11/99
	SQUAD LEADER	T.P.K.		
	DESIGN FILE NO.	/pave/97bl60/pbl60.dgn		
	IPARM FILE	pbl60br2.i	DATE PLOTTED	N/A
PROJ. NAME	RUTLAND - KILLINGTON			
PROJ. NO.	NH 9809(1)S			
SHEET	82 OF 83	SHEETS		

DATE/TIME \$\$\$DATE\$\$\$ USER \$\$\$USER\$\$\$