


646.40 DURABLE 4" WHITE LINE (THERMOPLASTIC)
 (ALL LINES WILL INCLUDE EDGE LINE BREAKS AND
 RADIUS FOR TOWN HIGHWAYS)

MIDDLEBURY:
 STA. 308+00.0 - STA. 321+00.0 LT & RT

646.41 DURABLE 4" YELLOW LINE (THERMOPLASTIC)
 (ALL LINES WILL INCLUDE C/L BREAKS FOR
 TOWN HIGHWAYS) S=SOLID, D=DASHED

MIDDLEBURY:
 STA. 308+00.0 - STA. 321+00.0 LT C RT
 S - S

675.50 REMOVING SIGNS
 AS SHOWN - 4

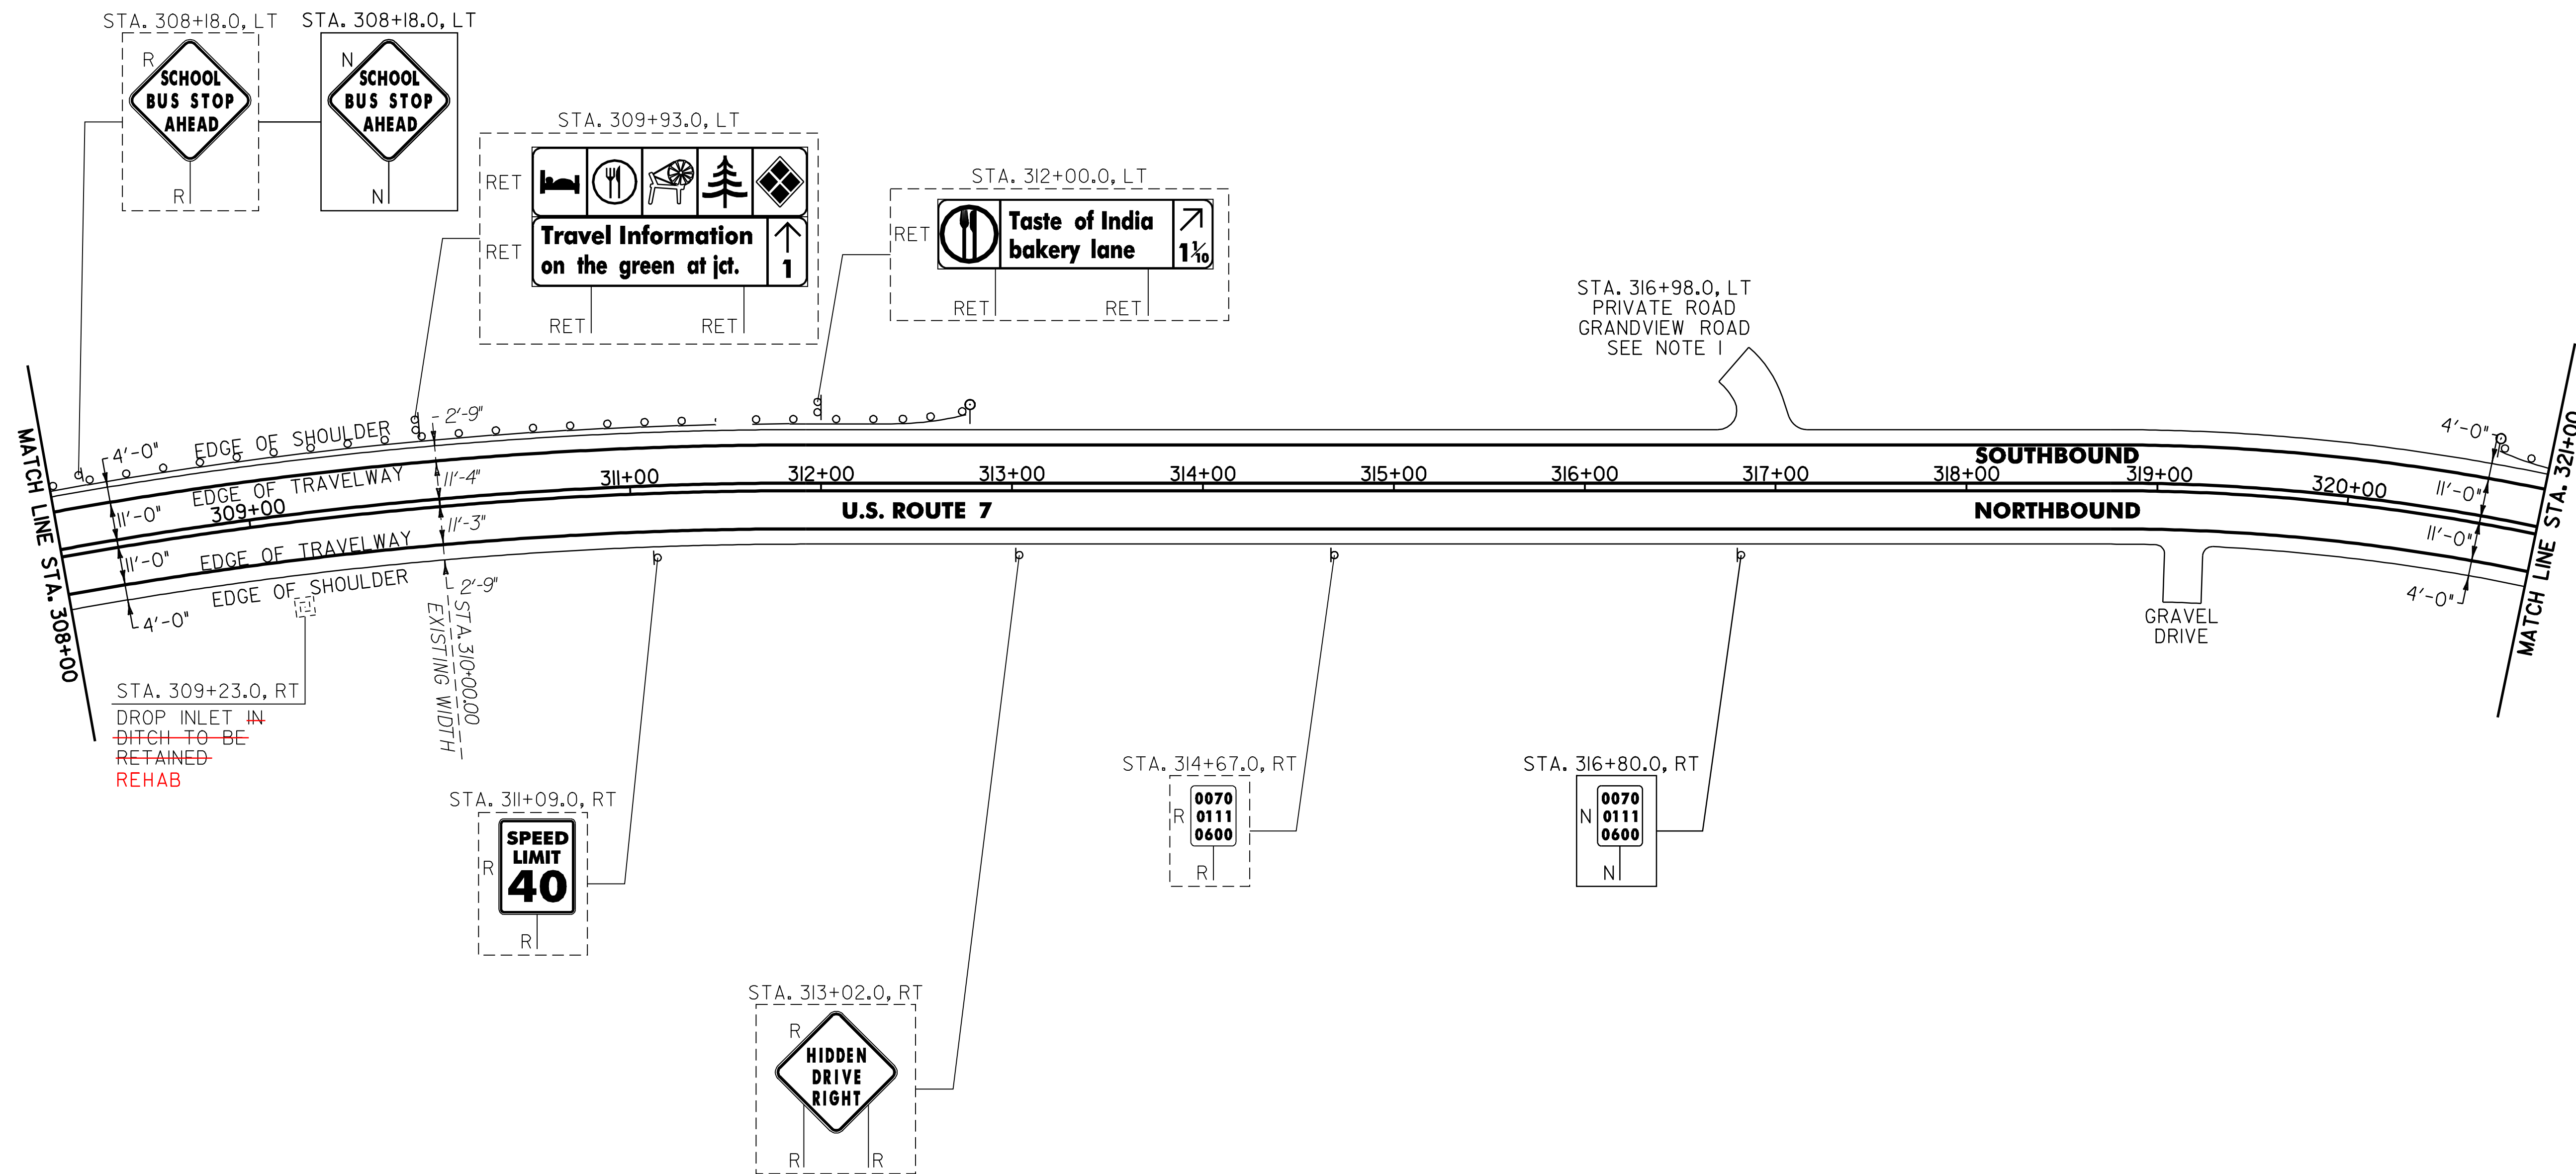

621.20 STEEL BEAM GUARDRAIL (GALVANIZED)

MIDDLEBURY:
 STA. 308+00.0 - STA. 312+38.5 LT (438.5 LF)
 STA. 320+75.0 - STA. 321+00.0 LT (25.0 LF)

621.505 MANUFACTURED TERMINAL SECTION (FLARED)

MIDDLEBURY:
 STA. 312+38.5 - STA. 312+76.0 LT
 STA. 320+37.5 - STA. 320+75.0 LT

621.80 REMOVAL AND DISPOSAL OF GUARDRAIL

MIDDLEBURY:
 STA. 308+00.0 - STA. 312+71.0 LT (471.0 LF)
 STA. 320+38.0 - STA. 321+00.0 LT (62.0 LF)

676.10 DELINEATORS WITH STEEL POSTS

♀ TYPE I WHITE
 MIDDLEBURY:
 STA. 312+76.0 LT
 STA. 320+37.5 LT

NOTE:

1. PROVIDE A 15 FT WIDE, 2' TYPE IIS APRON FOR THE EXISTING PRIVATE ROAD. ANY REQUIRED EXCAVATION SHALL BE PERFORMED AS DIRECTED BY THE RESIDENT ENGINEER AND PAID FOR UNDER ITEM 608.25 ALL PURPOSE EXCAVATOR RENTAL, TYPE I.

NOT TO SCALE

SIGN LEGEND
 R = REMOVE
 S = SALVAGE
 N = NEW
 RET = RETAIN
 B-B = BACK TO BACK
 EXISTING = - - - - -
 NEW = _____

PROJECT LAYOUT SHEET #2

PROJECT NAME: MIDDLEBURY - NEW HAVEN
 PROJECT NUMBER: NH 9813(1)S

FILE NAME: p97b166.dgn
 PROJECT LEADER: D.E.G.
 DESIGNED BY: J.S.P.
 IPARM FILE: pb166102.1

PLOT DATE: \$DATE\$
 DRAWN BY: C.A.K.
 CHECKED BY: D.W.E.
 SHEET 11 OF 63