


646.40 DURABLE 4" WHITE LINE (THERMOPLASTIC)
 (ALL LINES WILL INCLUDE EDGE LINE BREAKS AND
 RADIUS FOR TOWN HIGHWAYS)

NEW HAVEN:
 STA. 101+00.0 - STA. 117+00.0 LT & RT

646.41 DURABLE 4" YELLOW LINE (THERMOPLASTIC)
 (ALL LINES WILL INCLUDE C/L BREAKS FOR
 TOWN HIGHWAYS) S=SOLID, D=DASHED

NEW HAVEN:
 STA. 101+00.0 - STA. 111+00.0 LT C RT
 STA. 101+00.0 - STA. 111+00.0 S - S
 STA. 111+00.0 - STA. 117+00.0 S - D

675.50 REMOVING SIGNS
 AS SHOWN - 4

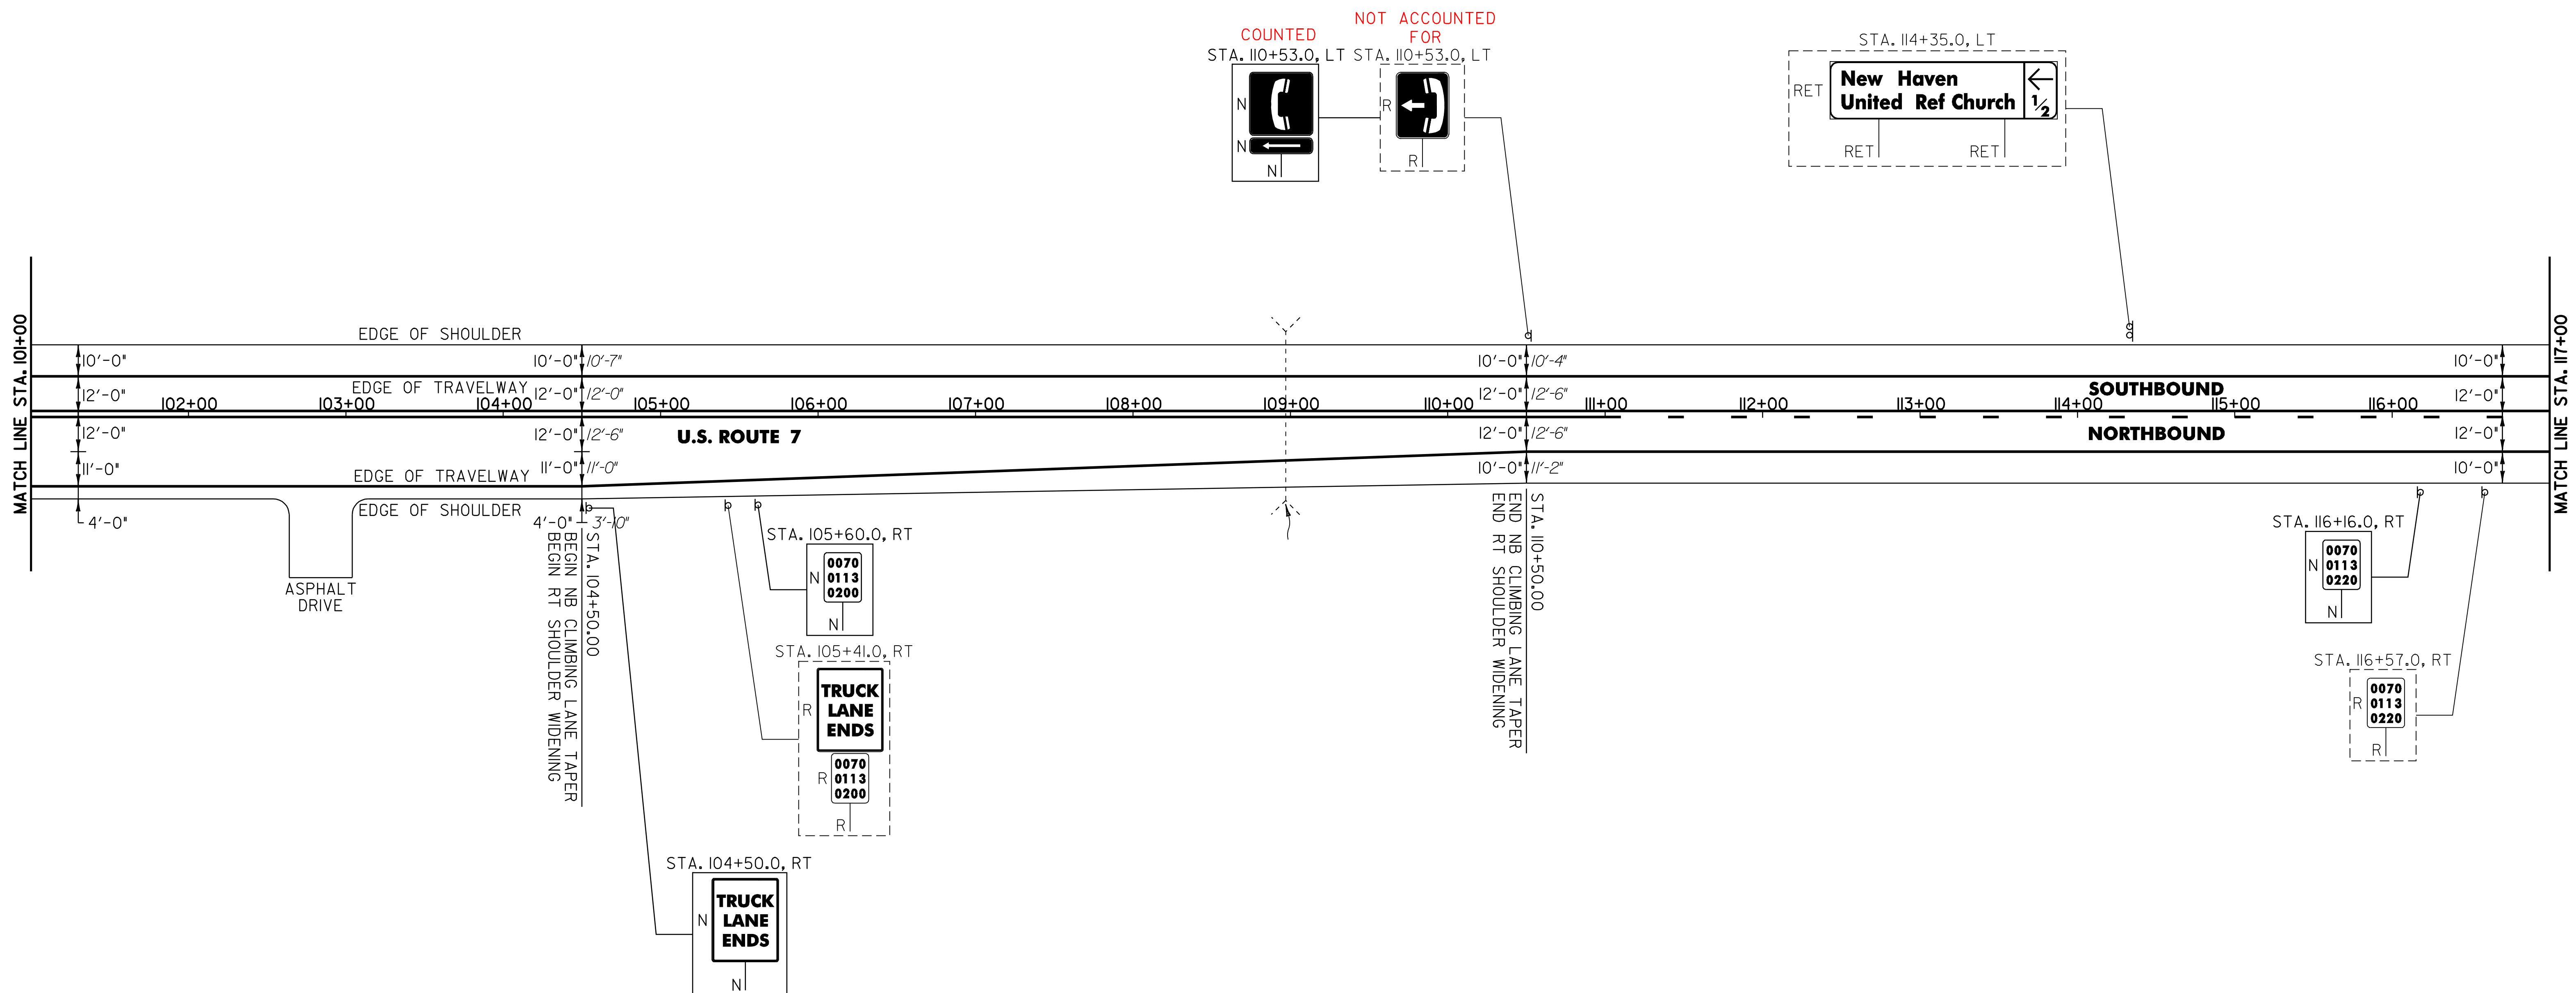

NOT TO SCALE

SIGN LEGEND
 R = REMOVE
 S = SALVAGE
 N = NEW
 RET = RETAIN
 B-B = BACK TO BACK
 EXISTING = - - - - -
 NEW = _____

PROJECT LAYOUT SHEET #14	PROJECT NAME: MIDDLEBURY - NEW HAVEN	PLOT DATE: \$DATE\$
	PROJECT NUMBER: NH 9813(1)S	DRAWN BY: C.A.K.
	FILE NAME: p97b166.dgn	CHECKED BY: D.W.E.
	DESIGNED BY: J.S.P.	SHEET 23 OF 63
	IPARM FILE: pbl66114.i	