


646.40 DURABLE 4" WHITE LINE (THERMOPLASTIC)
 (ALL LINES WILL INCLUDE EDGE LINE BREAKS AND
 RADIUS FOR TOWN HIGHWAYS)

NEW HAVEN:
 STA. 213+00.0 - STA. 229+00.0 LT & RT

646.41 DURABLE 4" YELLOW LINE (THERMOPLASTIC)
 (ALL LINES WILL INCLUDE C/L BREAKS FOR
 TOWN HIGHWAYS) S=SOLID, D=DASHED

NEW HAVEN:
 STA. 213+00.0 - STA. 229+00.0 LT C RT
 - D -

675.50 REMOVING SIGNS
 AS SHOWN - I

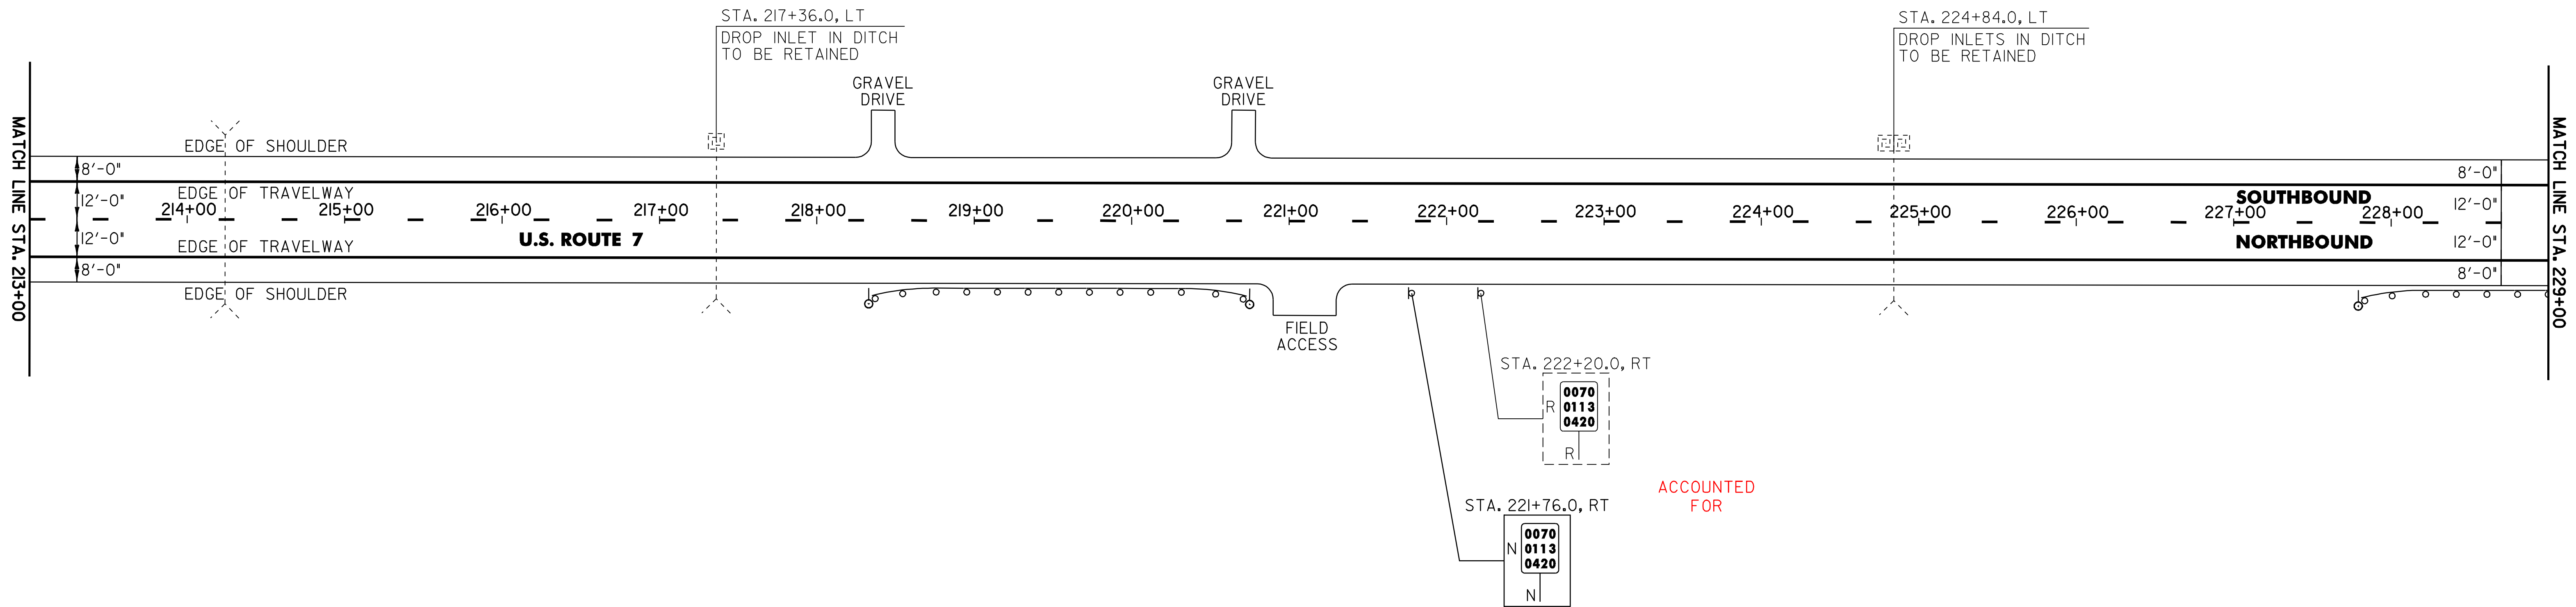

621.20 STEEL BEAM GUARDRAIL (GALVANIZED)

NEW HAVEN:
 STA. 218+72.5 - STA. 220+35.0 RT (162.5 LF)
 STA. 228+22.5 - STA. 229+00.0 RT (77.5 LF)

621.505 MANUFACTURED TERMINAL SECTION (FLARED)

NEW HAVEN:
 STA. 218+35.0 - STA. 218+72.5 RT
 STA. 220+35.0 - STA. 220+72.5 RT
 STA. 227+85.0 - STA. 228+22.5 RT

621.80 REMOVAL AND DISPOSAL OF GUARDRAIL

NEW HAVEN:
 STA. 218+75.0 - STA. 220+75.0 RT (200.0 LF)
 STA. 228+66.0 - STA. 229+00.0 RT (39.0 LF)

676.10 DELINEATORS WITH STEEL POSTS

TYPE I WHITE
 NEW HAVEN:
 STA. 218+35.0 RT
 STA. 220+72.5 RT
 STA. 227+85.0 RT

SIGN LEGEND
 R = REMOVE
 S = SALVAGE
 N = NEW
 RET = RETAIN
 B-B = BACK TO BACK
 EXISTING = -----
 NEW = _____

NOT TO SCALE

**PROJECT
 LAYOUT
 SHEET #21**

PROJECT NAME: MIDDLEBURY - NEW HAVEN
 PROJECT NUMBER: NH 9813(1)S

FILE NAME: p97b166.dgn
 PROJECT LEADER: D.E.G.
 DESIGNED BY: J.S.P.
 IPARM FILE: pbl66121.i

PLOT DATE: \$DATE\$
 DRAWN BY: C.A.K.
 CHECKED BY: D.W.E.
 SHEET 30 OF 63