


TEMPORARY AND DURABLE 100 mm YELLOW LINE
 STA 6+300 TO 7+700
 (WITH CENTERLINE BREAKS FOR TOWN HIGHWAYS)

TEMPORARY AND DURABLE 100 mm WHITE LINE
 STA 6+300 TO 7+700
 (WITH EDGE LINE BREAKS FOR TOWN HIGHWAYS)

REMOVING SIGNS
 5

YIELDING MARKER POST
 STA 6+446 LT
 STA 6+537 LT
 STA 6+733 LT&RT
 STA 7+077 RT
 STA 7+486 LT&RT
 STA 7+538 LT&RT

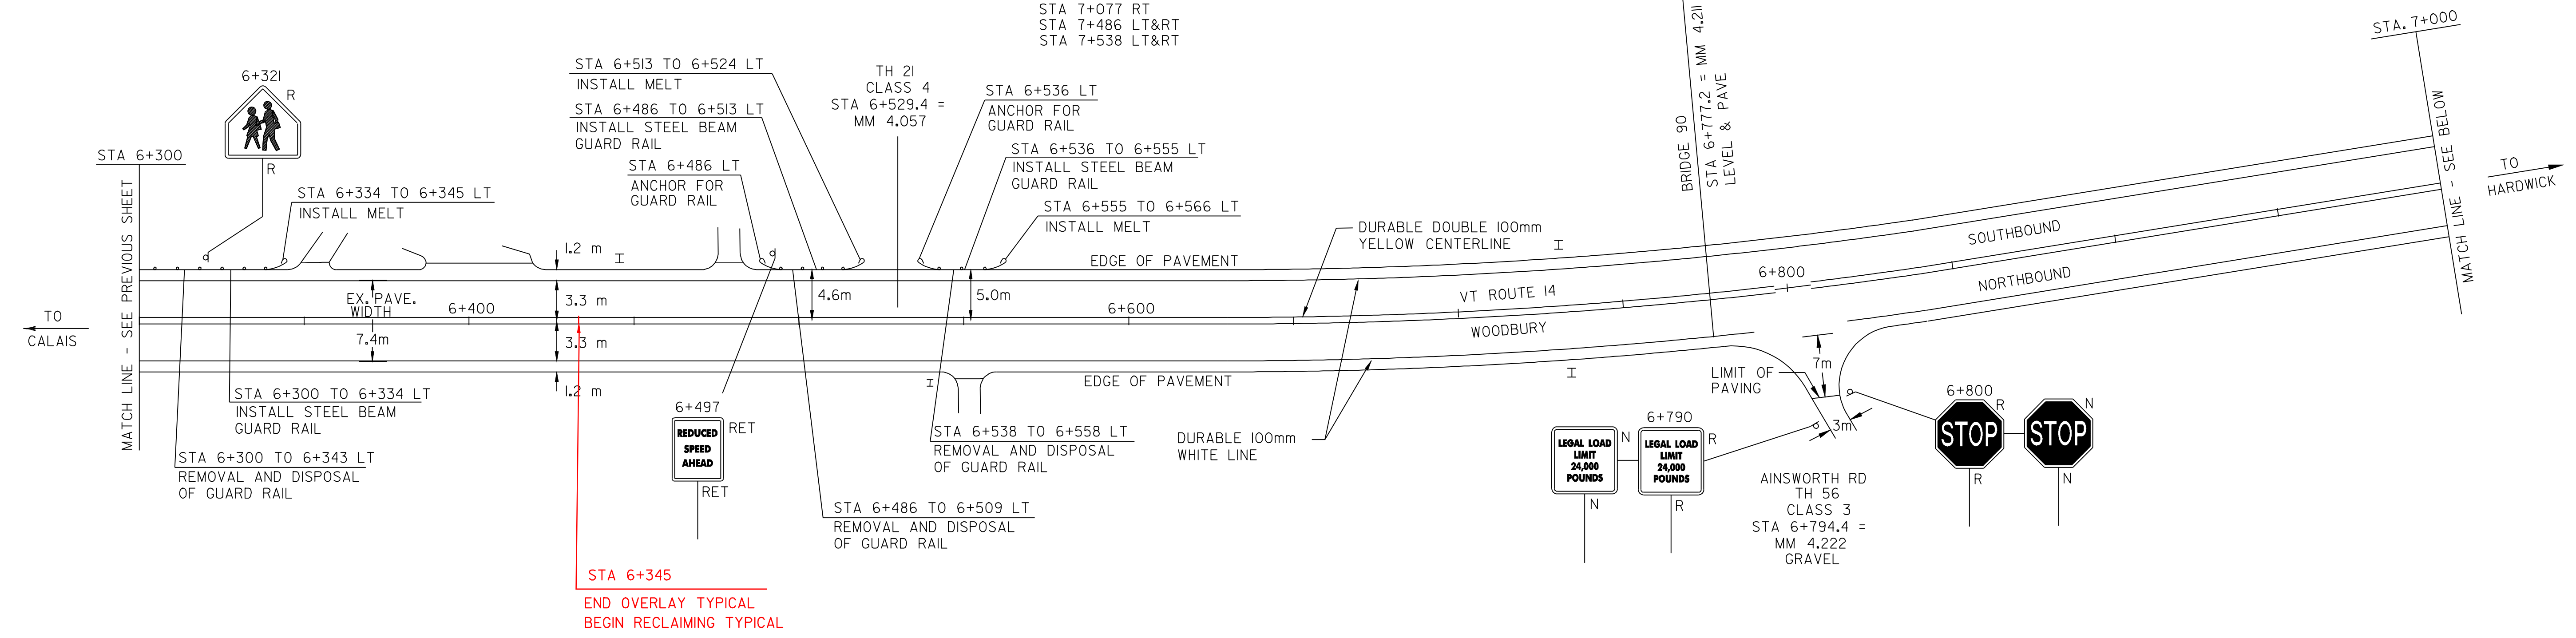

STA 6+345
 END OVERLAY TYPICAL
 BEGIN RECLAIMING TYPICAL


REMOVAL AND DISPOSAL OF GUARD RAIL
 STA 6+300 TO 6+343 LT
 STA 6+486 TO 6+509 LT
 STA 6+538 TO 6+558 LT
 STA 7+587 TO 7+659 LT

STEEL BEAM GUARD RAIL
 STA 6+300 TO 6+334 LT
 STA 6+486 TO 6+513 LT
 STA 6+536 TO 6+555 LT
 STA 7+598 TO 7+659 LT

MODIFIED ECCENTRIC LOADER TERMINAL
 STA 6+334 TO 6+345 LT
 STA 6+513 TO 6+524 LT
 STA 6+555 TO 6+566 LT
 STA 7+659 TO 7+670 LT
 STA 7+587 TO 7+598 LT

ANCHOR FOR GUARD RAIL
 STA 6+486 LT
 STA 6+536 LT
 STA 7+587 LT
 STA 6+345 LT
 STA 6+524 LT

STEEL BEAM GUARD RAIL W/2.4m POSTS (MOD.)
 STA 7+587 TO 7+659 LT
 STA 6+300 TO 6+345 LT
 STA 6+486 TO 6+524 LT
 STA 6+536 TO 6+555 LT

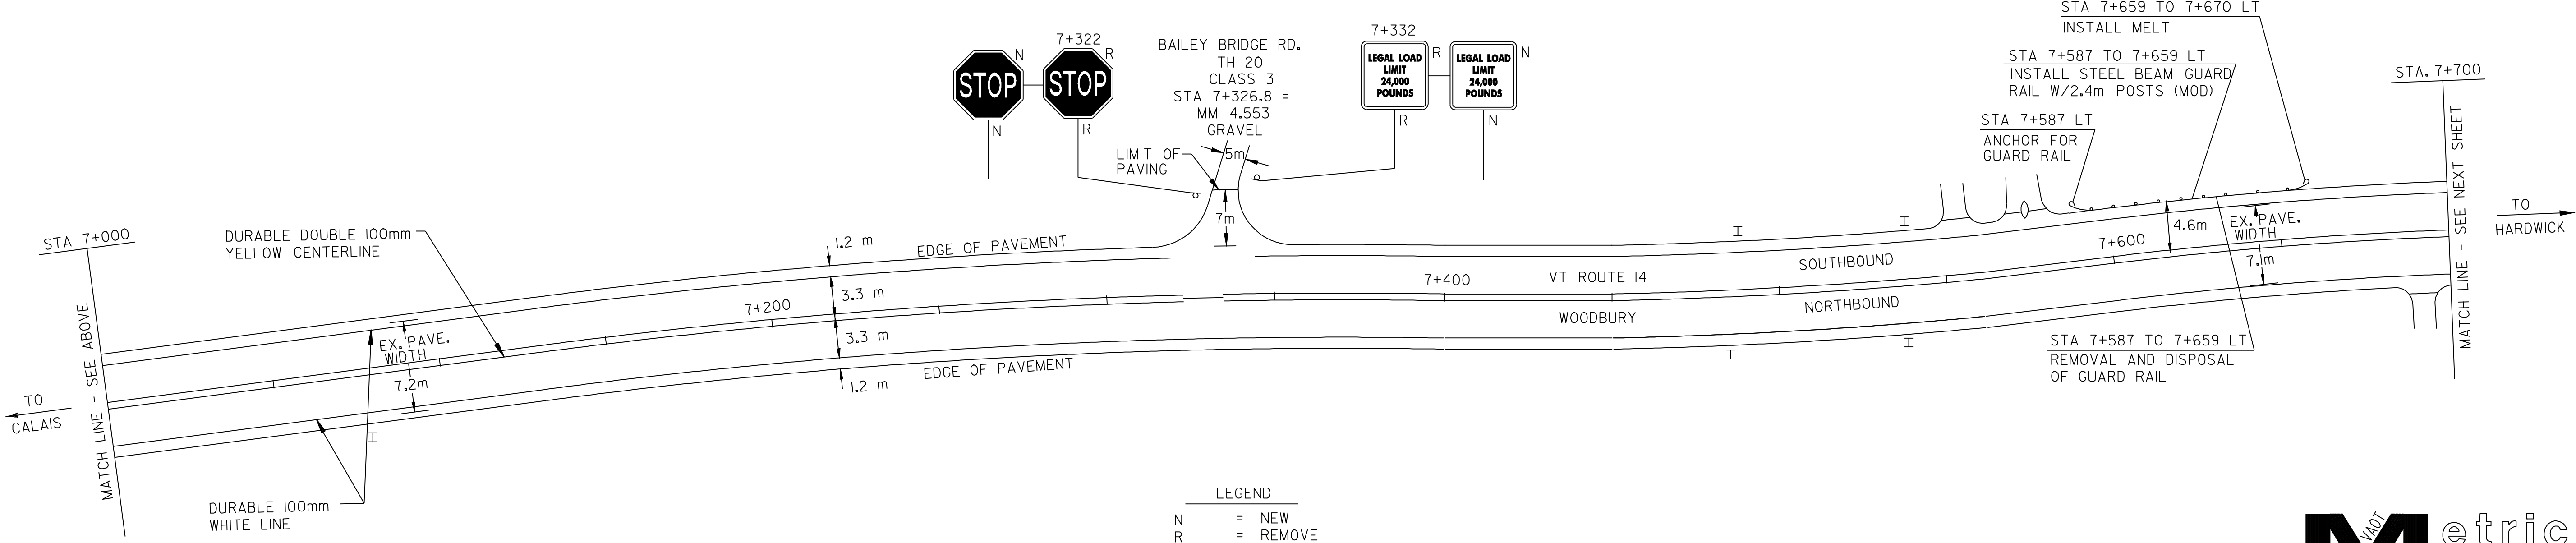


- LEGEND
- N = NEW
 - R = REMOVE
 - R&S = REMOVE & SALVAGE
 - RET = RETAIN
 - B-TO-B = BACK TO BACK
 - ⊕ ⊞ ⊠ = CATCH BASIN/DI
 - ⊞ = EXISTING THROAT DI
 - I = MARKER POST
 - ⊗ = UTILITY POLE
 - UE/T ⊗ = UTIL. POLE W/UNDERGROUND UTIL.
 - = DRIVE
 - ⊙ = MANHOLE

DATUM

VERTICAL	N/A
HORIZONTAL	N/A

ARCHIVED
IN DPR



PAVING
PROJECT
LAYOUT #4

DESIGNED BY	BCE/PJM	DATE	6-98
DRAWN BY	C.E.A., INC.	DATE	6-98
DESIGN FILE NO.	/pave/97b174/pb174.dgn		
PRF FILE	pb174lo4.i	DATE PLOTTED	21-MAR-2008 16:5
PROJ. NAME	WOODBURY - HARDWICK		
PROJ. NO.	STP 9817(1)S		
SHEET	12	OF	25 SHEETS