

TEMPORARY AND DURABLE 100 mm YELLOW LINE
 STA 7+700 TO 7+741 SOLID LT&RT
 STA 7+741 TO 7+966 SOLID LT & DASHED RT
 STA 7+966 TO 7+998 DASHED
 STA 7+998 TO 8+240 DASHED LT & SOLID RT
 STA 8+240 TO 9+100 SOLID LT&RT
 STA 8+572 DOUBLE SOLID RT
 (WITH CENTERLINE BREAKS FOR TOWN HIGHWAYS)

TEMPORARY AND DURABLE 100 mm WHITE LINE
 STA 7+700 TO 9+100 SOLID LT&RT
 (WITH EDGE LINE BREAKS FOR TOWN HIGHWAYS)

YIELDING MARKER POST
 STA 7+900 LT&RT
 STA 8+098 RT
 STA 8+316 LT
 STA 9+005 RT

REMOVING SIGNS
 5

REMOVAL AND DISPOSAL OF GUARD RAIL
 STA 8+282 TO 8+461 RT
 STA 8+503 TO 8+566 LT
 STA 8+700 TO 9+023 LT
 STA 8+907 TO 8+931 RT

STEEL BEAM GUARD RAIL
 8+275 STA 8+264 TO 8+462 RT
 STA 8+503 TO 8+564 LT
 STA 8+706 TO 9+037 LT
 STA 8+900 TO 8+938 RT 9+000




REHABILITATION OF C.B.'S, D.I.'S, OR M.H.'S
 STA 8+707 RT
 STA 8+816 RT

TEMPORARY AND DURABLE 600 mm STOP BAR
 STA 8+572 RT

TEMPORARY AND DURABLE LETTER OR SYMBOL
 STA 8+572 RT "STOP"

MODIFIED ECCENTRIC LOADER TERMINAL
 STA 8+462 TO 8+473 RT
 STA 8+492 TO 8+503 LT
 STA 8+564 TO 8+575 LT
 STA 8+695 TO 8+706 LT
 STA 9+037 TO 9+048 LT
 STA 8+264 TO 8+275 RT

ANCHOR FOR GUARD RAIL
 STA 8+264 RT
 STA 8+900 RT
 STA 8+938 RT
 STA 9+000 RT

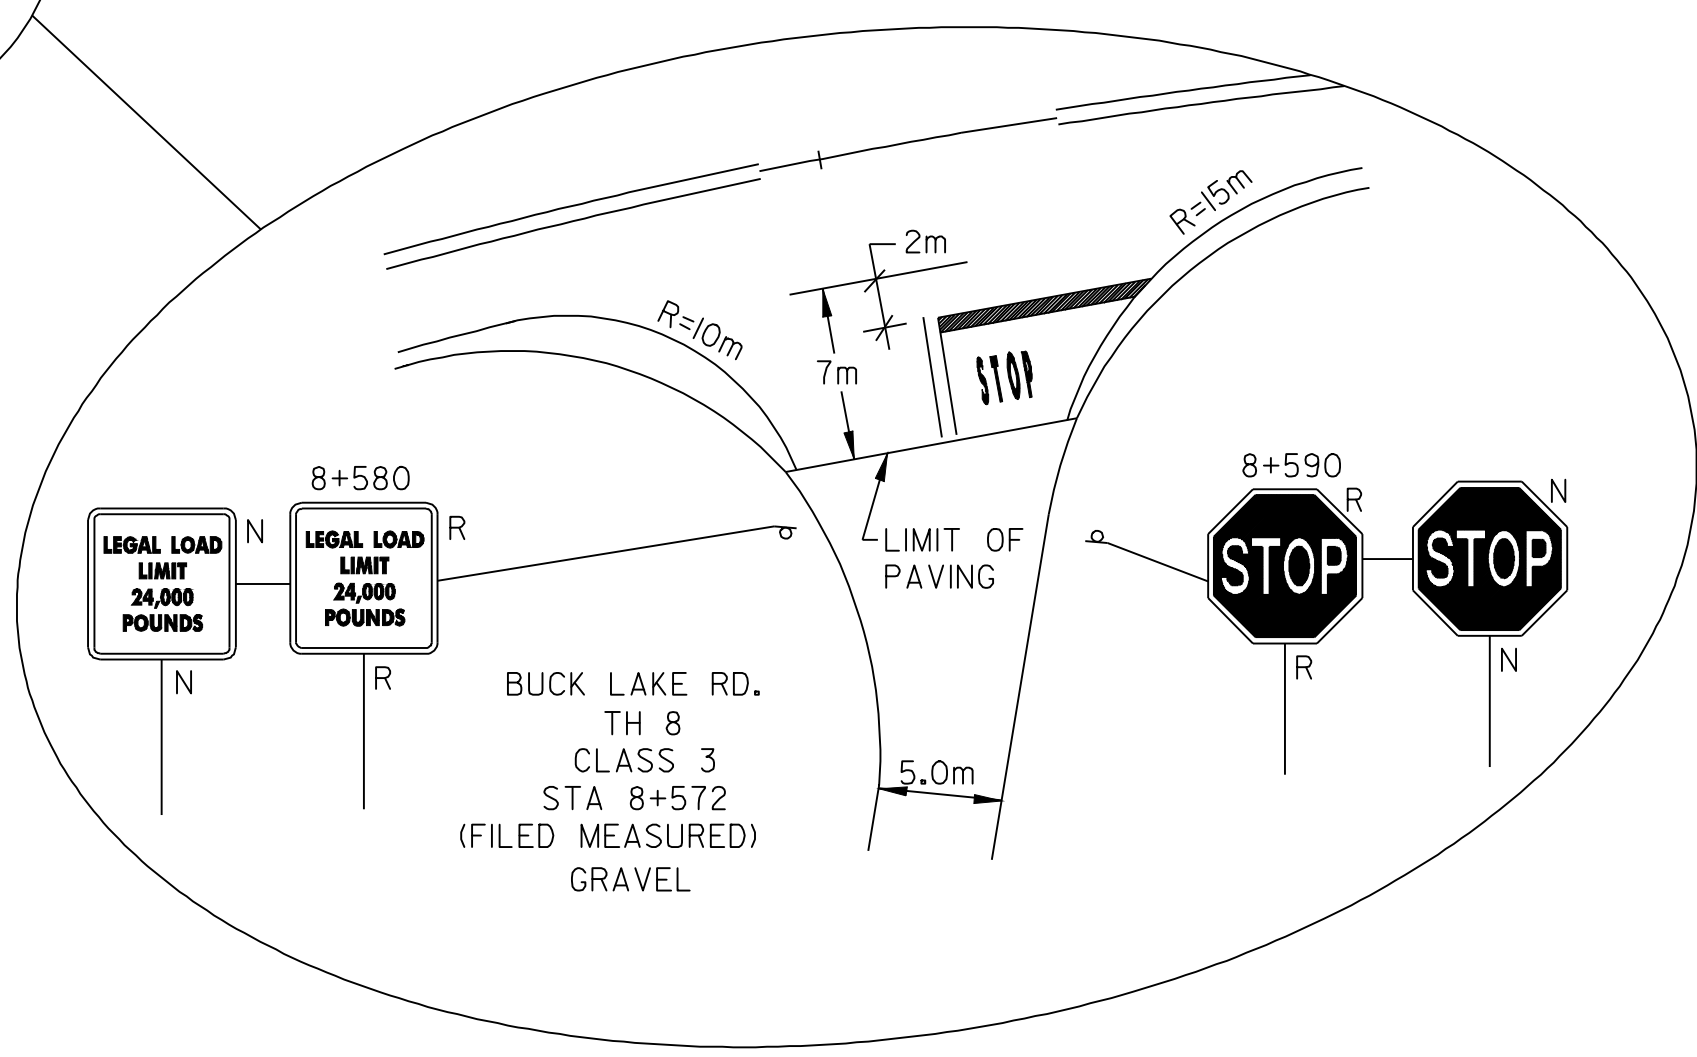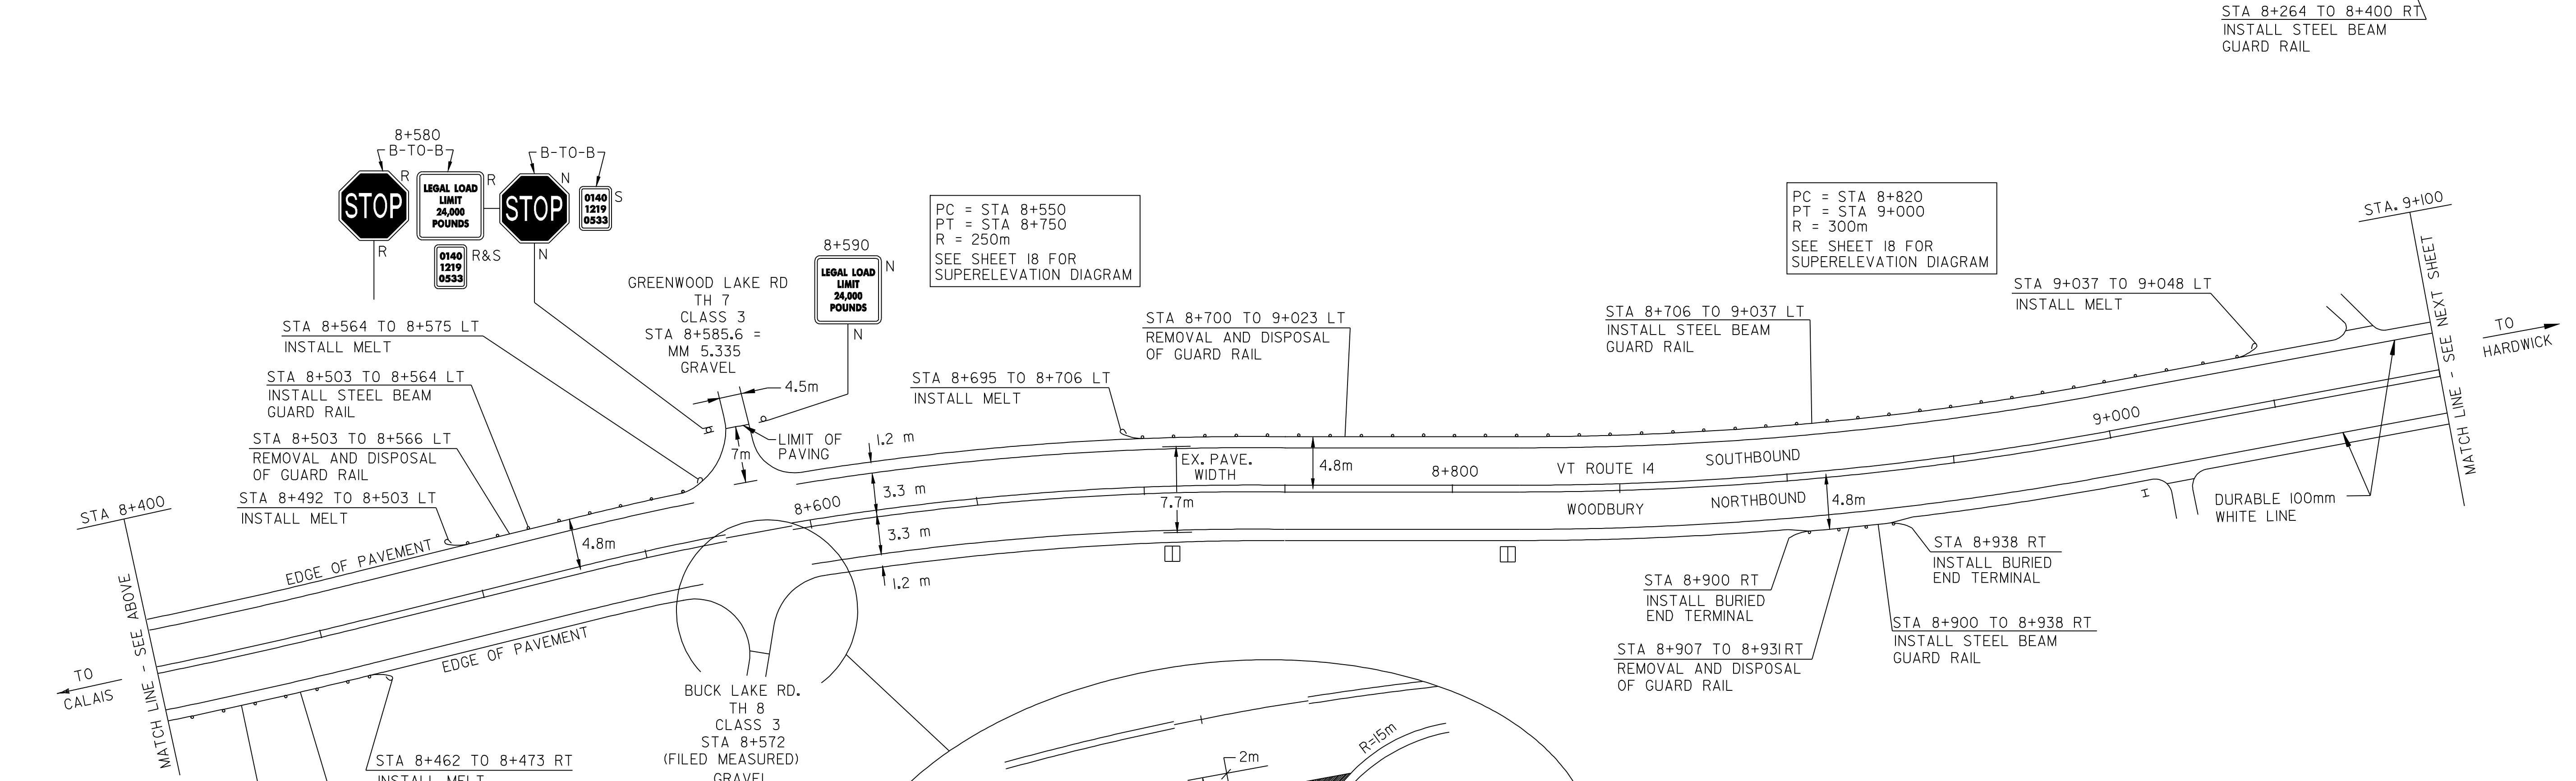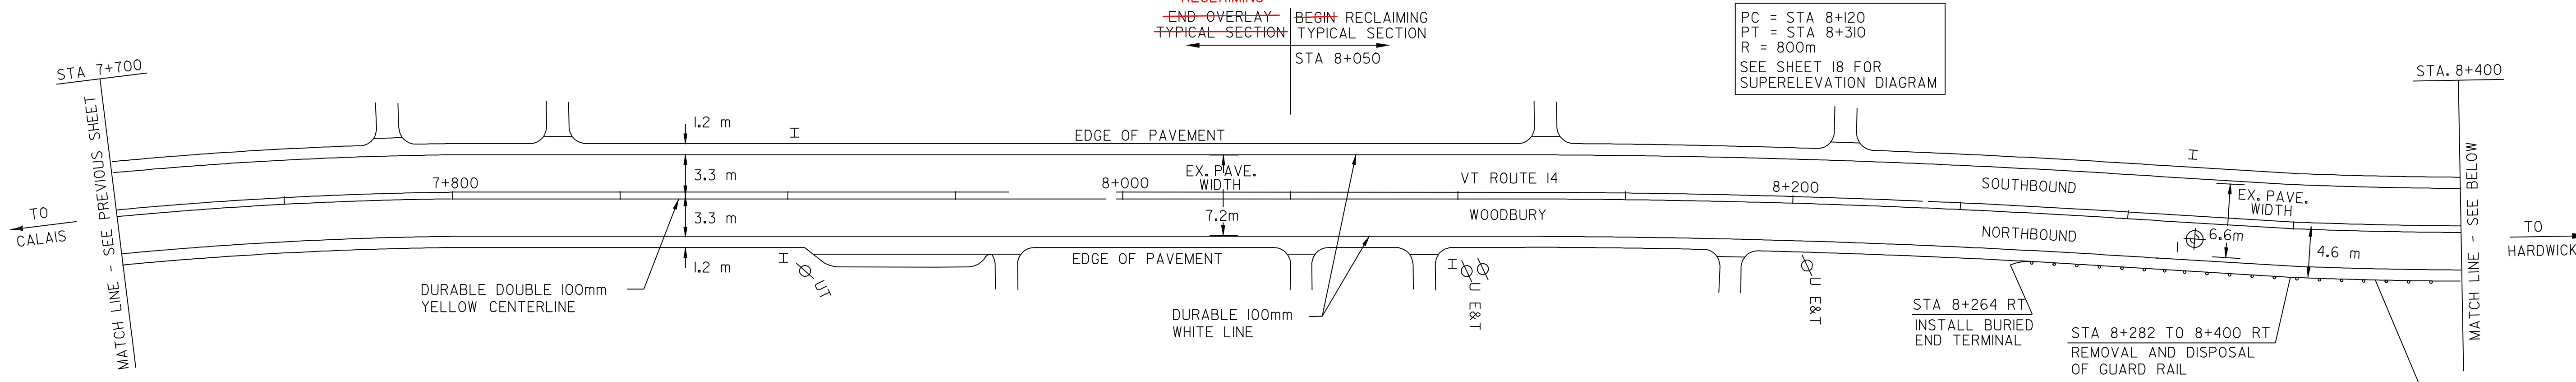

STA 8+400 TO 8+461 RT
 REMOVAL AND DISPOSAL
 OF GUARD RAIL
 STA 8+400 TO 8+462 RT
 INSTALL STEEL BEAM
 GUARD RAIL
 PC = STA 8+390
 PT = STA 8+470
 R = 450m
 SEE SHEET 18 FOR
 SUPERELEVATION DIAGRAM

STA 8+462 TO 8+473 RT
 INSTALL MELT
 STA 8+492 TO 8+503 LT
 INSTALL MELT
 STA 8+503 TO 8+564 LT
 INSTALL STEEL BEAM
 GUARD RAIL
 STA 8+503 TO 8+566 LT
 REMOVAL AND DISPOSAL
 OF GUARD RAIL
 STA 8+564 TO 8+575 LT
 INSTALL MELT
 STA 8+572 RT
 "STOP"

DATUM

VERTICAL	N/A
HORIZONTAL	N/A

PAVEMENT CORES - ⊕

#	TOTAL	PCC	COMMENTS
I	140	NO	140 SOLID BOTTOM STRIPPED

- LEGEND
- N = NEW
 - R = REMOVE
 - R&S = REMOVE & SALVAGE
 - S = SALVAGE SIGN
 - RET = RETAIN
 - ⊕ = MANHOLE
 - ⊗ = UTILITY POLE
 - ⊠ = CATCH BASIN/DI
 - ⊡ = EXISTING THROAT DI
 - ⊞ = MARKER POST
 - ⊞ = DRIVE

**ARCHIVED
IN DPR**



PAVING PROJECT LAYOUT #5

DESIGNED BY	BCE/PJM	DATE	6-98
DRAWN BY	C.E.A., INC.	DATE	6-98
DESIGN FILE NO.	/pave/97bl74/pbl74.dgn		
PRF FILE	pbl74lo5.i	DATE PLOTTED	21-MAR-2008 16:55
PROJ. NAME	WOODBURY - HARDWICK		
PROJ. NO.	STP 9817(1)S		
SHEET	13	OF	25 SHEETS