

TEMPORARY AND DURABLE 100 mm YELLOW LINE
 STA 9+100 TO 10+500
 SOLID LT&RT

TEMPORARY AND DURABLE 100 mm WHITE LINE
 STA 9+100 TO 10+500
 SOLID LT&RT

REMOVAL AND DISPOSAL OF GUARD RAIL
 STA 9+100 TO 9+521RT
 STA 9+562 TO 9+640 RT
 STA 9+862 TO 9+926 RT
 STA 10+021 TO 10+125 LT
 STA 10+064 TO 10+119 RT
 (PARTIAL 129.5 M)
 (PARTIAL 26.7 M)

STEEL BEAM GUARD RAIL
 STA 9+111 TO 9+548 RT 9+537
 STA 9+569 TO 9+641 RT
 STA 9+862 TO 9+927 RT 9+959
 STA 10+019 TO 10+137 LT 10+126
 STA 10+074 TO 10+120 RT
 STA 10+281 TO 10+330 LT


YIELDING MARKER POST
 STA 9+635 LT
 ANCHOR FOR GUARD RAIL
 STA 9+548 RT
 STA 10+137 LT
 STA 10+330 LT

STEEL BEAM GUARD RAIL W/2.4m POSTS (MOD.)
 STA 9+111 TO 9+537 RT (PARTIAL 282 M)
 STA 9+862 TO 9+959 RT (PARTIAL 62.6 M)

REMOVAL AND DISPOSAL OF GUIDE POSTS
 STA 10+063 RT - 1

MODIFIED ECCENTRIC LOADER TERMINAL
 STA 9+100 TO 9+111 RT
 STA 9+558 TO 9+569 RT
 STA 9+641 TO 9+652 RT
 STA 9+851 TO 9+862 RT
 STA 9+927 TO 9+938 RT
 STA 9+959 TO 9+970 RT
 STA 10+008 TO 10+019 LT
 STA 10+063 TO 10+074 RT
 STA 10+120 TO 10+131 RT
 STA 9+537 TO 9+548 RT
 STA 10+126 TO 10+137 LT
 STA 10+270 TO 10+281 LT
 STA 10+351 TO 10+362 RT
 STA 10+370 TO 10+381 RT

REMOVING AND RESET GUARD RAIL
 STA 10+200 TO 10+362 RT
 STA 10+370 TO 10+500 RT

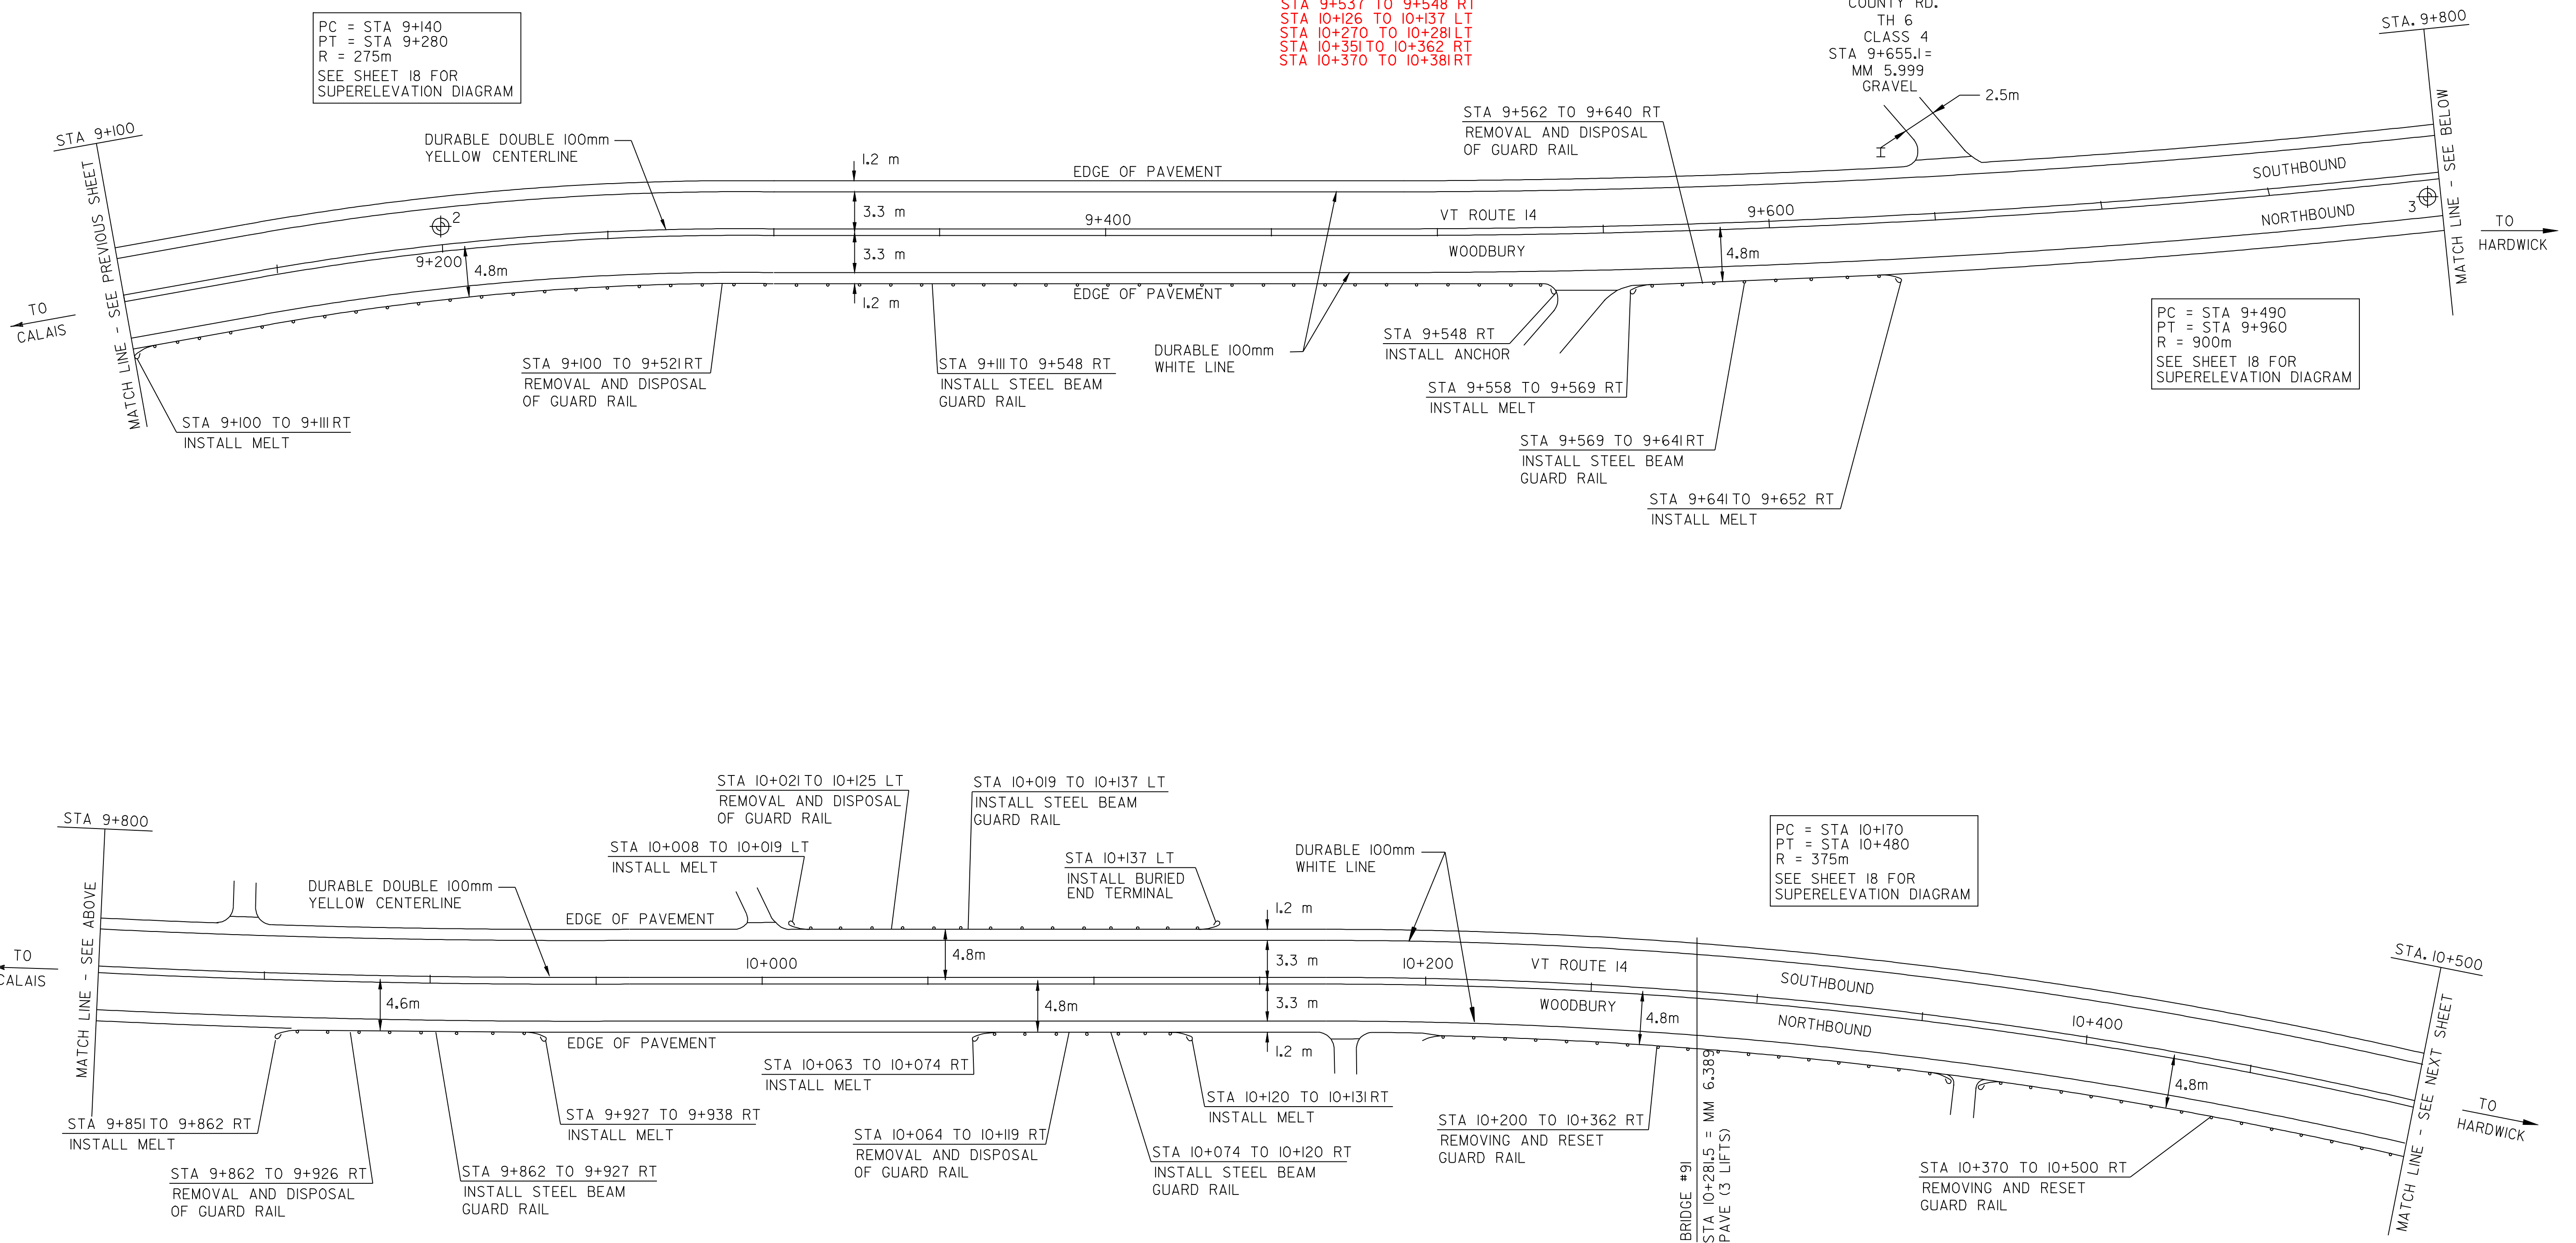

PC = STA 9+140
 PT = STA 9+280
 R = 275m
 SEE SHEET 18 FOR SUPERELEVATION DIAGRAM

PC = STA 9+490
 PT = STA 9+960
 R = 900m
 SEE SHEET 18 FOR SUPERELEVATION DIAGRAM

PC = STA 10+170
 PT = STA 10+480
 R = 375m
 SEE SHEET 18 FOR SUPERELEVATION DIAGRAM

DATUM

VERTICAL	N/A
HORIZONTAL	N/A

PAVEMENT CORES - ⊕

#	TOTAL DEPTH (mm)	PCC	COMMENTS
2	90	NO	90 SOLID BOTTOM SLIGHTLY STRIPPED
3	85	NO	85 SOLID BOTTOM SLIGHTLY STRIPPED

- LEGEND
- N = NEW
 - R = REMOVE
 - R&S = REMOVE & SALVAGE
 - S = SALVAGE SIGN
 - RET = RETAIN
 - ⊕ = MANHOLE
 - ⊗ = UTILITY POLE
 - ⊠ = CATCH BASIN/DI
 - H = MARKER POST
 - = DRIVE

**ARCHIVED
IN DPR**

PAVING PROJECT LAYOUT #6

DESIGNED BY	BCE/PJM	DATE	6-98
DRAWN BY	C.E.A., INC.	DATE	6-98
DESIGN FILE NO.	/pave/97b174/pb174.dgn		
PRF FILE	pbi74lo6.i	DATE PLOTTED	21-MAR-2008 16:53
PROJ. NAME	WOODBURY - HARDWICK		
PROJ. NO.	STP 9817(1)S		
SHEET	14	OF	25 SHEETS

