

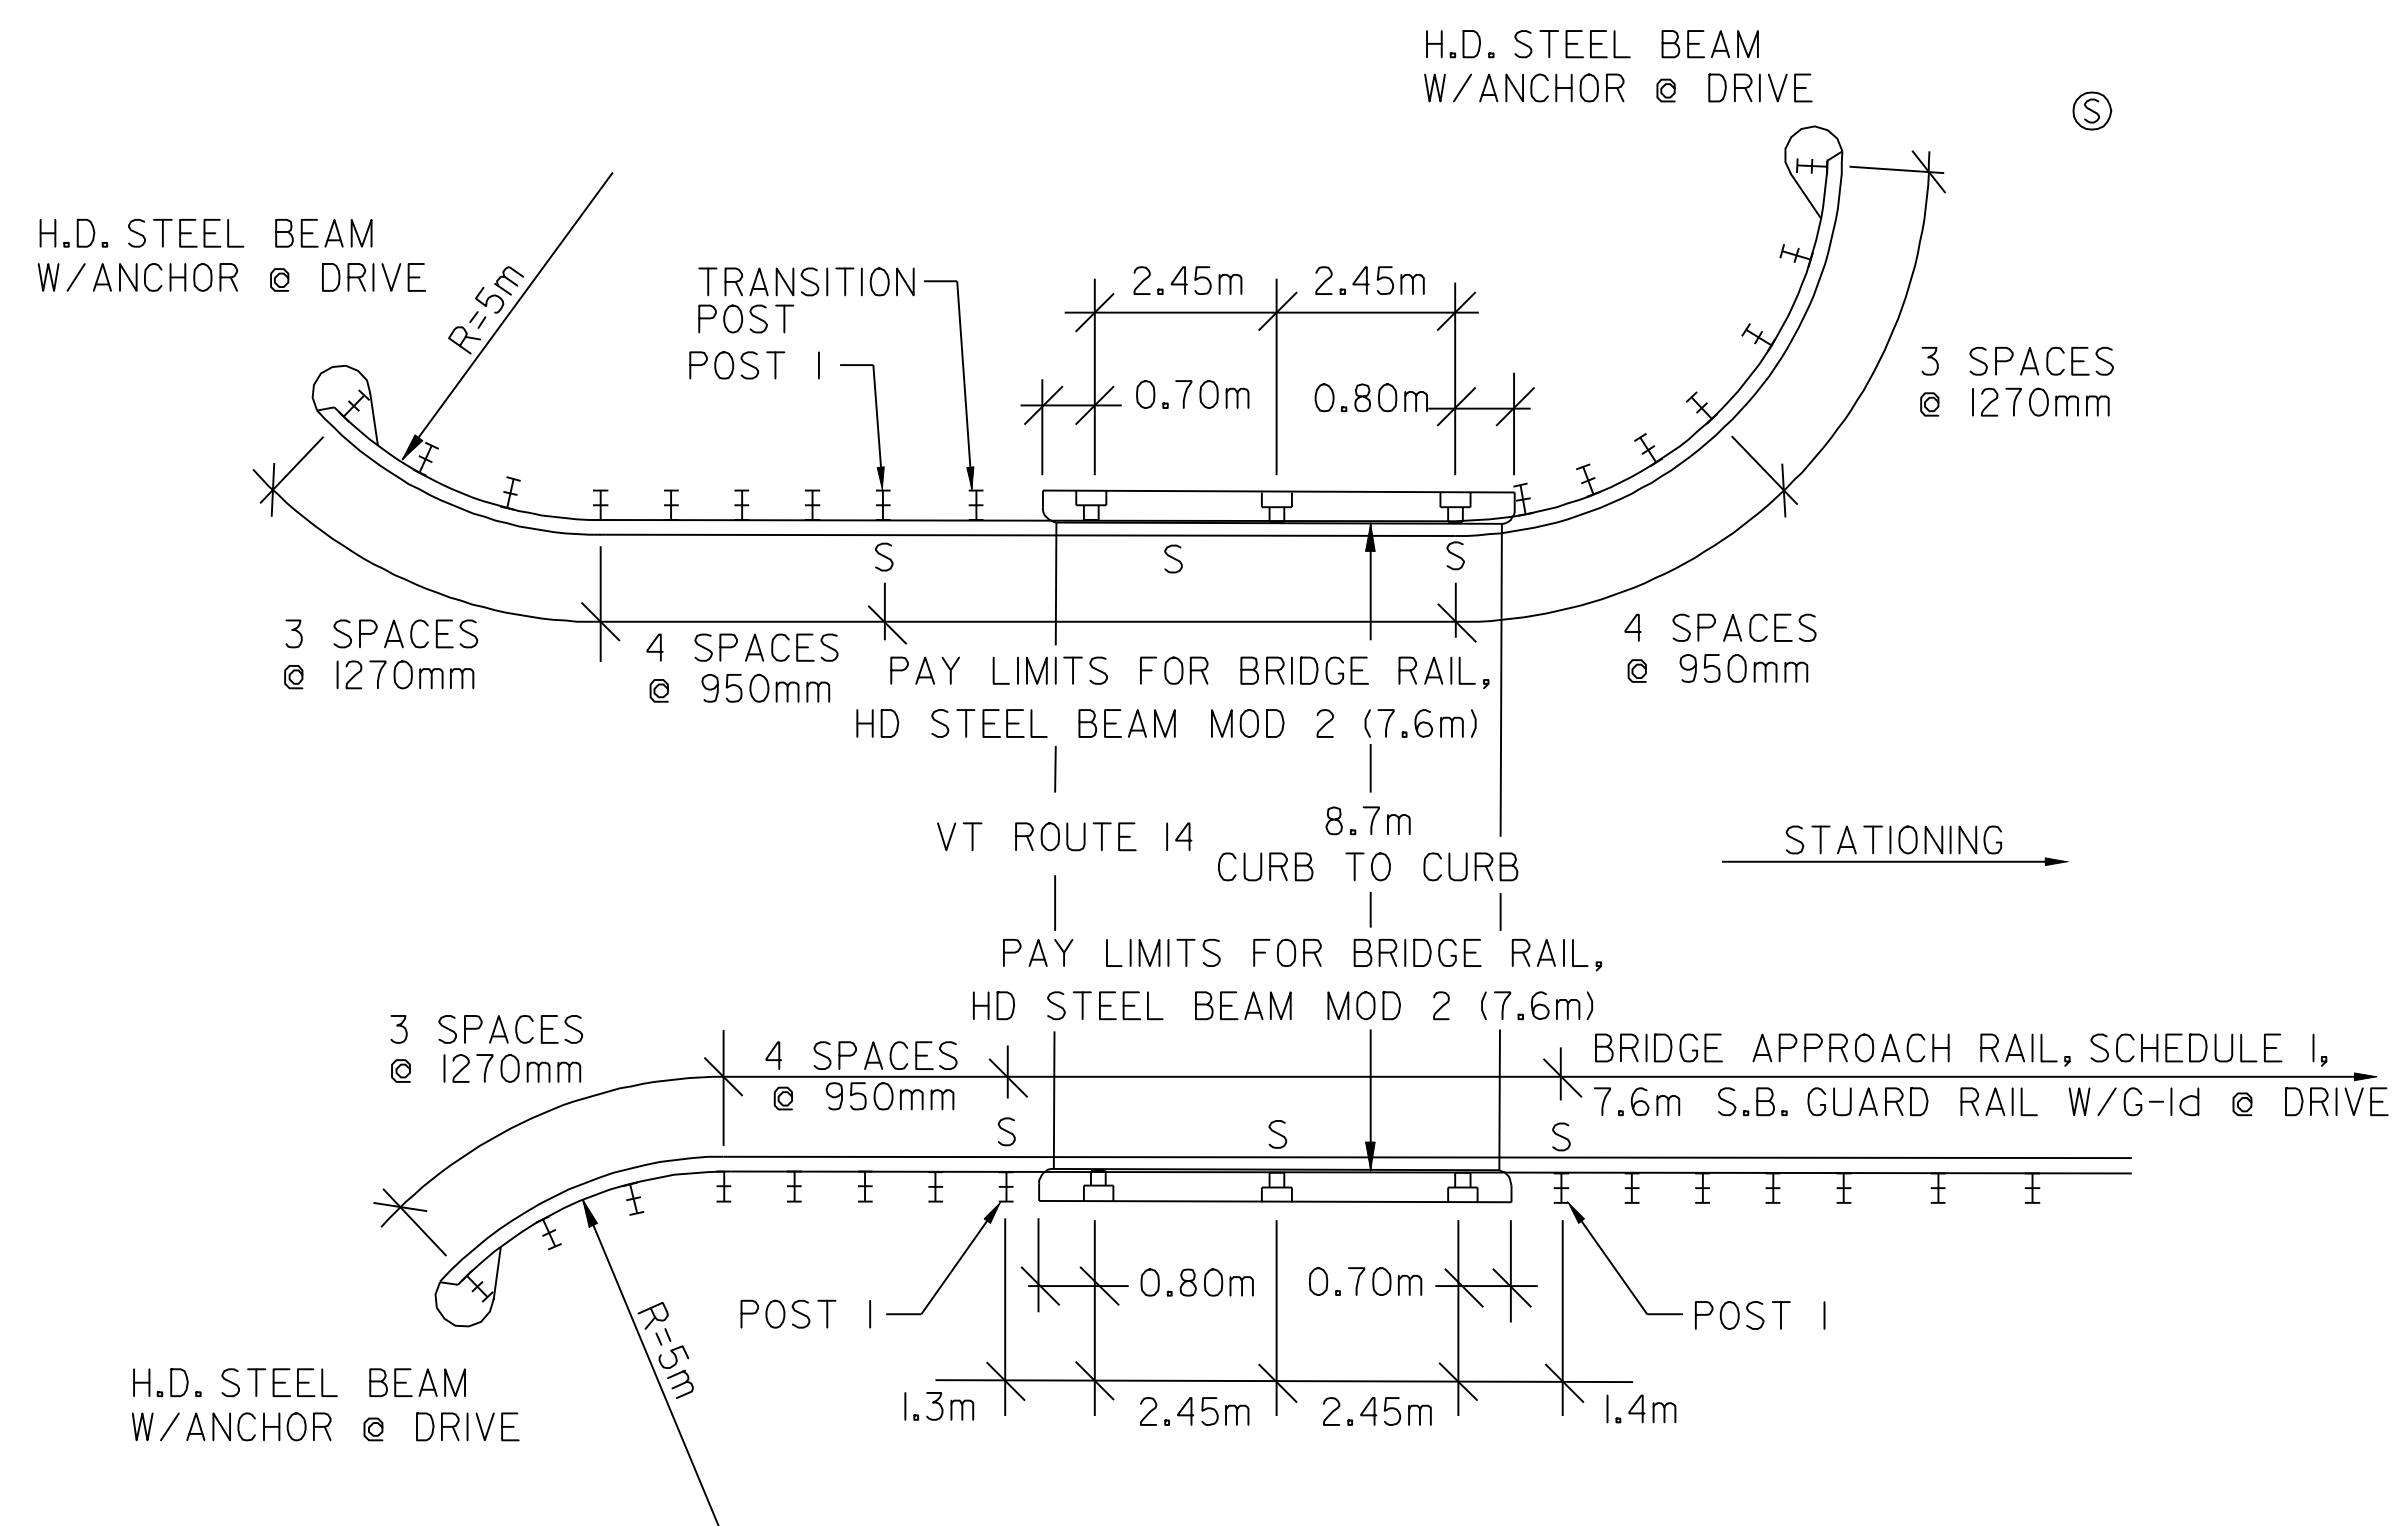


WOODBURY - BRIDGE # 88
STA 4+097 = MM 2.546

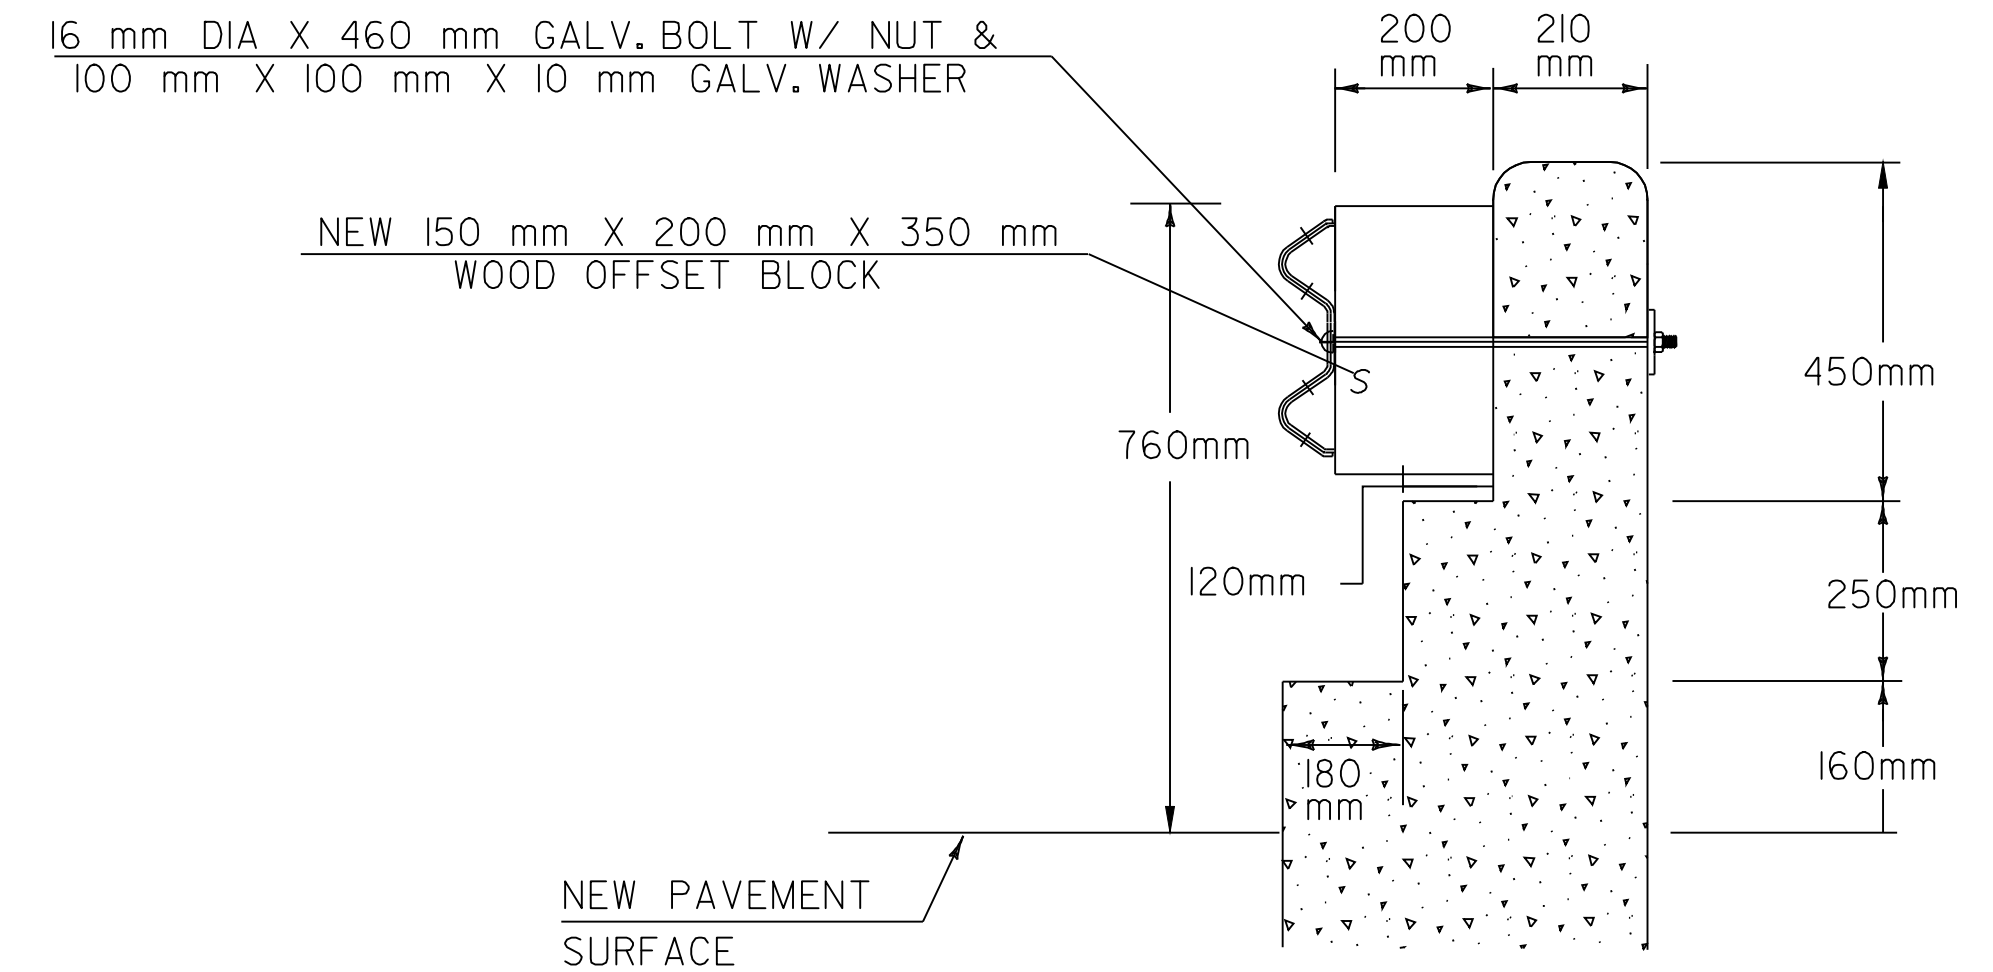

HARDWICK - BRIDGE # 95
STA 1+187.5 = MM 0.738

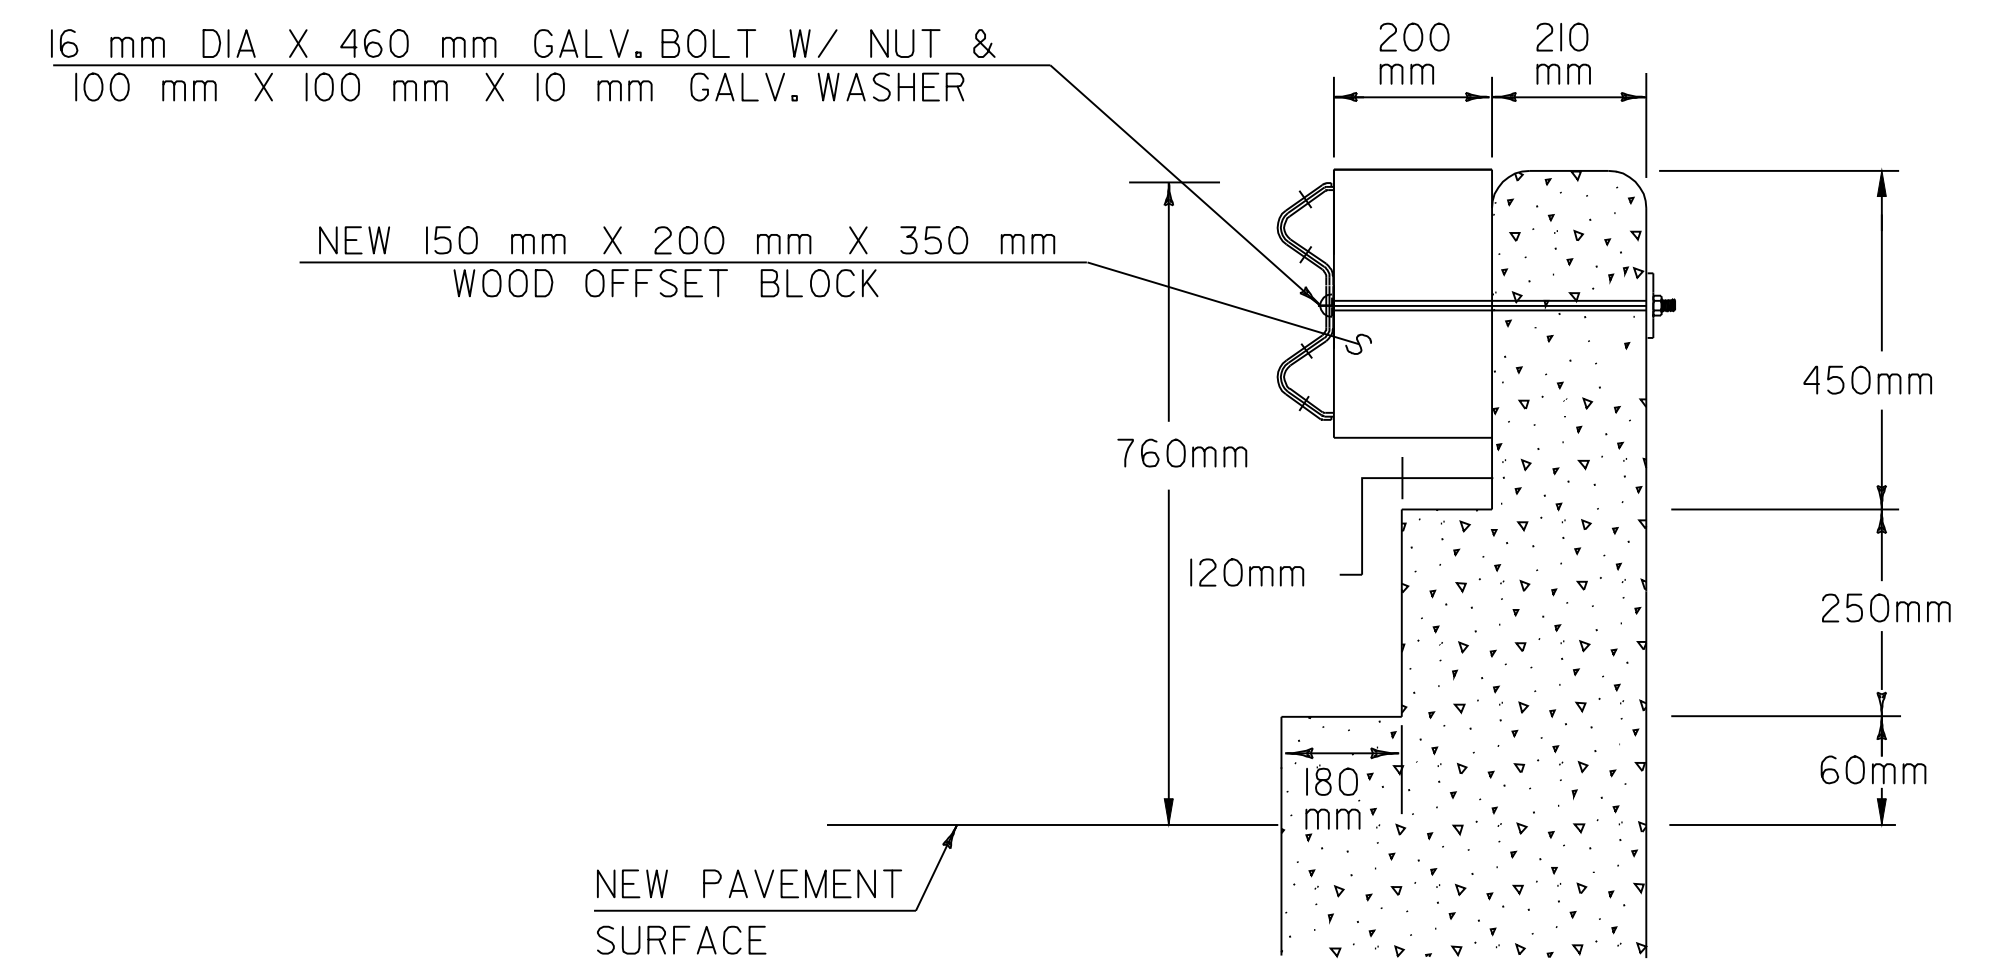

**ARCHIVED
 IN DPR**

**BRIDGE
 DETAIL
 SHEET
 #2**

DESIGNED BY BCE/PJM DATE 10-98
 DRAWN BY C.E.A., INC. DATE 10-98
 DESIGN FILE NO. /pave/97b174/pb174.dgn
 PRF FILE pb174ds2.i DATE PLOTTED 21-MAR-2008 16:51
 PROJ. NAME **WOODBURY - HARDWICK**
 PROJ. NO. **STP 9817(1)S**
 SHEET **24** OF **25** SHEETS