

SEED
US RTE 2 10+00 RT - 10+48 RT
US RTE 2 13+83 RT - 15+00 RT
US RTE 2 14+09 LT - 15+00 RT

~~SEED, WINTER RYE~~
~~US RTE 2 10+00 RT - 10+48 RT~~
~~US RTE 2 13+83 RT - 15+00 RT~~
~~US RTE 2 14+09 LT - 15+00 RT~~


HAY MULCH
US RTE 2 10+00 RT - 10+48 RT
US RTE 2 13+83 RT - 15+00 RT
US RTE 2 14+09 LT - 15+00 RT

TOP SOIL
US RTE 2 10+00 RT - 10+48 RT
US RTE 2 13+83 RT - 15+00 RT
US RTE 2 14+09 LT - 15+00 RT

BARRIER FENCE
I-89 RAMP "C" 40+86 RT - 41+50 RT

PROJECT DEMARCATION FENCE
US RTE 2 10+00 RT - 10+15 RT
I-89 RAMP "C" 40+86 RT - US RTE 2 10+15 LT

EPSC CONSTRUCTION SITE PLAN SHEET 1

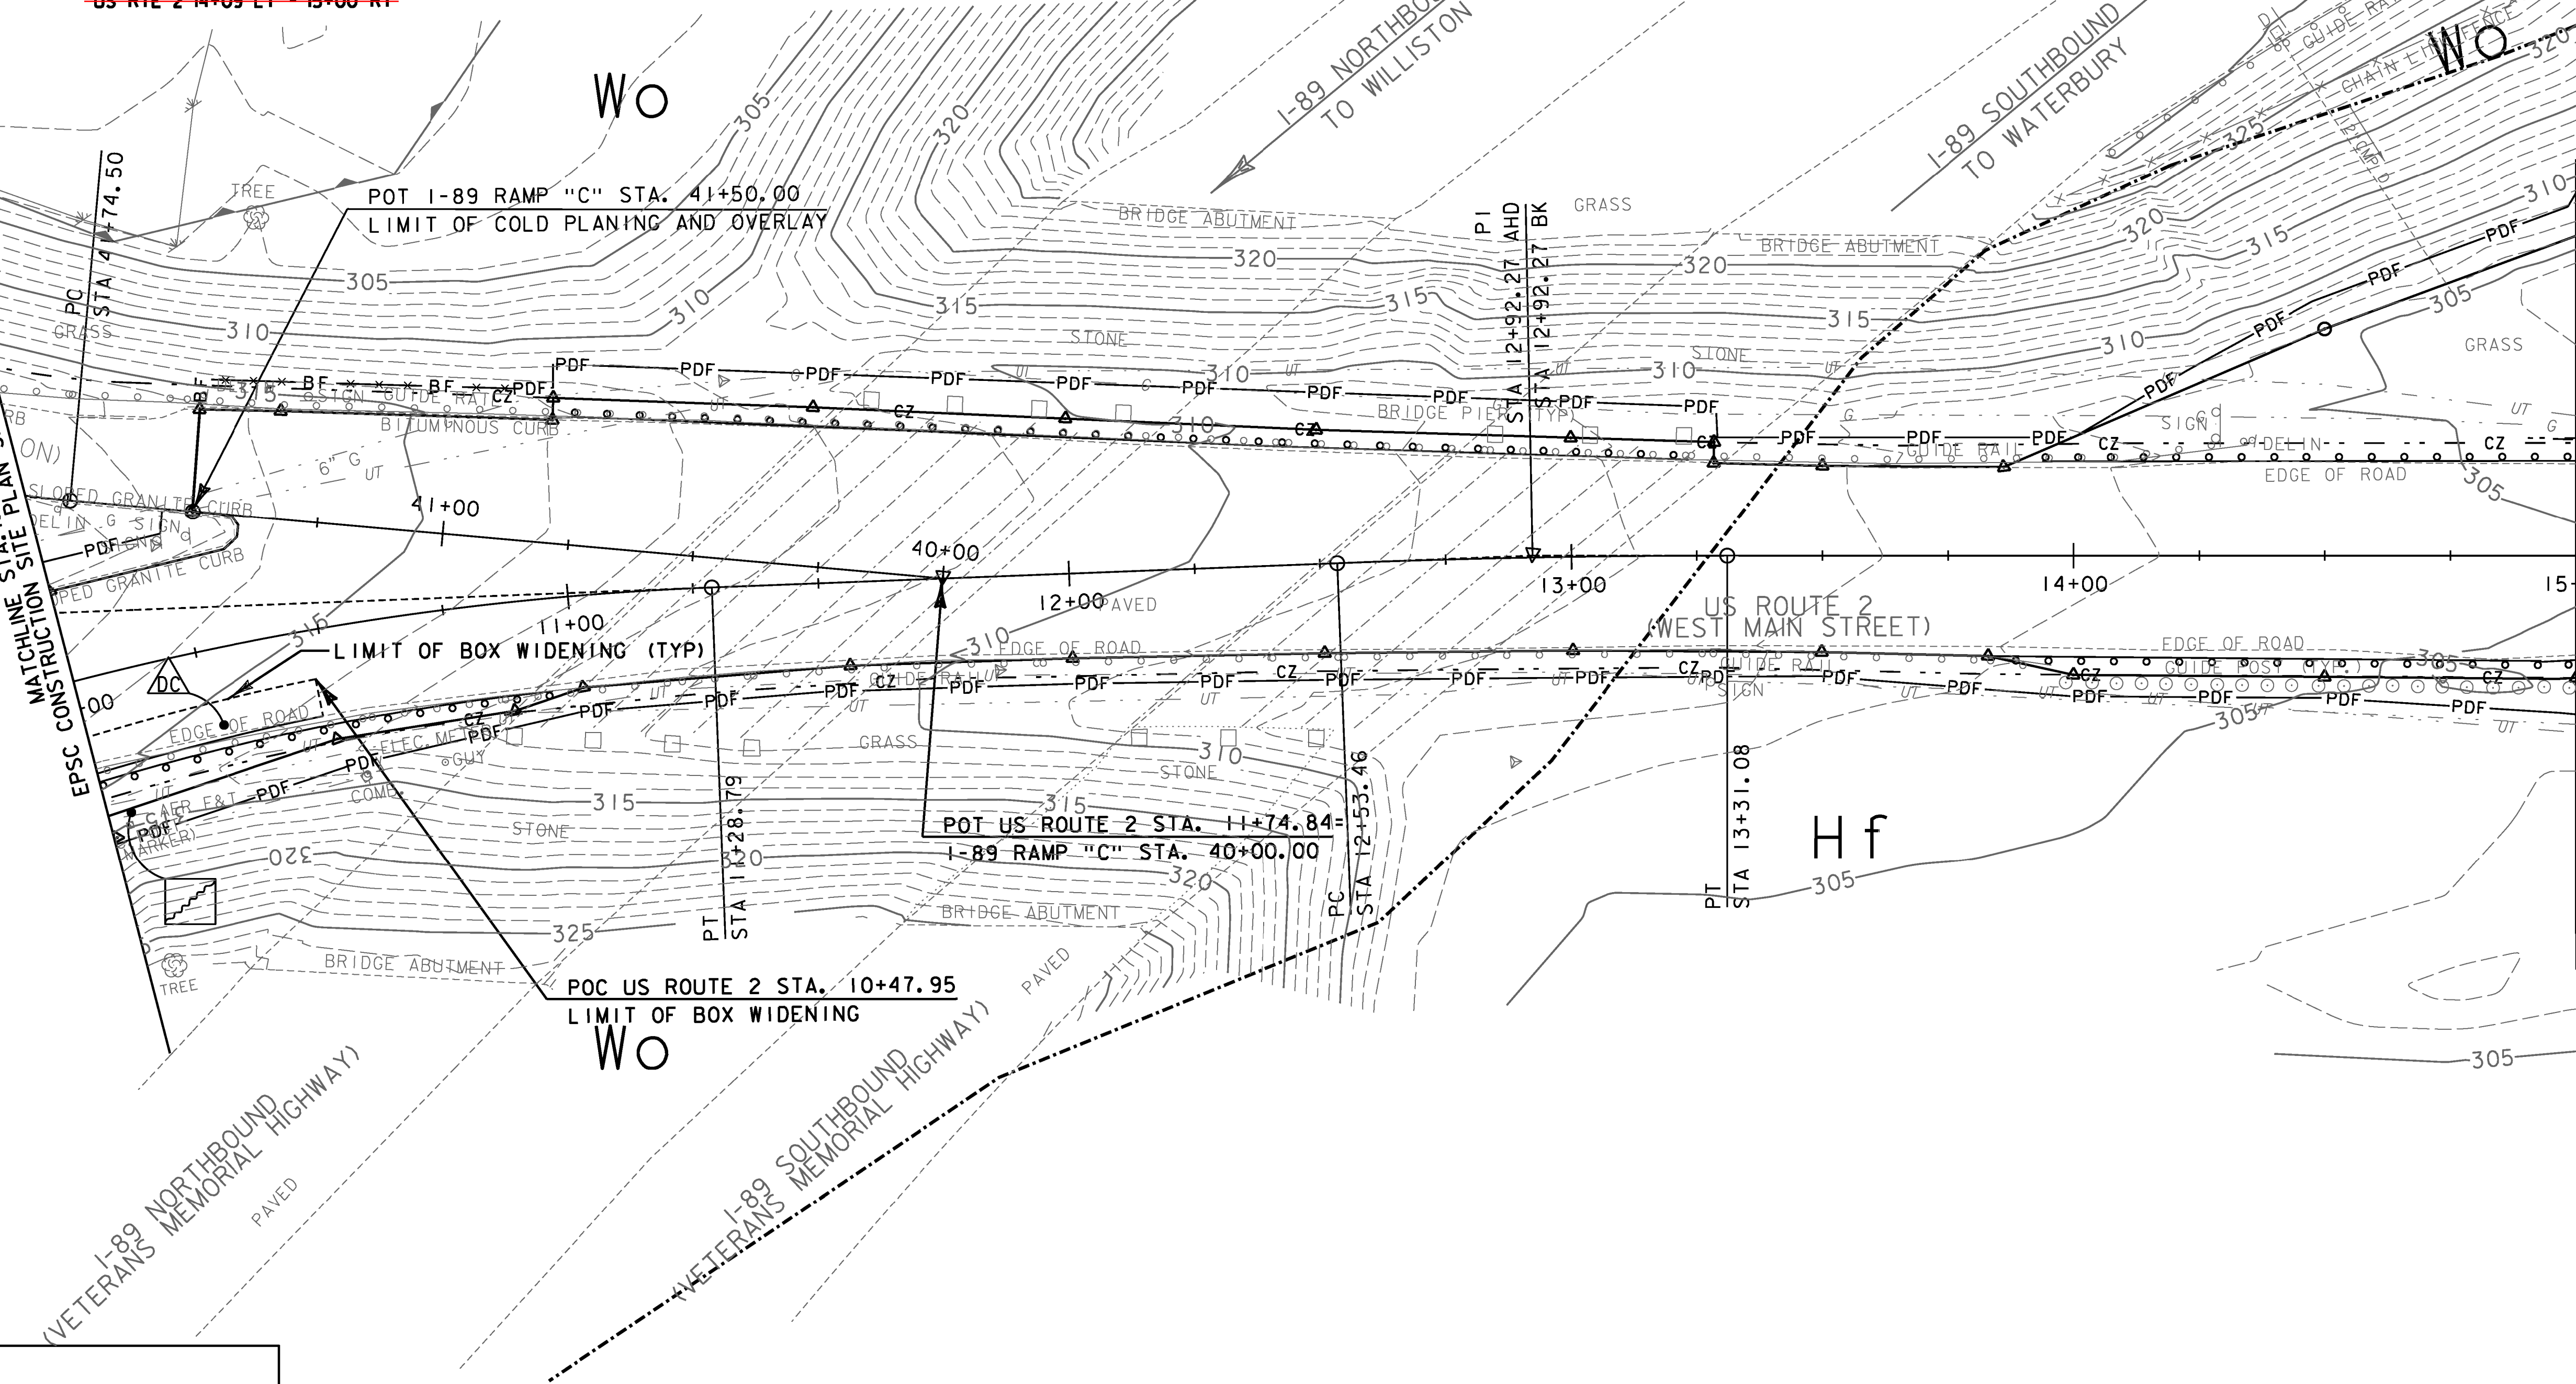

EPSC CONSTRUCTION SITE PLAN SHEET 3

LEGEND

-----	SOIL TYPE BOUNDARY		SURFACE ROUGHENING		PIPE INLET PROTECTION
—300—	5' INTERVAL PROPOSED CONTOUR		SILT FENCE		FILTER FABRIC DROP INLET PROTECTION
-----	1' INTERVAL PROPOSED CONTOUR		SILT FENCE WOVEN WIRE		ROLLED EROSION CONTROL PRODUCT, DITCH/SIDESLOPE
—300—	5' INTERVAL EXISTING CONTOUR		STABILIZED CONSTRUCTION ENTRANCE (SEE TRAFFIC MANAGEMENT PLANS)		-BF- BARRIER FENCE
-----	1' INTERVAL EXISTING CONTOUR		-PDF- PROJECT DEMARCATION FENCE		DUST CONTROL
—	EXIST. PROPERTY/ROW LINE				
○-△	LIMIT OF WORK (LIMIT OF DISTURBANCE)				

NOTE:
SEE EPSC NARRATIVE FOR ADDITIONAL REQUIREMENTS.



PROJECT NAME: RICHMOND
PROJECT NUMBER: STP 0284 (17)

FILE NAME: z97cl86eccsbdr.dgn
PROJECT LEADER: ERIK ATKINS
DESIGNED BY: T.BIGELOW
EPSC CONSTRUCTION SITE PLAN SHEET 2

PLOT DATE: 4/29/2013
DRAWN BY: A. ACHARYA
CHECKED BY: E. ATKINS
SHEET 19 OF 133