


MATCHLINE STA. 20+00
EPSC FINAL CONDITIONS PLAN SHEET 3

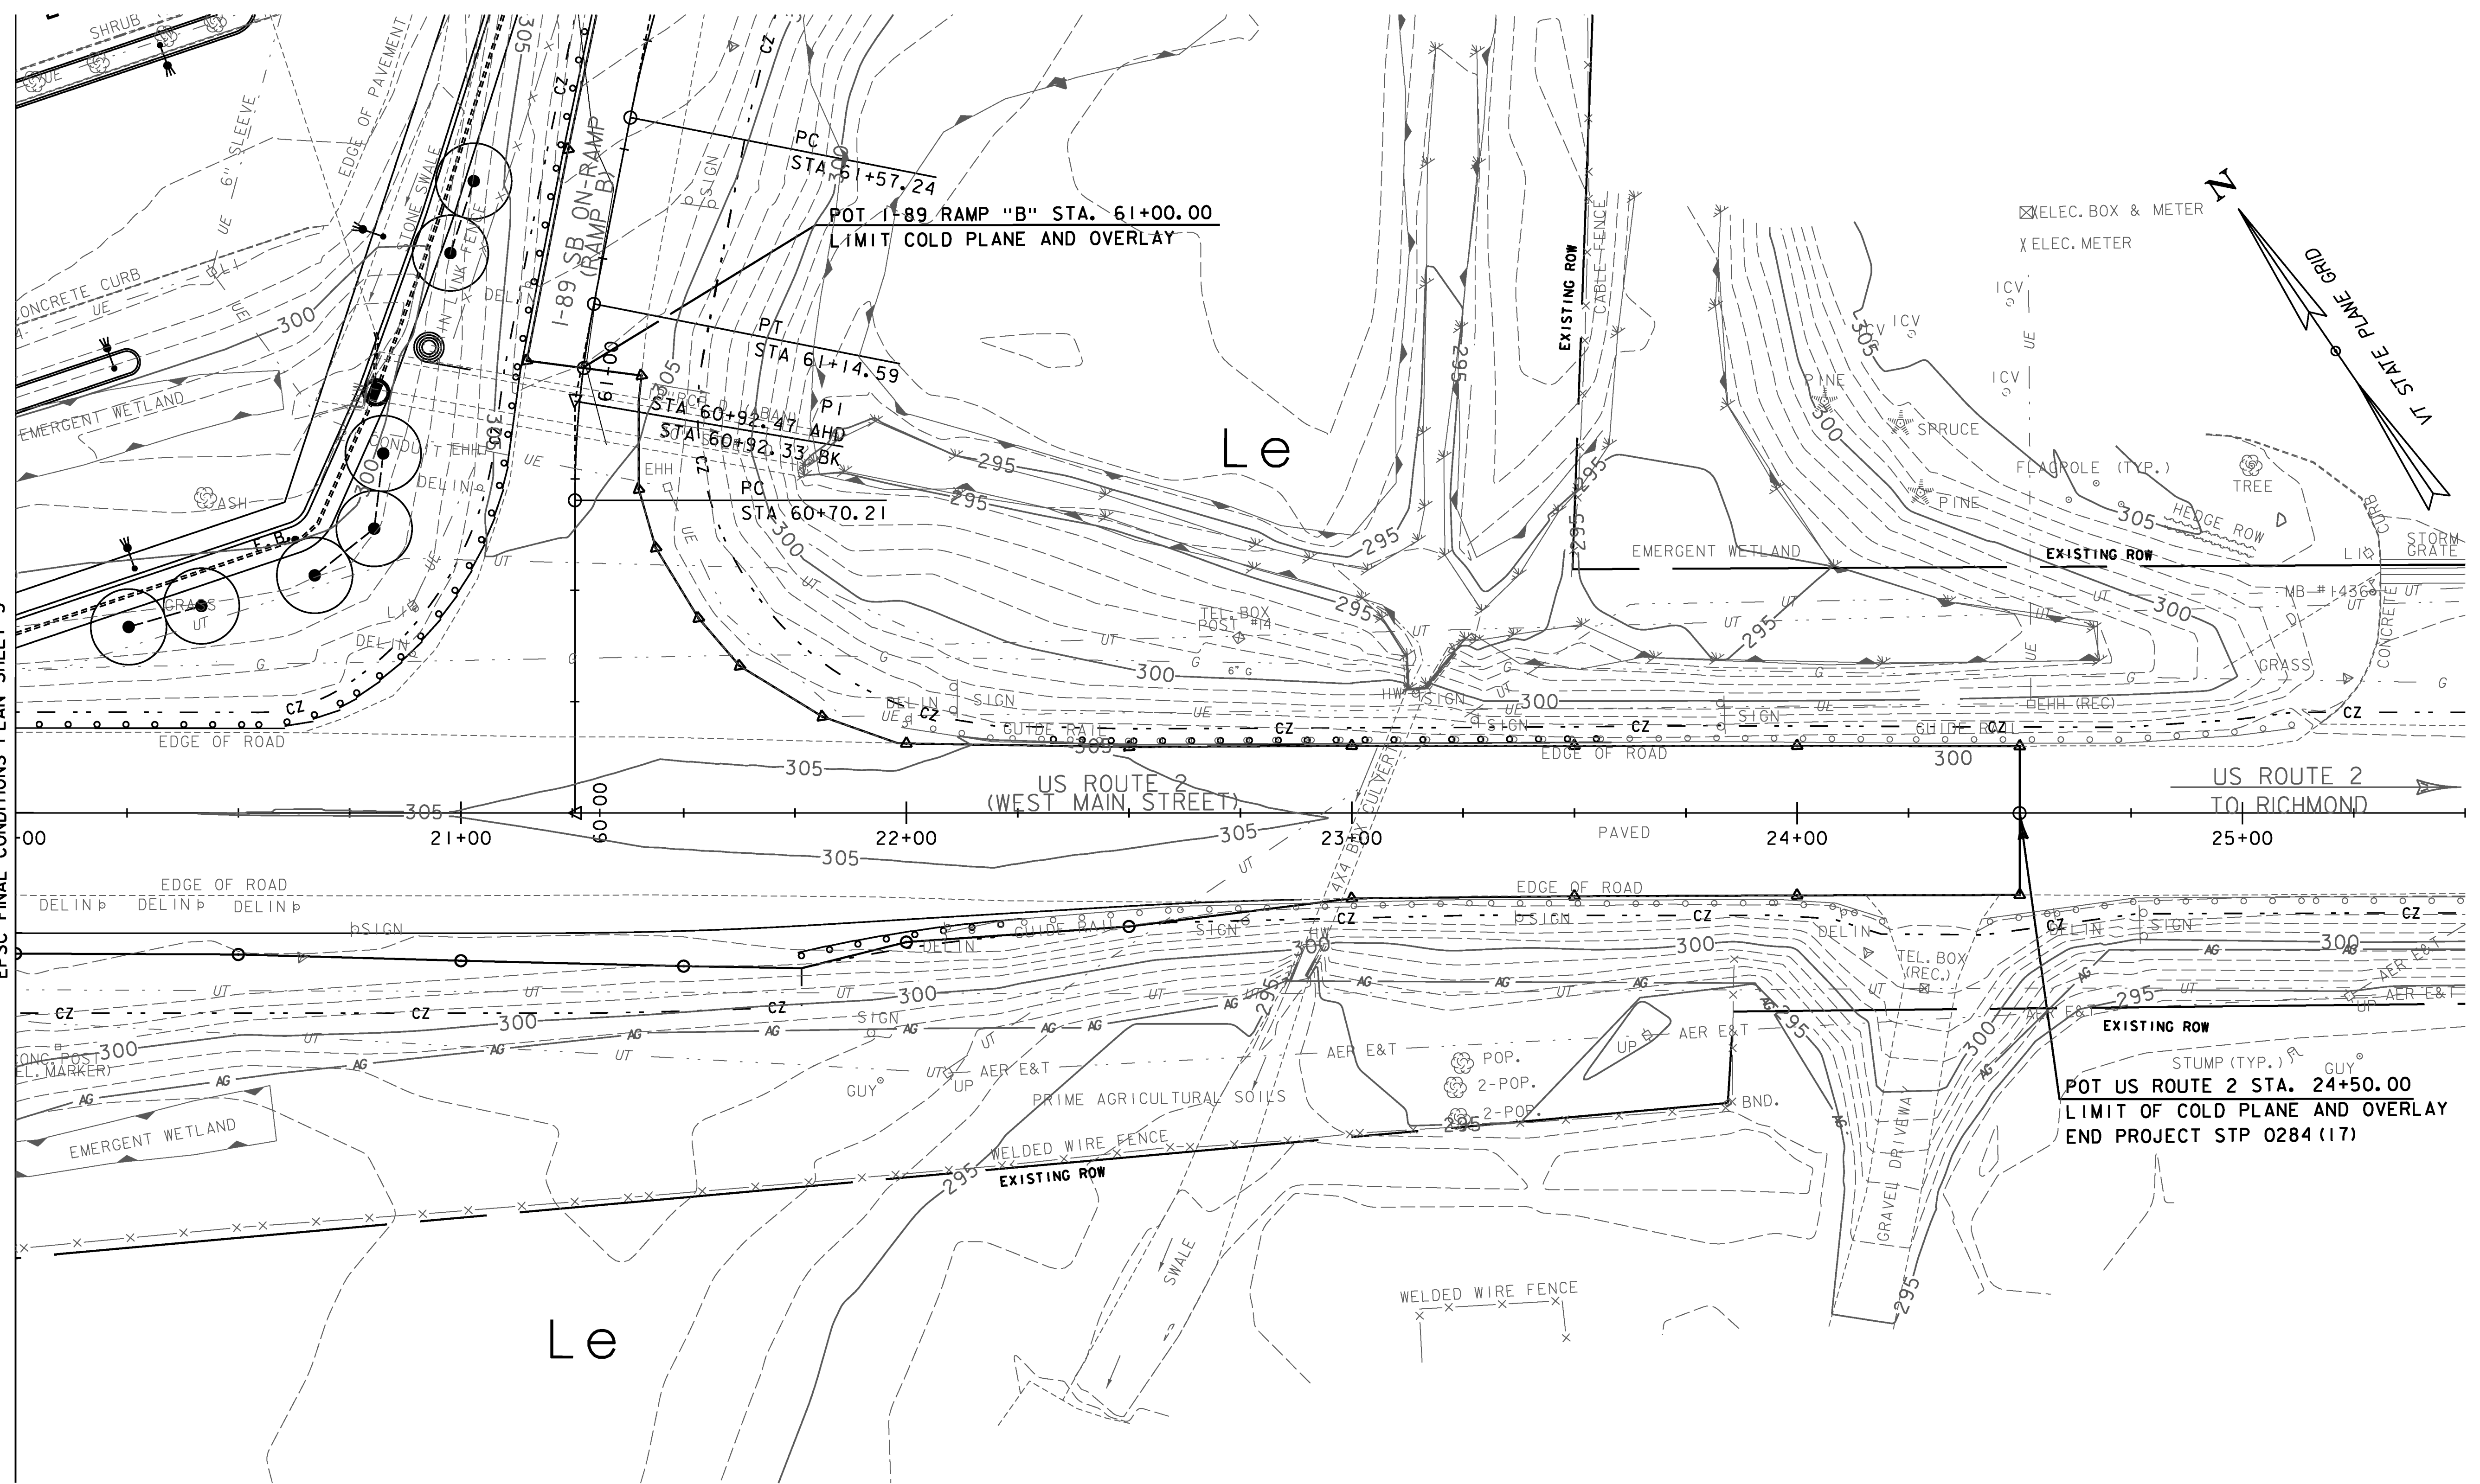

NOTE:
SEE CROSS SECTIONS AND PARTIAL GRADING PLAN FOR ADDITIONAL PROPOSED GRADING.



PROJECT NAME: RICHMOND	FILE NAME: z97c186ecfinalbdr.dgn	PLOT DATE: 4/26/2013
PROJECT NUMBER: STP 0284 (17)	PROJECT LEADER: ERIK ATKINS	DRAWN BY: N. BOSAN
	DESIGNED BY: T. BIGELOW	CHECKED BY: E. ATKINS
	EPSC FINAL CONDITIONS PLAN SHEET 4	SHEET 26 OF 133