


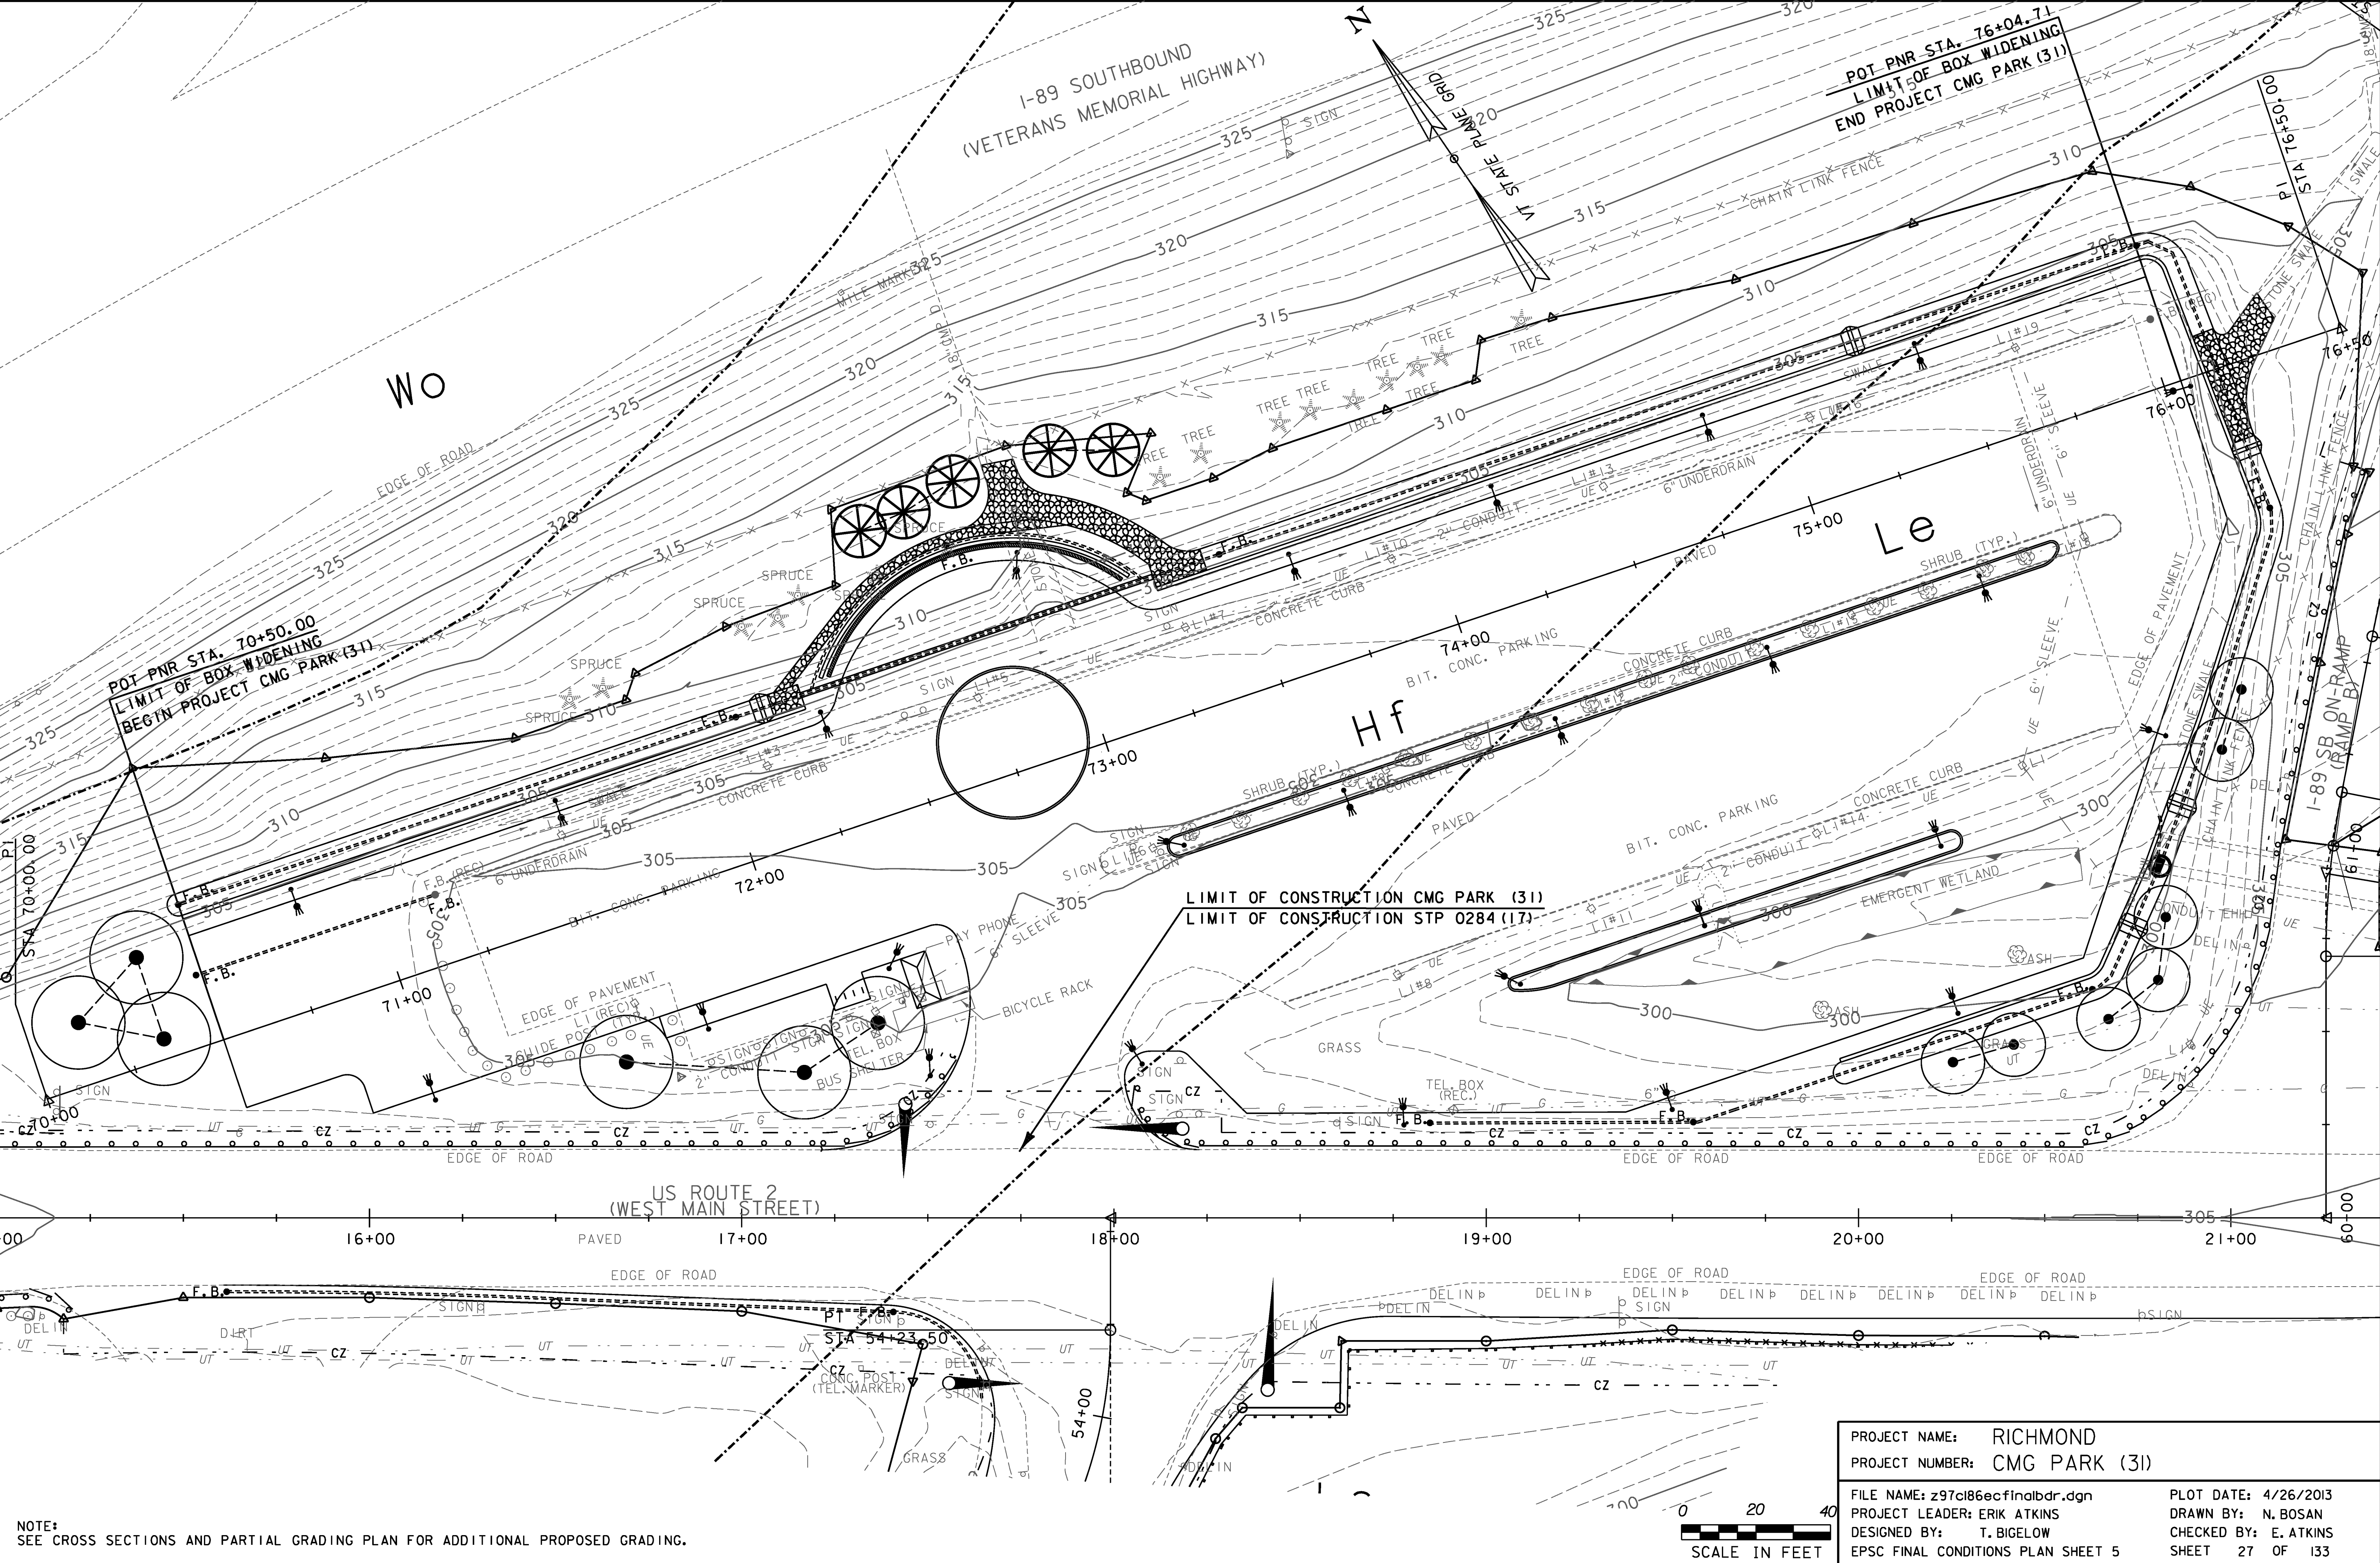

NOTE:
SEE CROSS SECTIONS AND PARTIAL GRADING PLAN FOR ADDITIONAL PROPOSED GRADING.

PROJECT NAME:	RICHMOND
PROJECT NUMBER:	CMG PARK (31)
FILE NAME:	z97cl86ecfinalbdr.dgn
PROJECT LEADER:	ERIK ATKINS
DESIGNED BY:	T. BIGELOW
EPSC FINAL CONDITIONS	PLAN SHEET 5
PLOT DATE:	4/26/2013
DRAWN BY:	N. BOSAN
CHECKED BY:	E. ATKINS
SHEET	27 OF 133