




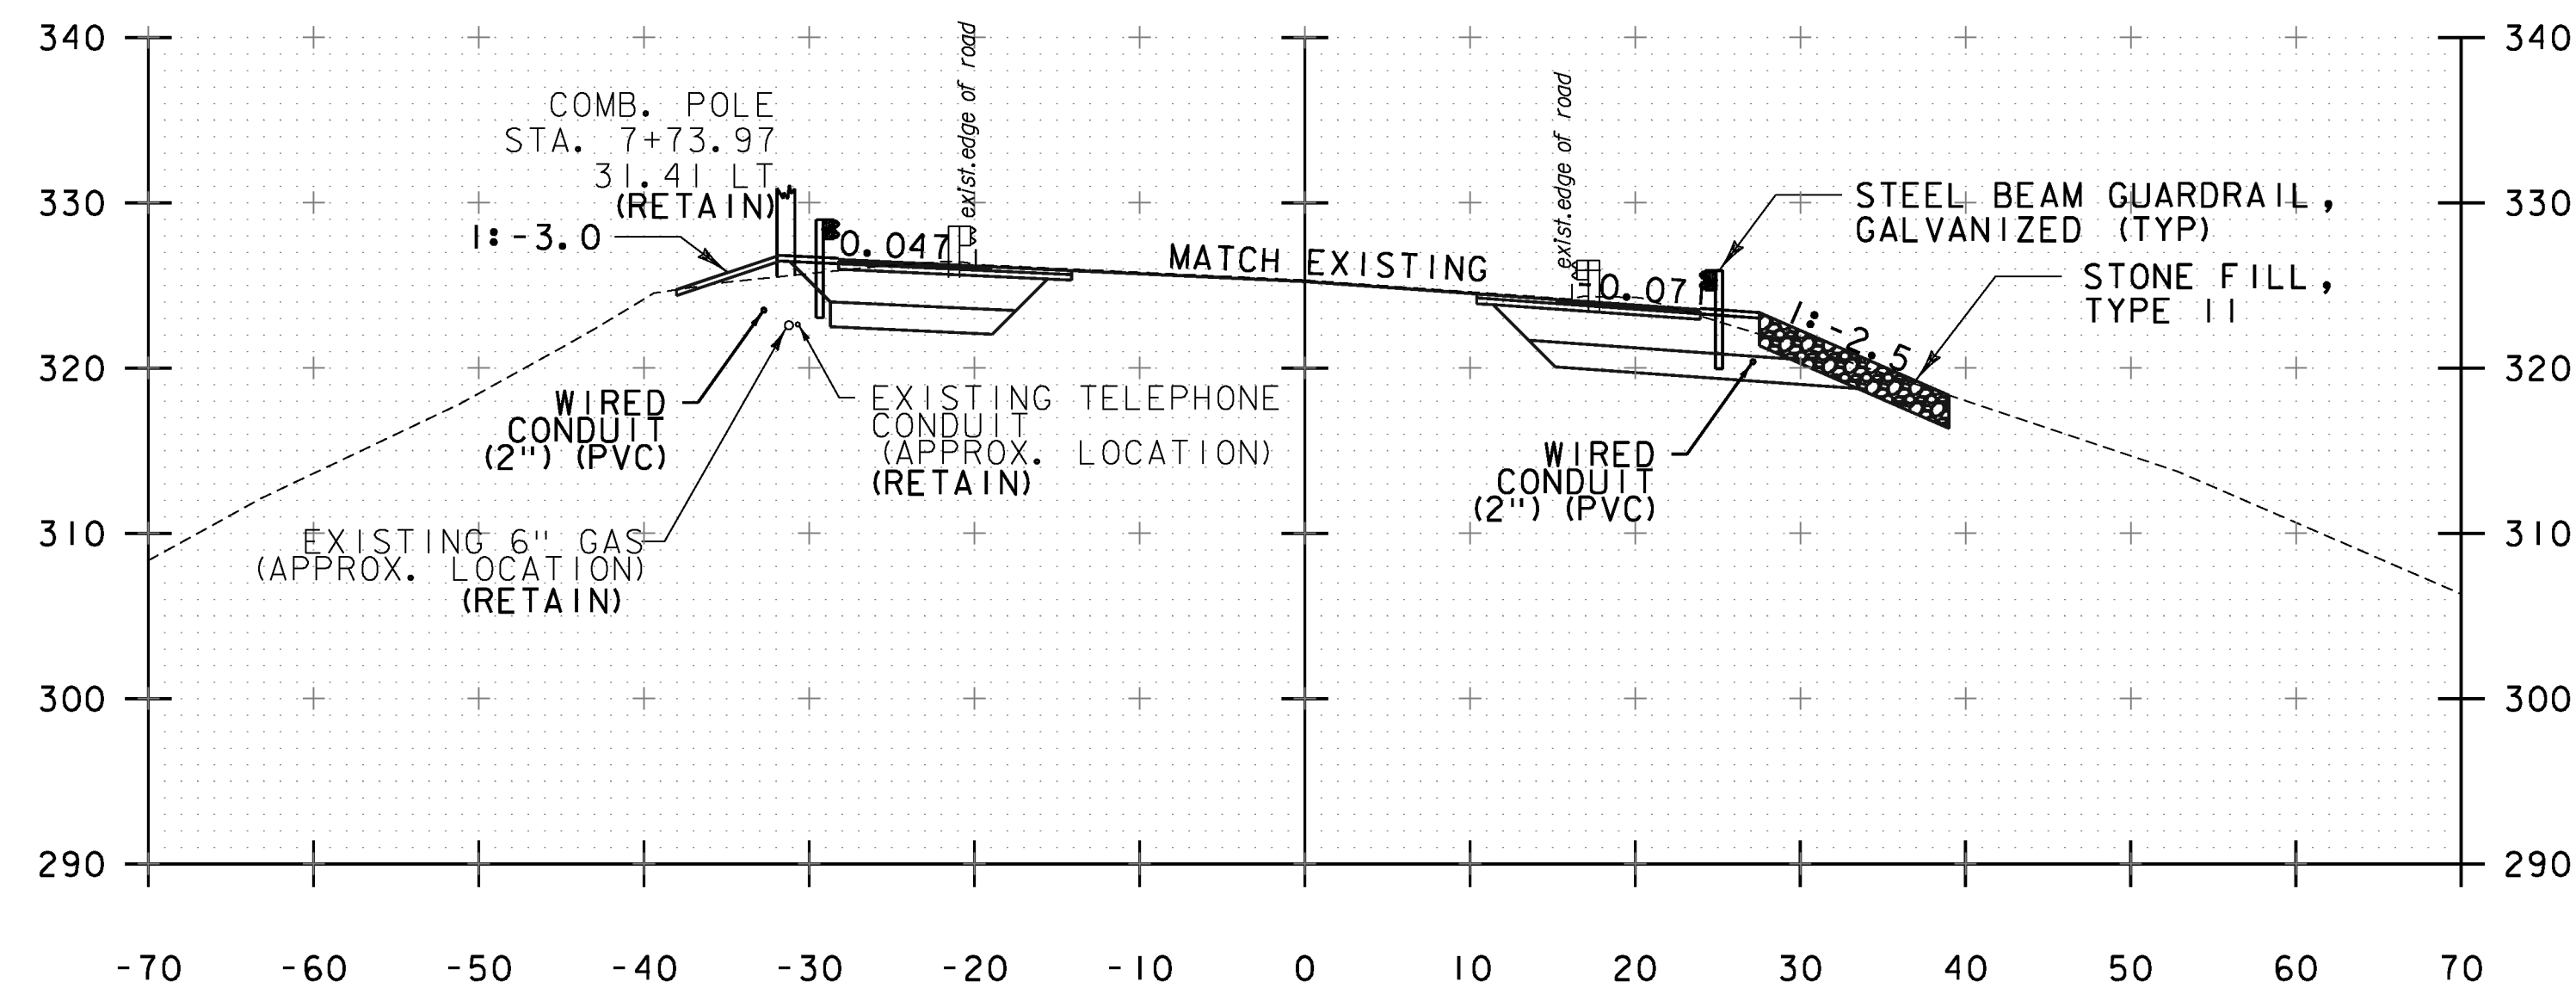


7+50

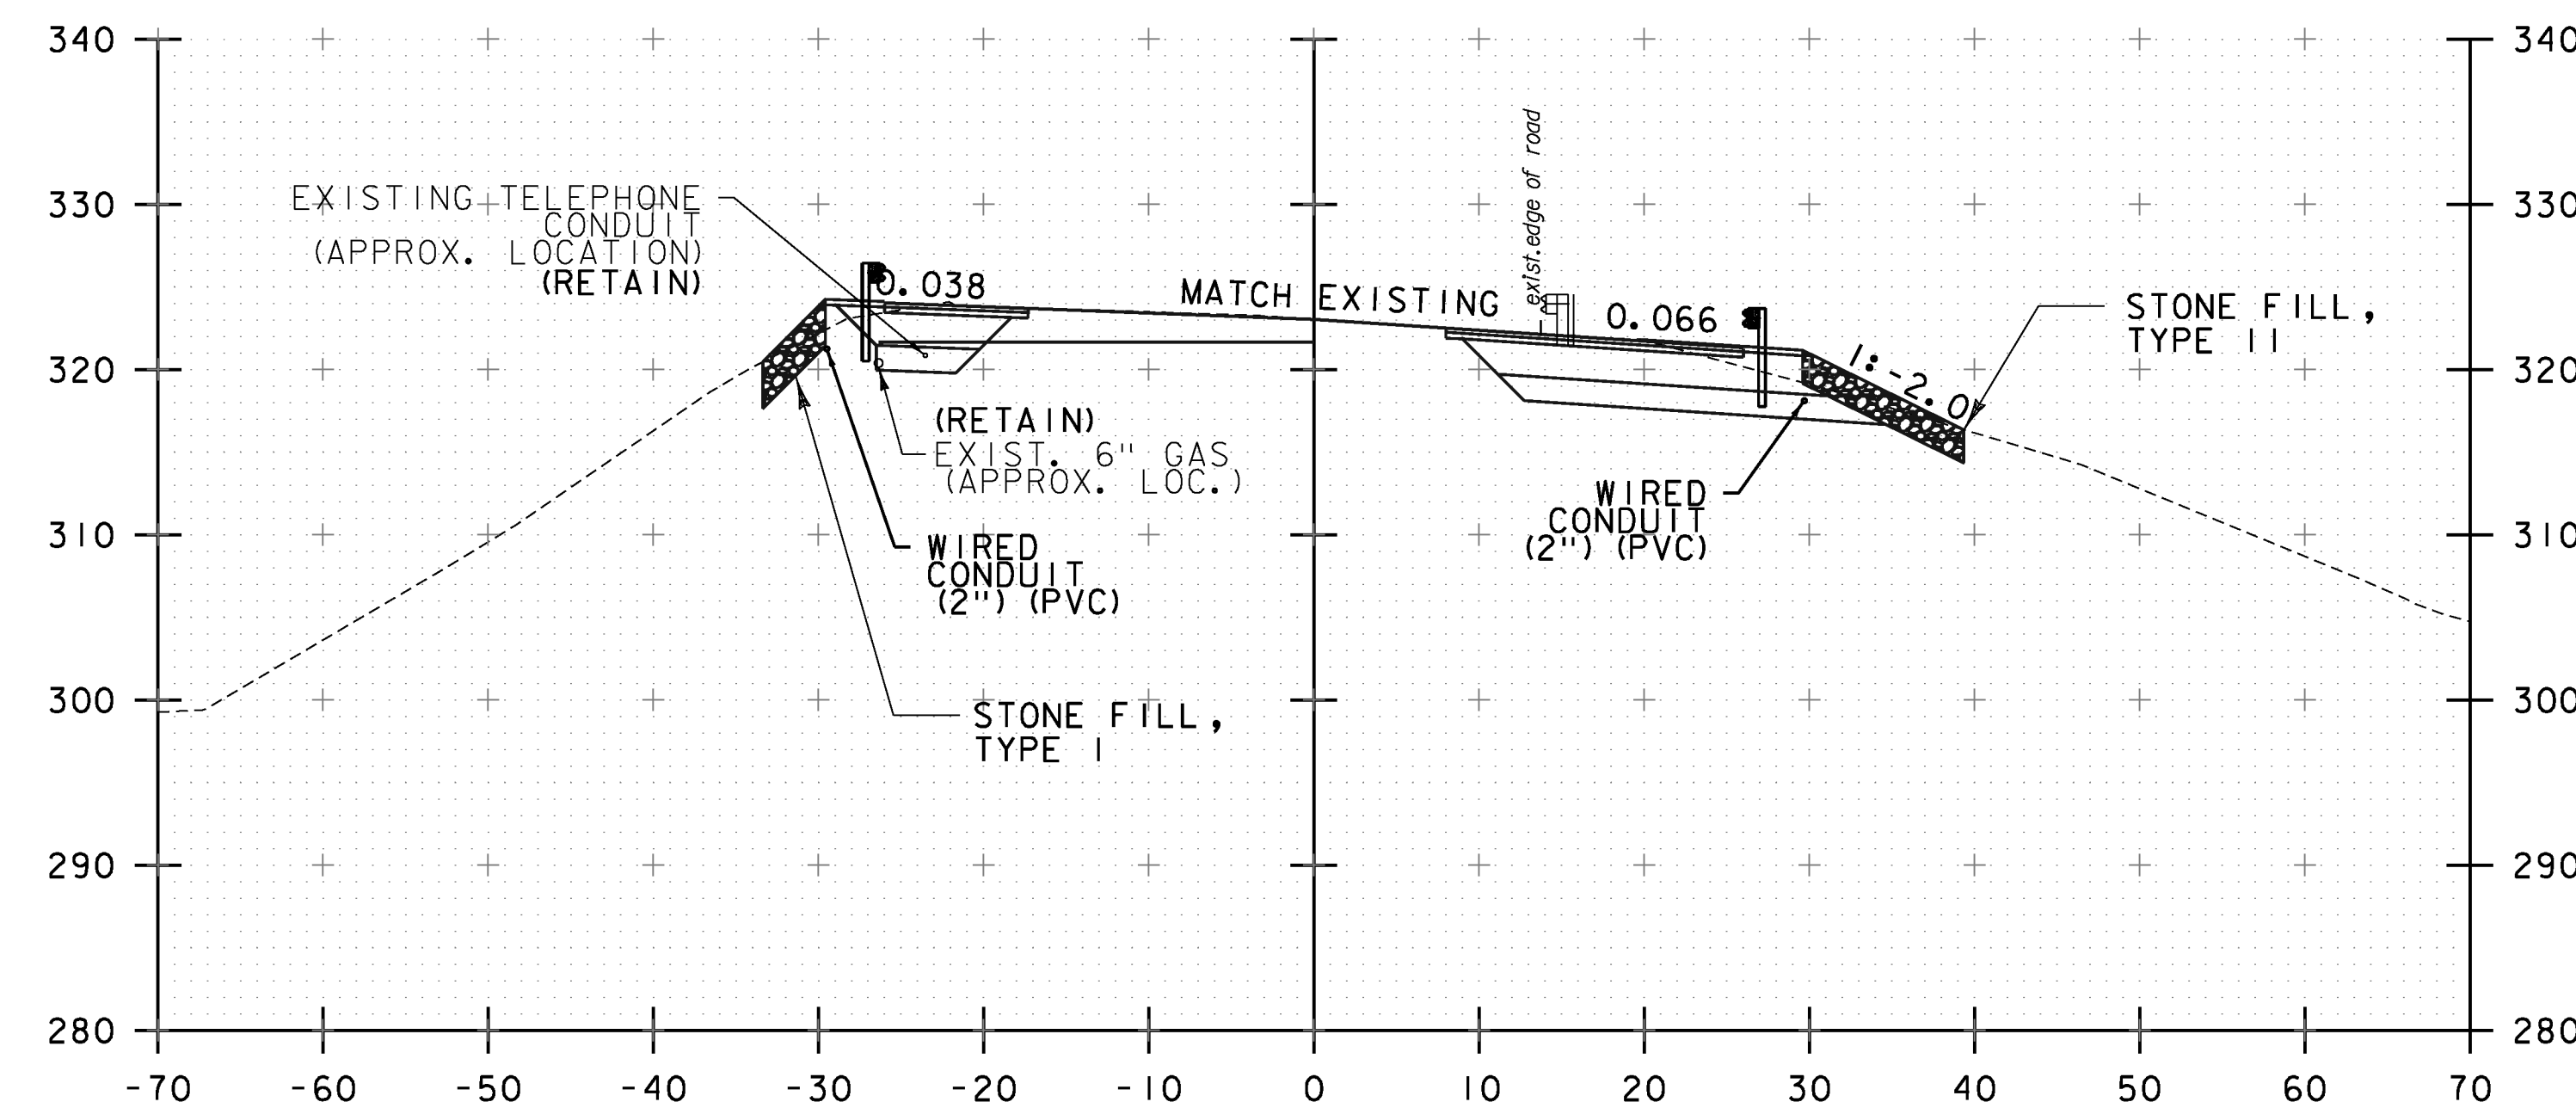

PT 8+03.80

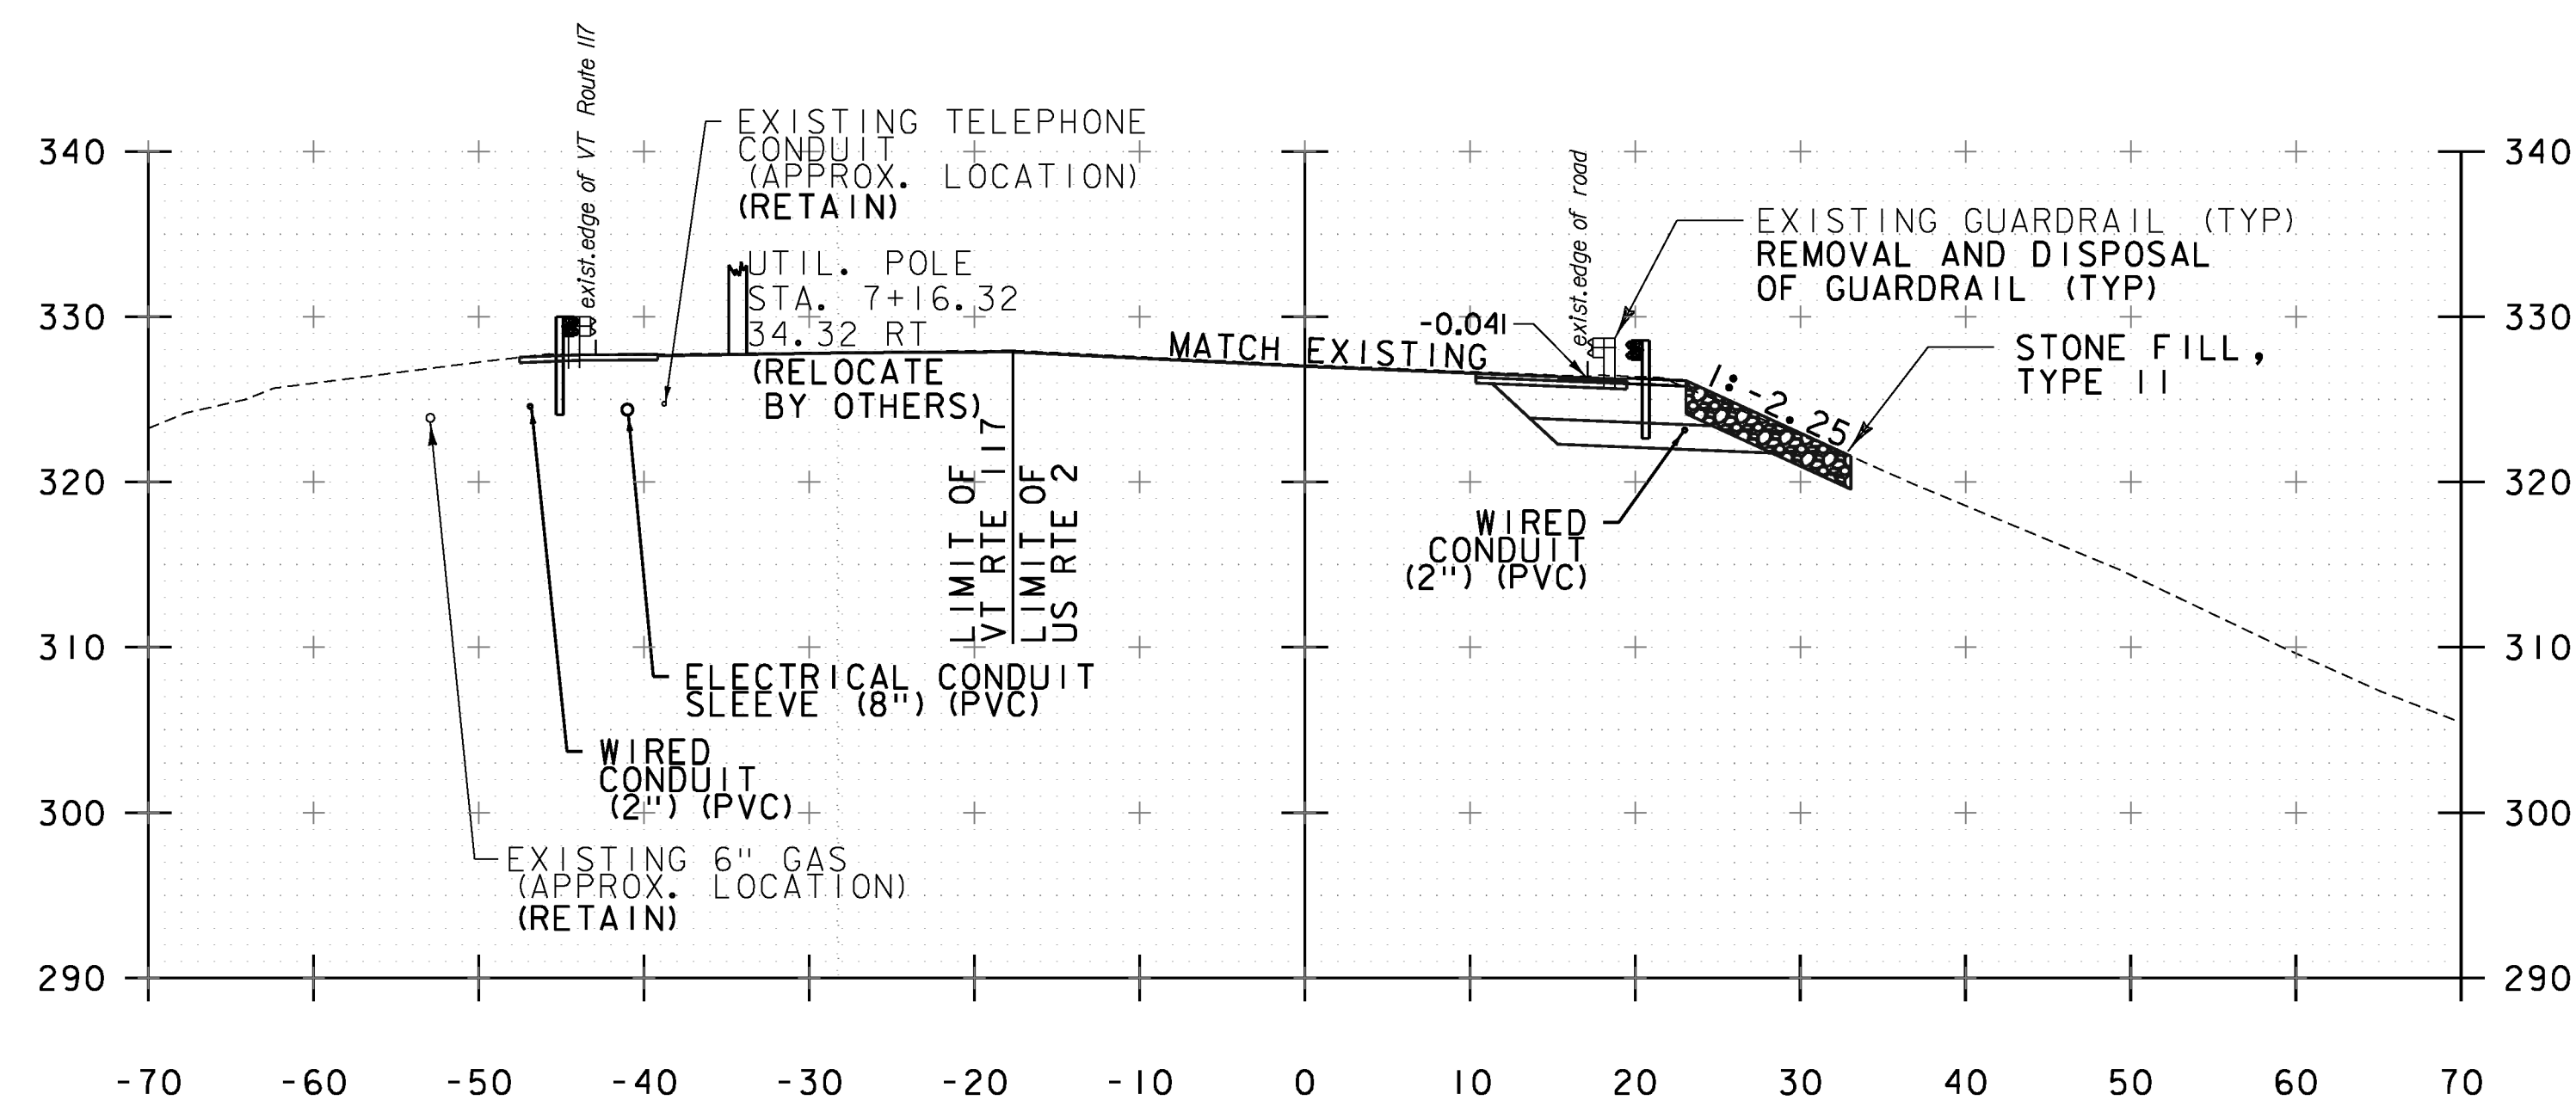

7+00

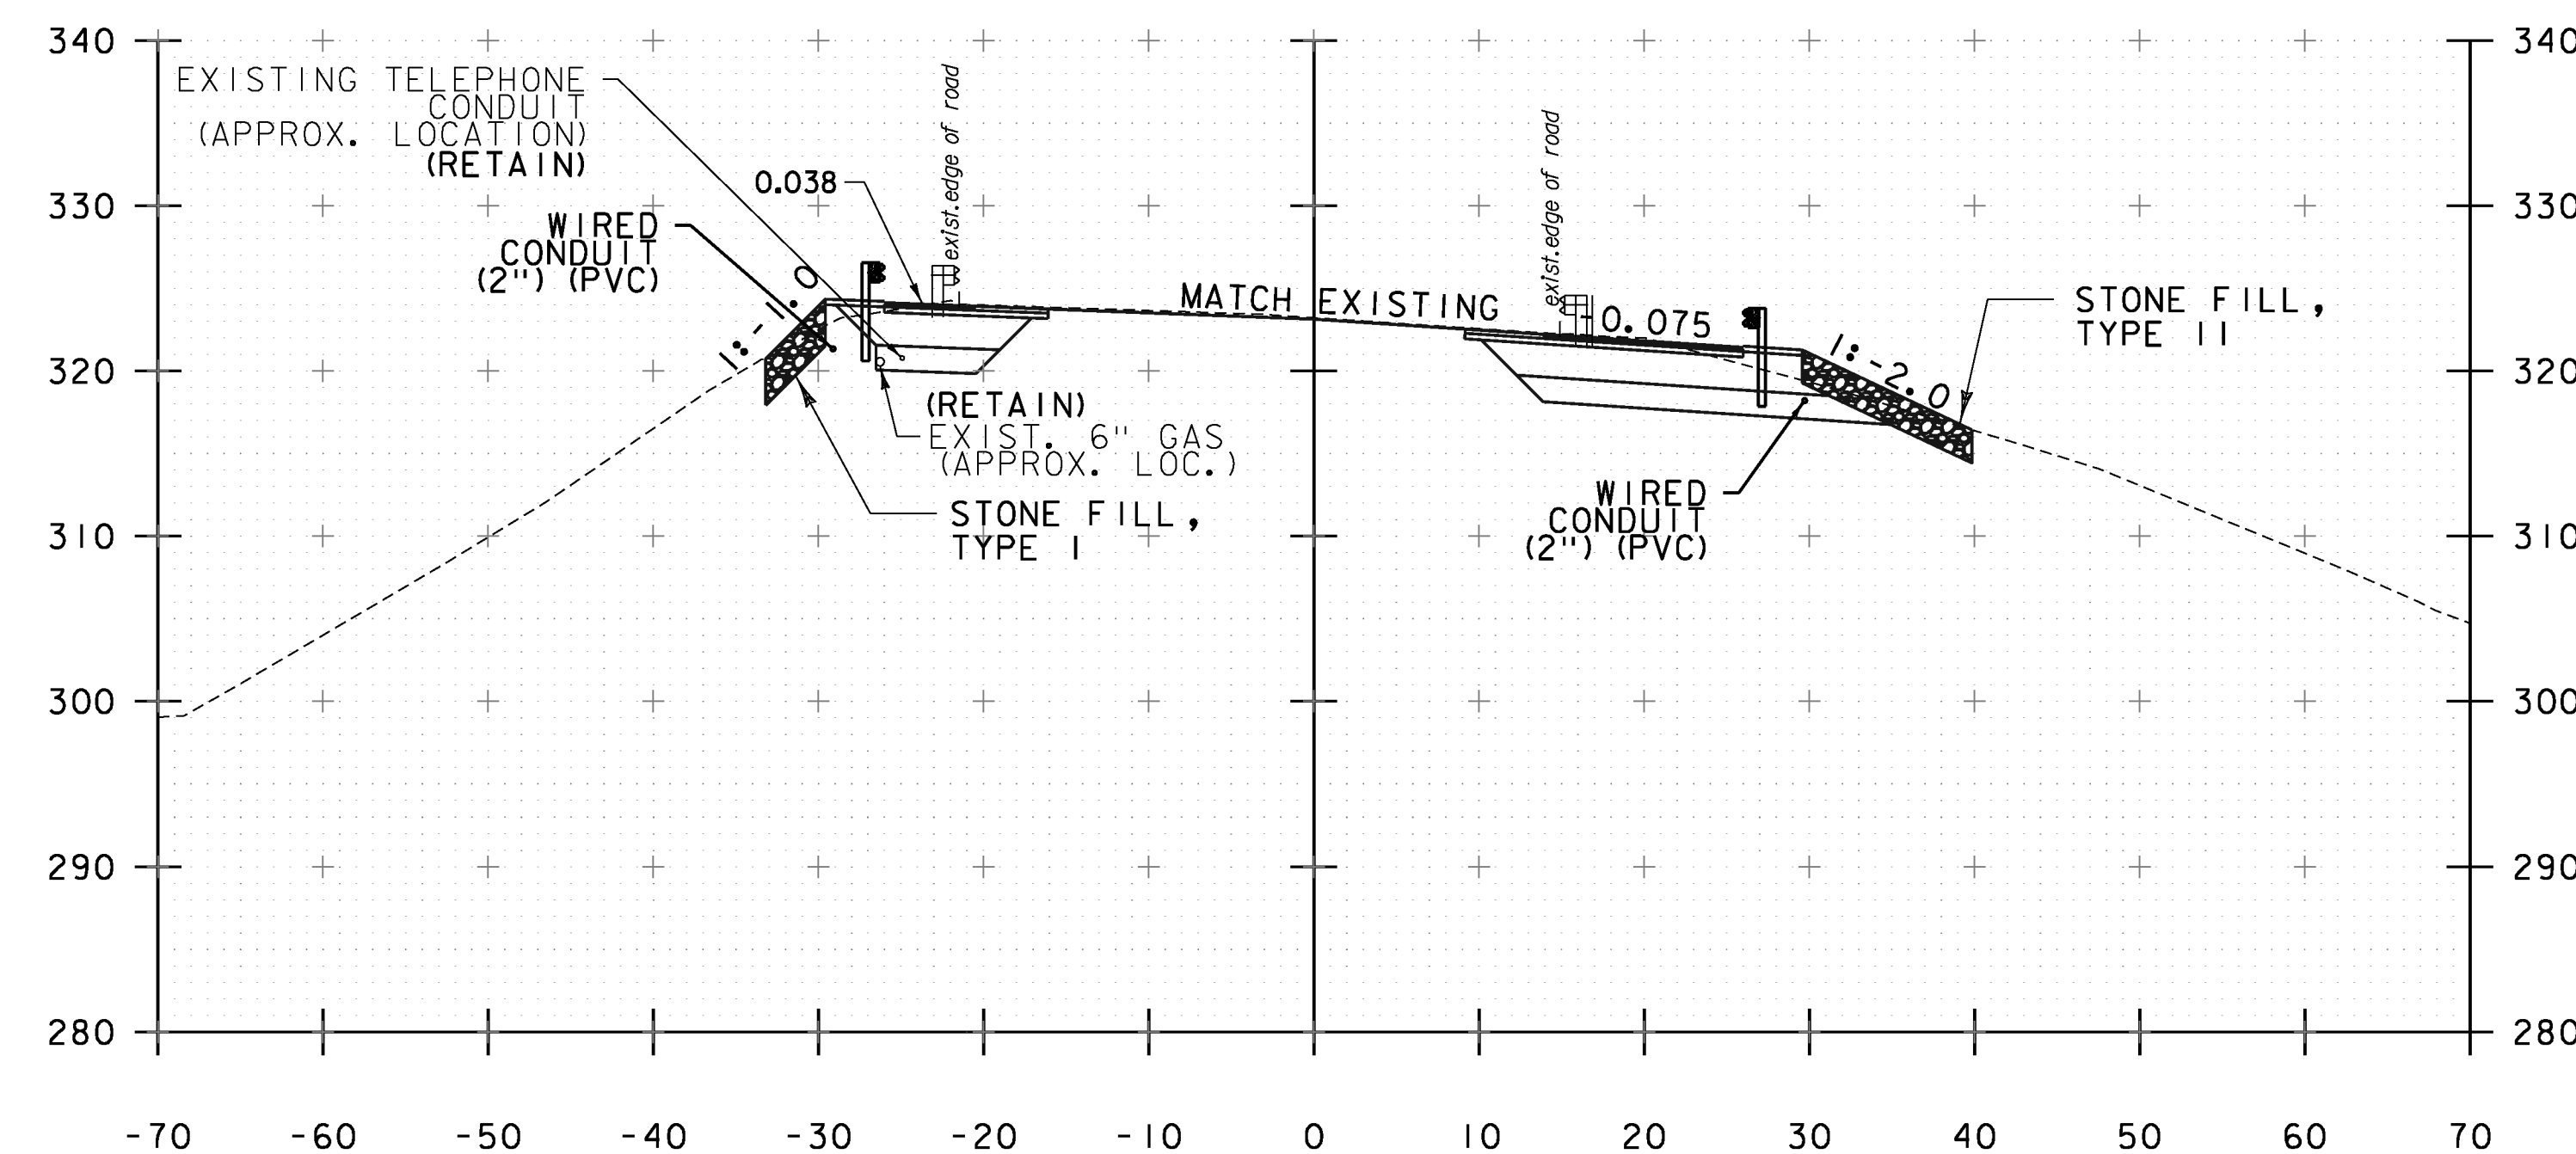

8+00

NOTE:
REFER TO SHEET 90 OF 133 FOR CROSS SECTIONS AT THE PROPOSED MAST ARM POLES.

STA. 7+00 TO STA. 8+03.80

PROJECT NAME:	RICHMOND
PROJECT NUMBER:	STP 0284 (17)
FILE NAME:	z97c186xsl.dgn
PROJECT LEADER:	ERIK ATKINS
DESIGNED BY:	T. BIGELOW
US ROUTE 2 CROSS SECTIONS SHEET 2	
PLOT DATE:	4/29/2013
DRAWN BY:	S. FORTIER
CHECKED BY:	E. ATKINS
SHEET	82 OF 133